


## U. S. PUBLIC LAND SURVEY MONUMENT RECORD

SECTION 18 T 17 N, R 7 W, TOWN OF ONALASKA

LA CROSSE COUNTY

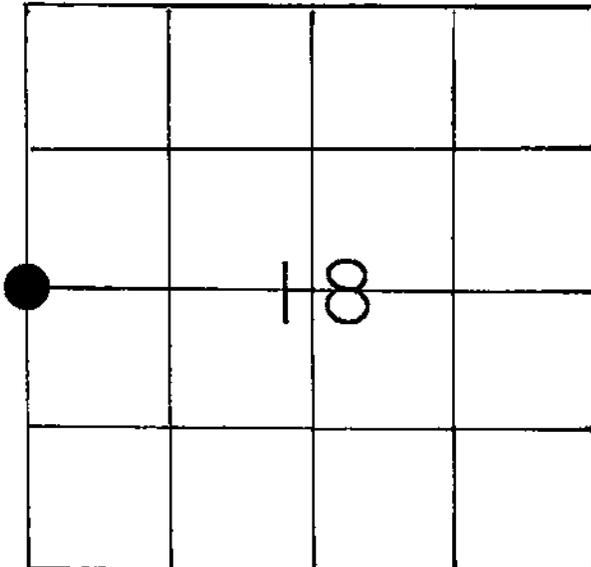

## LOCATION OF LANDMARK

Crew: WILLIAM C. JUNG  
 RON HAYDEN  
 PETER F. FOLLANSBEE

Date: 6/29/1988

Describe any record evidence, monument evidence, testimonial evidence or any other material evidence you considered and whether the monument was found or restored through acceptance of an obliterated evidence location.

Ron Hayden and I found charred wood remains and soil discoloration where we believe the old corner location was. At a distance and bearing of  $N43^{\circ}W_{+}$ ,  $54'_{\pm}$  (original =  $N43^{\circ}W$ ,  $52.8'$ ) from the charred wood and soil discoloration, we found the rotted remains of a double or possible\*white oak group. This could explain why no size was given in the original notes. (Note: Hofmeister and Hayden also found charred wood at the NW of Section 18 years ago.) We excavated a  $6'N-S \times 4'E-W$  hole to a depth of  $24''$  North of the fence corner but found no further evidence. Convinced that we had found evidence of the old corner location, we set a brass capped Lunde marker

Describe or show any material discrepancy between the location of the restored corner and that of the corner previously restored or reestablished.

(continued)

at the location of the charred wood and soil discoloration. This corner falls  $2.1'$  North of the fence corner. The 1932 Corps of Engineers notes call the fence corner a "probable corner". Mr. Knutson says the fence corner has never changed in the over 40 years that he has lived on the nearby farm. The D.O.T. R/W map of the nearby proposed highway calls for the fence corner as the corner. The corner is not at the fence corner, but obviously the fence corner is close evidence of the approximate original location. Gary Watts in a previous survey calls for a pipe that would fall about  $7'$  North and  $7'$  West of the final corner. I do not agree with this location nor does Hayden. Watts calls for a pipe at this corner but we did not find one.

I buried a whiskey bottle with a blank shell in it next to the Lunde. We also drove a fence post South of the monument. There is a  $21''$  stump,  $N80^{\circ}E$ ,  $19.8'$  from the corner, and a  $24''$  oak stump,  $N72^{\circ}W$ ,  $19'$  from the corner.

We also found an old downed fence to the North.

\*triple

## WISCONSIN COORDINATE SYSTEM

North

East

Theta Angle

Horiz. Order

Vert. Order

## TYPE OF LANDMARK

SET BRASS CAP LUNDE MARKER


BEARINGS ARE REFERENCED TO

RECORD OF DURABLE WITNESS MONUMENTS

NO	DESCRIPTION	MAGNETIC	
		BEARING	DISTANCE
1	Set P.K. Nail in 14" Bur Oak (Dbl. Blz)	N 87° E	74.43 Ft.
2	Set P.K. Nail in 9" Jack Oak (Dbl. Blz)	S 54° W	40.70 Ft.
3	Set P.K. Nail in 10" Jack Oak (Dbl. Blz)	S 70° W	39.12 Ft.
4	Set P.K. Nail in 7" Jack Oak (Dbl. Blz)	N 83° W	39.86 Ft.
5	Dug 2' x 2' Pit (2' Depth)	N 10° W	10.60 Ft.

(Note: all P.K. Nails set in South side of trees)

(Note: drove old iron fence post South of monument)

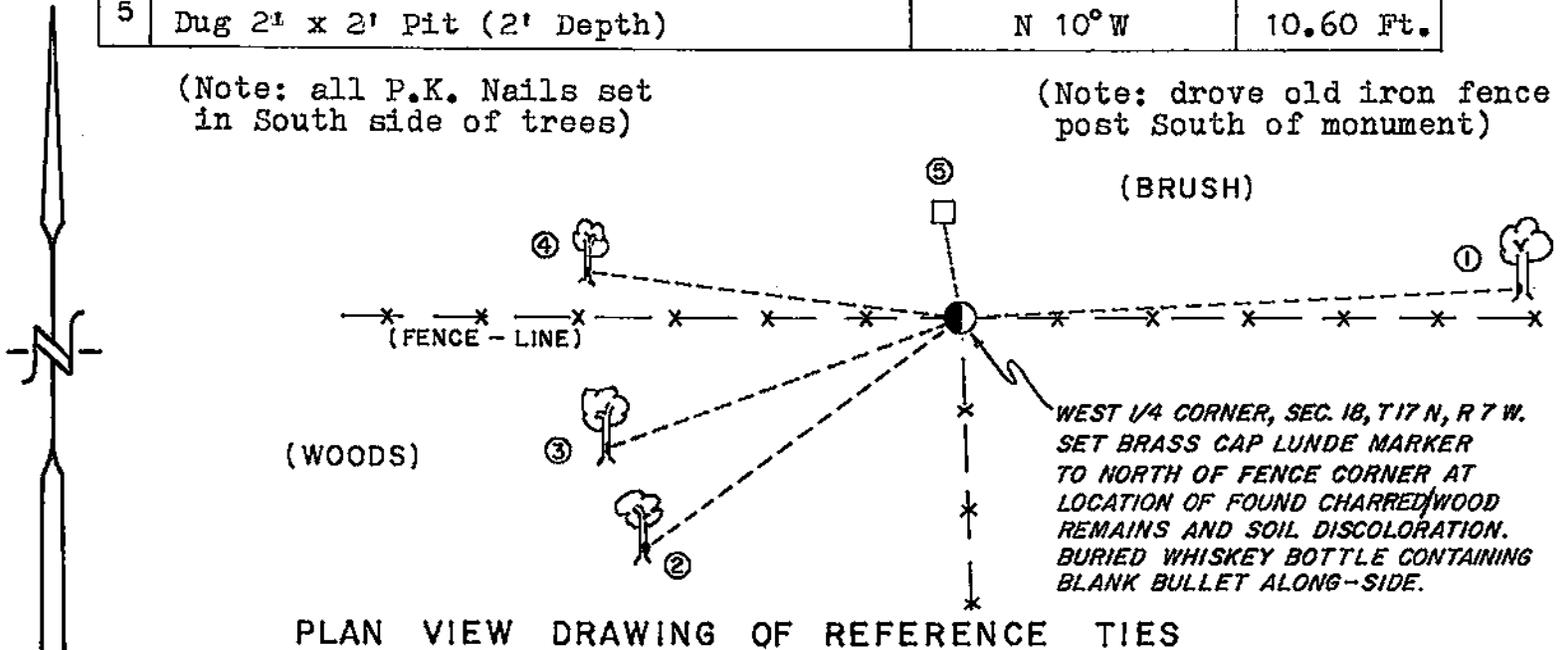


PLAN VIEW DRAWING OF REFERENCE TIES

MAP SHOWING DISTANCE AND DIRECTION TO OTHER PUBLIC LAND SURVEY CORNERS USED FOR REESTABLISHING THE CORNER

No measurements were made by me at this time, although previous measurements made by others confirm the corner location.

I, William C. Jung, Deputy County Surveyor.  
 HEREBY CERTIFY THAT THE CORNER LOCATION SHOWN ON THIS RECORD  
 WAS DETERMINED BY ME OR UNDER MY DIRECTION AND CONTROL AND  
 THAT THIS U. S. PUBLIC LAND SURVEY MONUMENT RECORD IS CORRECT  
 AND COMPLETE TO THE BEST OF MY KNOWLEDGE AND BELIEF.

William C. Jung Signature      August 22, 1988 Date

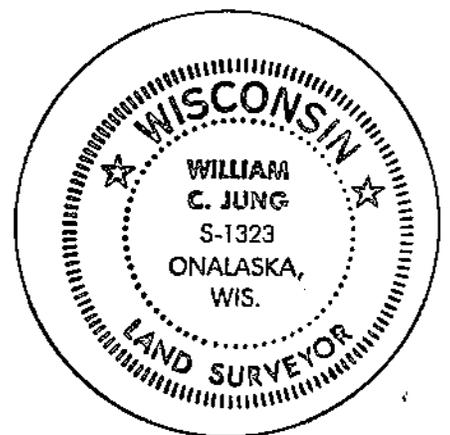

Seal