


21708240000

U. S. PUBLIC LAND SURVEY MONUMENT RECORD

SECTION 19 T 17 N, R 7 W, TOWN OF Onalaska

LA CROSSE COUNTY

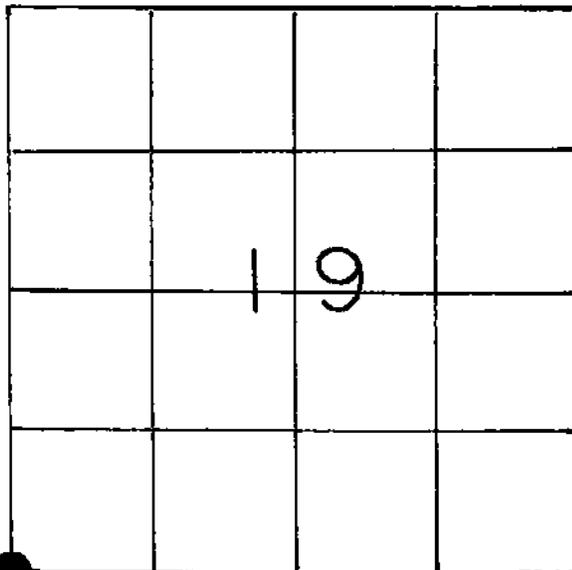

LOCATION OF LANDMARK

Crew: William C. Jung
Peter Follansbee

Date: 8/29/88 , 6/26/91

Crew: William C. Jung
Peter F. Follansbee

Date: 7/18/94 , 11/17/94

Describe any record evidence, monument evidence, testimonial evidence or any other material evidence you considered and whether the monument was found or restored through acceptance of an obliterated evidence location.

I found a railroad spike at the corner that had been used as the corner in previous surveys. I accepted this point as the best available evidence of the original government corner position. I removed the railroad spike and replaced it with a brass capped Lunde marker. Phil Scholze set the railroad spike for Clayton Connell in 1977.

9/12/91 - Pete removed the Lunde on 5/28/91 because of highway paving. We reset the corner on 6/26/91 and checked the ties.

The Lunde was paved over so we set a P.K. nail and cap over the Lunde on 11/17/94.

Describe or show any material discrepancy between the location of the restored corner and that of the corner previously restored or reestablished.

None known.

WISCONSIN COORDINATE SYSTEM

North

East

Theta Angle

Horiz. Order

Vert. Order

TYPE OF LANDMARK P.K. nail&cap over
Brass capped Lunde marker


BEARINGS ARE REFERENCED TO

Assumed

RECORD OF DURABLE WITNESS MONUMENTS

NO	DESCRIPTION	BEARING	DISTANCE
1	Set a P.K. nail in the track centerline	-----	648.18
2	Set and buried a 1" iron pipe	North \pm	17.11
3	" " " " " "	South \pm	13.03
4	Bolt	-----	25.92


(not to scale)

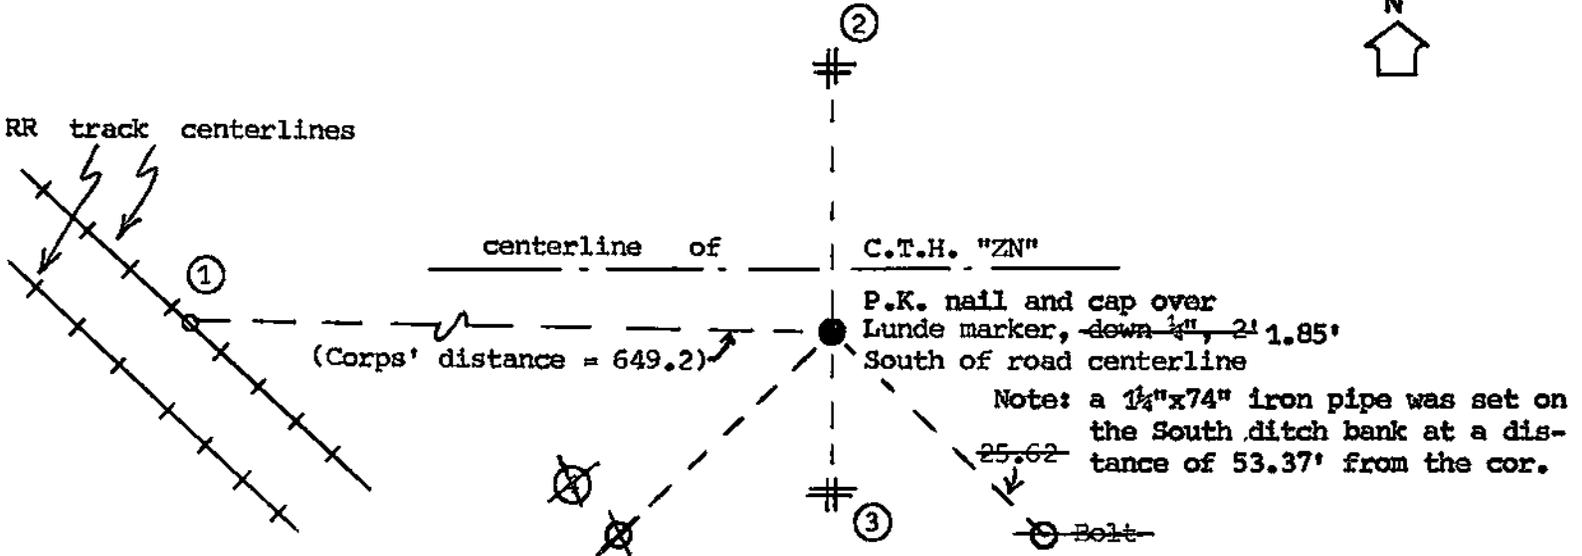

PLAN VIEW DRAWING OF REFERENCE TIES

MAP SHOWING DISTANCE AND DIRECTION TO OTHER PUBLIC LAND SURVEY CORNERS USED FOR REESTABLISHING THE CORNER

(not to scale)

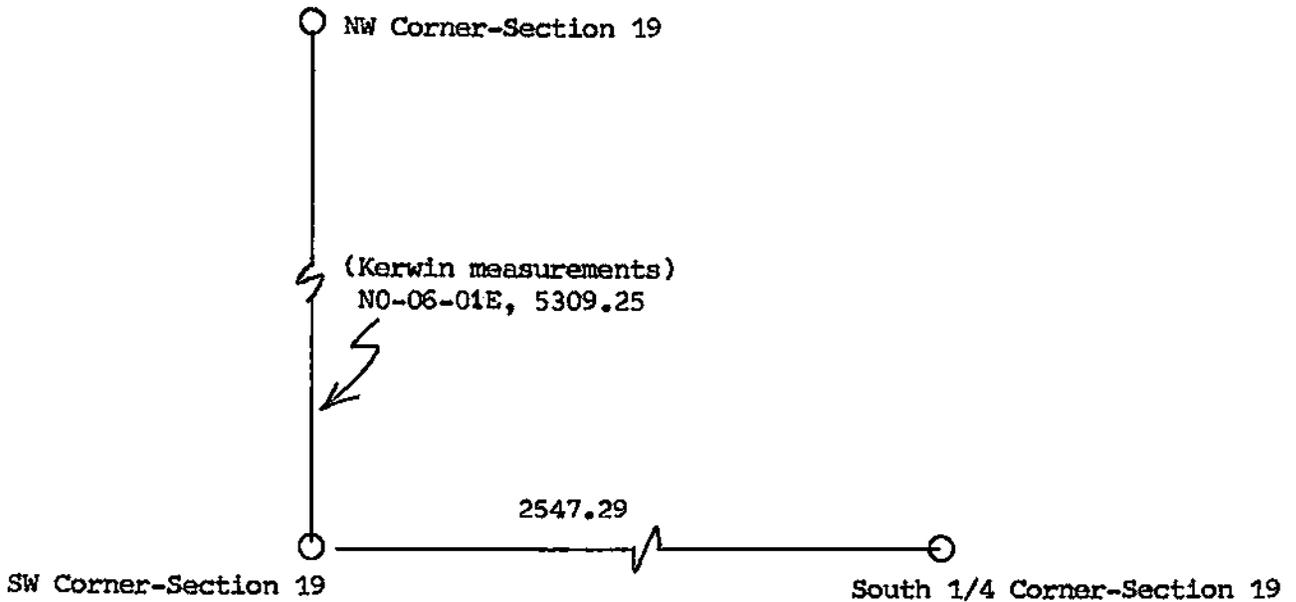


I, William C. Jung, Deputy County Surveyor,
 HEREBY CERTIFY THAT THE CORNER LOCATION SHOWN ON THIS RECORD
 WAS DETERMINED BY ME OR UNDER MY DIRECTION AND CONTROL AND
 THAT THIS U. S. PUBLIC LAND SURVEY MONUMENT RECORD IS CORRECT
 AND COMPLETE TO THE BEST OF MY KNOWLEDGE AND BELIEF.

William C. Jung
 Signature

1/17/89
 Date

Revised: 9/12/91 *wef*
 " 3/8/95 *wef*

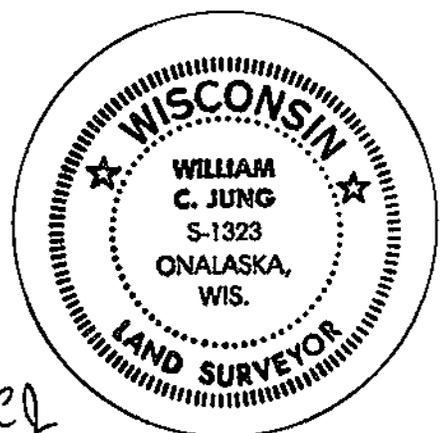

Seal