


21807310020

## U. S. PUBLIC LAND SURVEY MONUMENT RECORD

SECTION 6 T 17 N, R 7 W, TOWN OF HOLLAND

LA CROSSE COUNTY

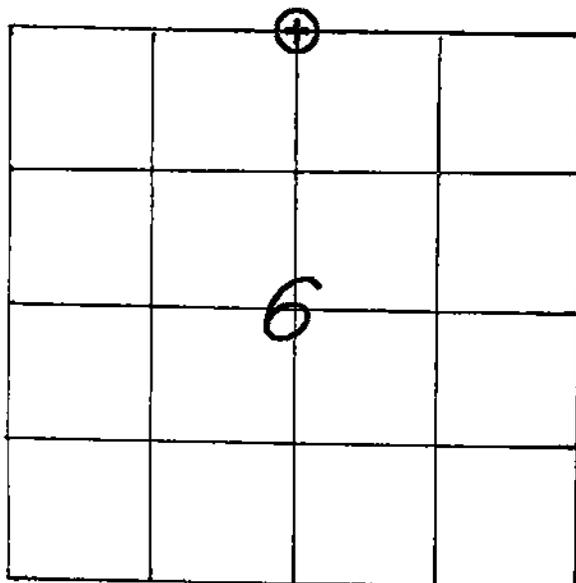

LOCATION OF LANDMARK

CREW: WILLIAM C. JUNG  
 PETER F. FOLLANSBEE  
 DATE: 7/23/2004

WISCONSIN COORDINATE SYSTEM	
North	725,844.428
East	1,636,741.796
Theta Angle	
Horiz. Order	
Vert. Order	
DATUM:	1983 ('91)
TYPE OF LANDMARK	
3/4" x 30" IRON BAR WITH AN ALUMINUM CAP.	
BEARINGS ARE REFERENCED TO	
GRID NORTH AS PER SECTION DATA.	

Describe any record evidence, monument evidence, testimonial evidence or any other material evidence you considered and whether the monument was found or restored through acceptance of an obliterated evidence location.

I accepted the old occupied corner as the best available evidence of the original government corner position and monumented it with an iron bar and cap. This fits the calculated single proportionate position within 1.7 feet East-West and 5.9 feet North-South.

Describe or show any material discrepancy between the location of the restored corner and that of the corner previously restored or reestablished.

**NONE KNOWN.**

