


21807320020

U. S. PUBLIC LAND SURVEY MONUMENT RECORD

SECTION 5 T 17 N, R 7 W, TOWN OF HOLLAND

LA CROSSE COUNTY

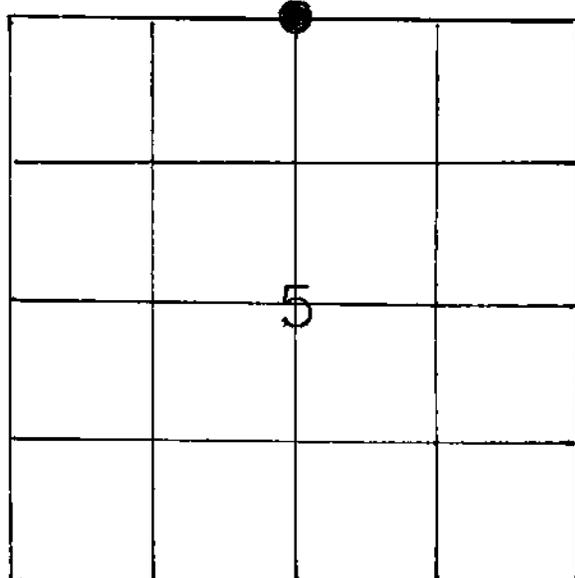

LOCATION OF LANDMARK

CREW: PHILIP SCHOLZE
TREVOR J. SCHOLZE

DATE: 8-29-02

Describe any record evidence, monument evidence, testimonial evidence or any other material evidence you considered and whether the monument was found or restored through acceptance of an obliterated evidence location.

I found the North 1/4 corner Iron Pipe monument set by RLS Berg on a survey for the Dean Mades property, dated March 1982. The Monument was set an equal distance from the Monuments at the NE and NW corners of Section 5. I varified the location of the Corner subdividing Section 5 for a survey of the Carl Pedretti property dated 4-20-90. I accepted the corner as set by Berg and placed a reference pipe at a fence corner 5.48 SW of the corner. It appears the reference pipe I set has been used on other surveys in Section 5 as the North 1/4 corner.

Describe or show any material discrepancy between the location of the restored corner and that of the corner previously restored or reestablished.

WISCONSIN COORDINATE SYSTEM

North

East

Theta Angle

Horiz. Order

Vert. Order


TYPE OF LANDMARK | 1/2" IRON
PIPE 0.7' BELOW GRADEBEARINGS ARE REFERENCED TO
TRUE

RECORD OF DURABLE WITNESS MONUMENTS

NO	DESCRIPTION	BEARING	DISTANCE
1	1" IRON PIPE AT FENCE CORNER	S 31° W	5.48'
2	1" IRON PIPE AT FENCE CORNER	S 31° E	5.50'
3	1" IRON PIPE SET 0.7' BELOW GRADE	NORTH	10.00'
4	P.K. NAIL IN TREATED WOOD FENCE POST	WEST	13.80'

5 P.K. NAIL IN TREATED WOOD FENCE POST EAST 10.85'


NORTH 1/4 CORNER 1 1/2" IRON PIPE 0.7' BELOW GRADE

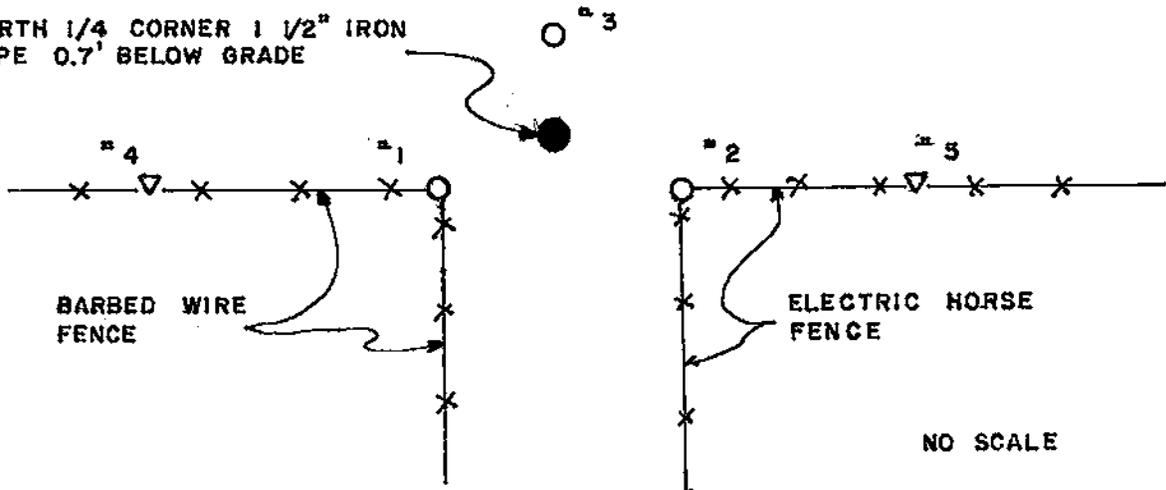

NO SCALE

PLAN VIEW DRAWING OF REFERENCE TIES

MAP SHOWING DISTANCE AND DIRECTION TO OTHER PUBLIC LAND SURVEY CORNERS USED FOR REESTABLISHING THE CORNER

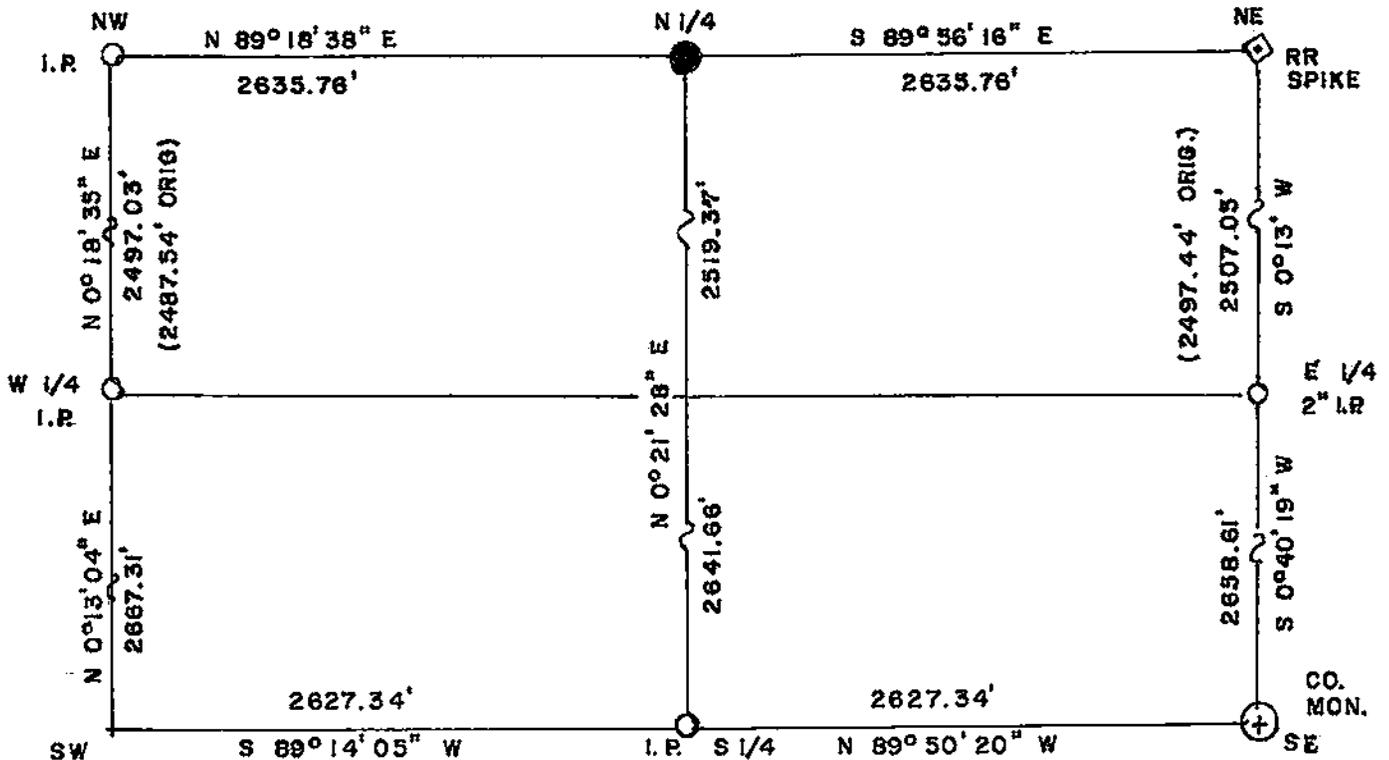

CORNER AS RECORDED ON PLAT OF VILLAGE VIEW ADD. TO THE VILLAGE OF HOLMEN

I, PHILIP SCHOLZE, RLS
 HEREBY CERTIFY THAT THE CORNER LOCATION SHOWN ON THIS RECORD
 WAS DETERMINED BY ME OR UNDER MY DIRECTION AND CONTROL AND
 THAT THIS U. S. PUBLIC LAND SURVEY MONUMENT RECORD IS CORRECT
 AND COMPLETE TO THE BEST OF MY KNOWLEDGE AND BELIEF.

Philip Scholze
 Signature

9-14-02
 Date



Seal