


21807330000

U. S. PUBLIC LAND SURVEY MONUMENT RECORD

SECTION 3 T 17 N, R 7 W, TOWN OF Onalaska

LA CROSSE COUNTY

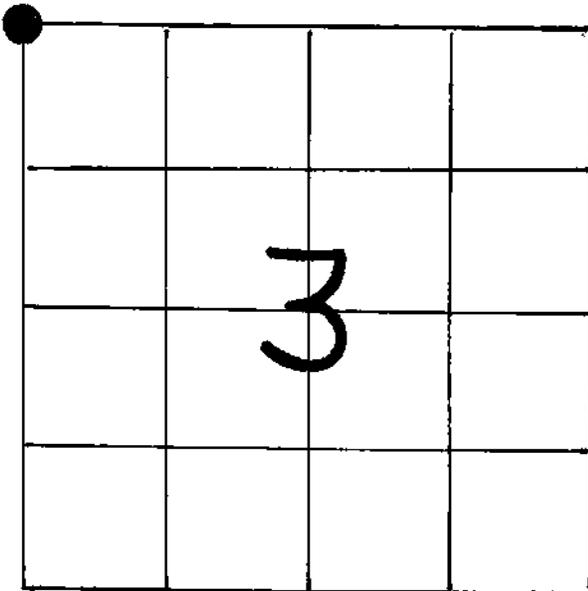

LOCATION OF LANDMARK

Crew: William C. Jung
Peter F. Follansbee

Date: 7/2/91

Describe any record evidence, monument evidence, testimonial evidence or any other material evidence you considered and whether the monument was found or restored through acceptance of an obliterated evidence location.

I set the corner on line with an iron pipe at a fence corner at the N1/16NW corner and the North 1/4 Corner, and at a distance from the N1/16NW equal to the distance between the N1/16NW and North 1/4 Corner. I set an iron pipe at the corner. It falls in a small wetland area.

Describe or show any material discrepancy between the location of the restored corner and that of the corner previously restored or reestablished.

None known.

WISCONSIN COORDINATE SYSTEM

North

East

Theta Angle

Horiz. Order

Vert. Order

TYPE OF LANDMARK

2"x30" iron pipe in small wetland area


BEARINGS ARE REFERENCED TO

Assumed

RECORD OF DURABLE WITNESS MONUMENTS
Magnetic


NO	DESCRIPTION	BEARING	DISTANCE
1	P.K. nail in an unblazed 9" willow	N61°E	36.12
2	Southeast corner of house	N71°W	104.22
3	P.K. nail in large unblazed multiple maple	S73°W	129.52
4	To the Southeast corner of a phone box, at the	S52°W	102.53

bottom

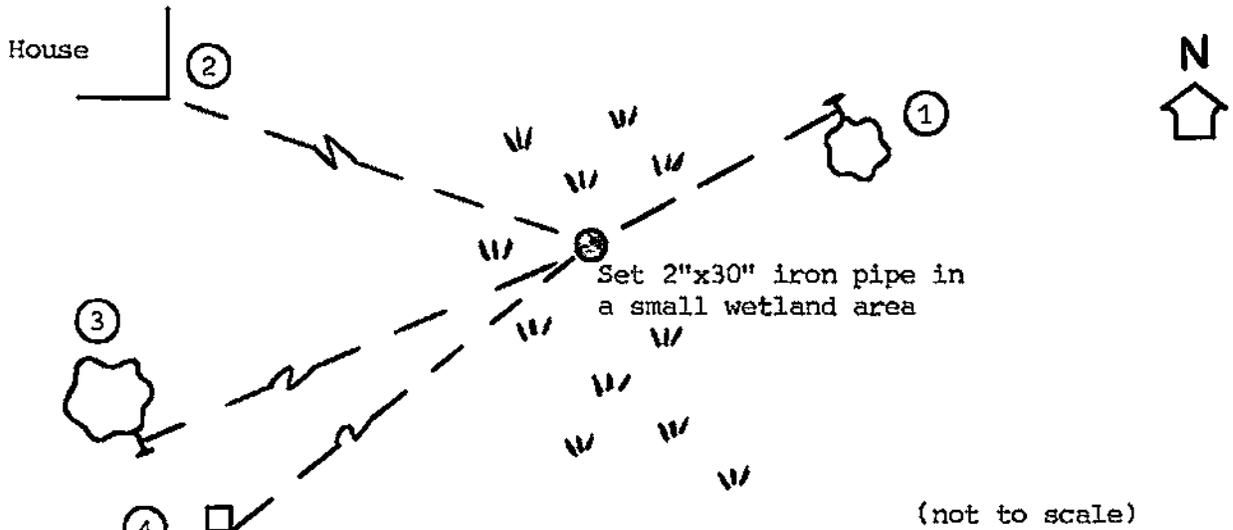


PLAN VIEW DRAWING OF REFERENCE TIES

MAP SHOWING DISTANCE AND DIRECTION TO OTHER PUBLIC LAND SURVEY CORNERS USED FOR REESTABLISHING THE CORNER

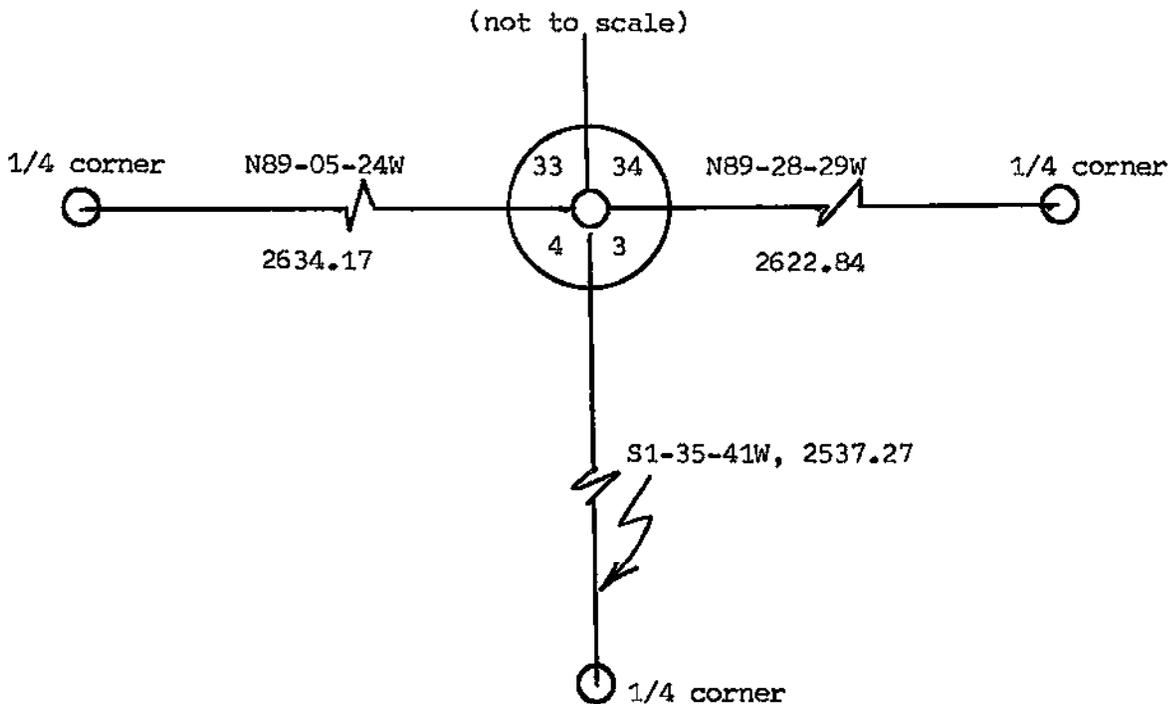

I, William C. Jung, Deputy County Surveyor,
HEREBY CERTIFY THAT THE CORNER LOCATION SHOWN ON THIS RECORD
WAS DETERMINED BY ME OR UNDER MY DIRECTION AND CONTROL AND
THAT THIS U. S. PUBLIC LAND SURVEY MONUMENT RECORD IS CORRECT
AND COMPLETE TO THE BEST OF MY KNOWLEDGE AND BELIEF.

William C. Jung August 8, 1991
Signature Date

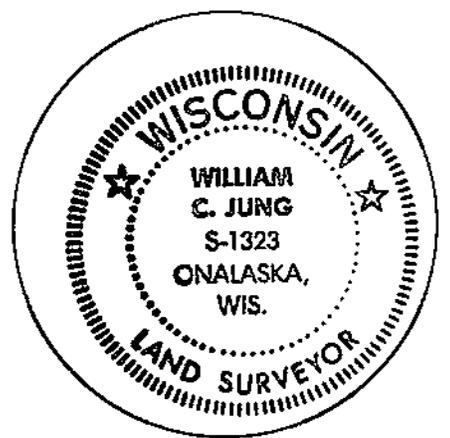

Seal