


21807330020

U. S. PUBLIC LAND SURVEY MONUMENT RECORD

SECTION 4 T 17 N, R 7 W, TOWN OF Onalaska & Holland
 (Town line)
 LA CROSSE COUNTY

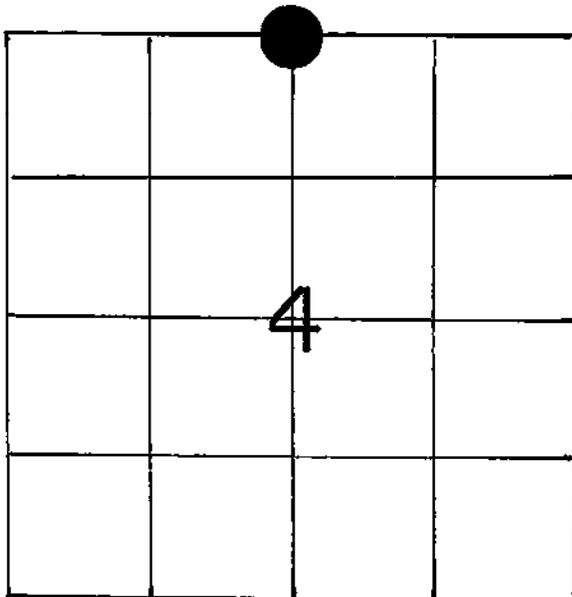

LOCATION OF LANDMARK

WISCONSIN COORDINATE SYSTEM

North

East

Theta Angle

Horiz. Order

Vert. Order

TYPE OF LANDMARK

Existing Berntsen marker

BEARINGS ARE REFERENCED TO

Assumed

Crew: WILLIAM C. JUNG
 PETER F. FOLLANSBEE

Date: 4/02/1991

Describe any record evidence, monument evidence, testimonial evidence or any other material evidence you considered and whether the monument was found or restored through acceptance of an obliterated evidence location.

At an earlier date Ray Pelishek found a stone at the corner and replaced it with a Berntsen marker. We found the Berntsen with the stone buried to the South of it. I buried a brandy bottle with a shell casing to the NW of the Berntsen. We found an original bearing tree to the Northeast. The call fits perfectly.

Describe or show any material discrepancy between the location of the restored corner and that of the corner previously restored or reestablished.


NONE KNOWN

RECORD OF DURABLE WITNESS MONUMENTS

NO	DESCRIPTION	MAGNETIC	
		BEARING	DISTANCE
1	Nail in an unblezed 6" bearing tree	N 03 W	14.62 Ft.
2	Center of 2' Dia. White Oak (unblezed)	N 26 E	94.8 Ft.
3	Set P.K. Nail in SE-side 12" Black Oak	N 37 E	15.60 Ft.
4	Set P.K. Nail in S-side 13" White Oak	N 74 E	16.89 Ft.

NOT TO SCALE

N. 1/4-COR., SEC. 4-17-7.
 FOUND AN EXISTING BERNTSEN MARKER
 WITH A STONE BURIED ON THE SOUTH
 SIDE. BURIED A BRANDY BOTTLE
 CONTAINING A SHELL CASING TO THE
 NORTHWEST OF THE BERNTSEN.

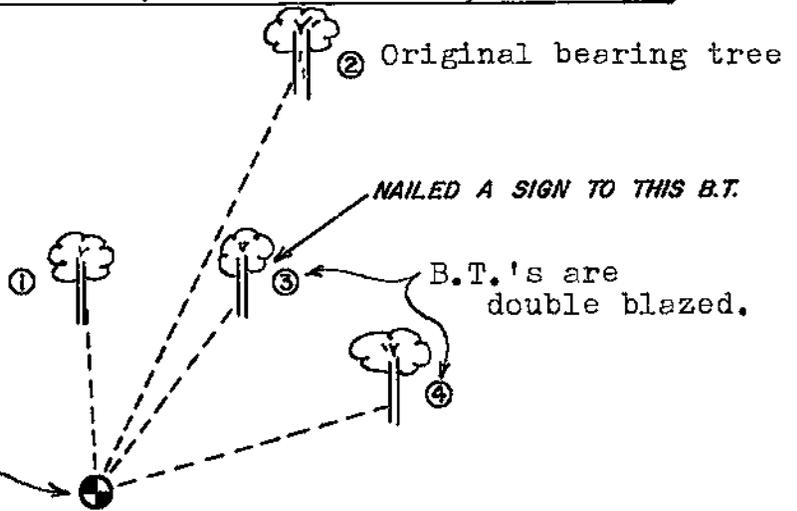

- BRUSHY HILLSIDE -

PLAN VIEW DRAWING OF REFERENCE TIES

MAP SHOWING DISTANCE AND DIRECTION TO OTHER PUBLIC LAND SURVEY CORNERS USED FOR REESTABLISHING THE CORNER

(not to scale)



I, William C. Jung, Deputy County Surveyor
 HEREBY CERTIFY THAT THE CORNER LOCATION SHOWN ON THIS RECORD
 WAS DETERMINED BY ME OR UNDER MY DIRECTION AND CONTROL AND
 THAT THIS U. S. PUBLIC LAND SURVEY MONUMENT RECORD IS CORRECT
 AND COMPLETE TO THE BEST OF MY KNOWLEDGE AND BELIEF.

William C. Jung November 5, 1991
 Signature Date



Seal