


21807340000

## U. S. PUBLIC LAND SURVEY MONUMENT RECORD

SECTION 3 T 17 N, R 7 W, TOWN OF Onalaska

LA CROSSE COUNTY

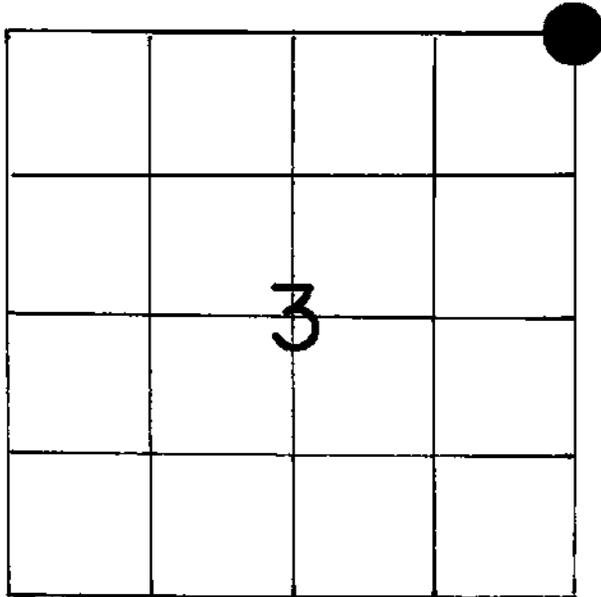

LOCATION OF LANDMARK

## WISCONSIN COORDINATE SYSTEM

North

East

Theta Angle

Horiz. Order

Vert. Order

## TYPE OF LANDMARK

Set brass cap Lunde marker.

## BEARINGS ARE REFERENCED TO

Assumed

Crew: WILLIAM C. JUNG  
PETER F. FOLLANSBEE

Date: 7/03/1991

Describe any record evidence, monument evidence, testimonial evidence or any other material evidence you considered and whether the monument was found or restored through acceptance of an obliterated evidence location.


I set this section corner at a location that best fits the evidence that I found to the North, South, East, and West. The corner was monumented with a brass capped Lunde marker. A whiskey bottle with a shell casing was buried to the South of the Lunde.

Describe or show any material discrepancy between the location of the restored corner and that of the corner previously restored or reestablished.

NONE KNOWN

**RECORD OF DURABLE WITNESS MONUMENTS**  
MAGNETIC


NO	DESCRIPTION	BEARING	DISTANCE
1	Set 5/8" Iron Bar on S.-side of tie post	North $\pm$	31.72'
2	Southwest corner of pole building	N 80 E	Sl= 128.25'
3	Center of flagpole pipe (@ top of base)	S 67 E	Sl= 109'
4	Center of phone box base	S 55 W	46'

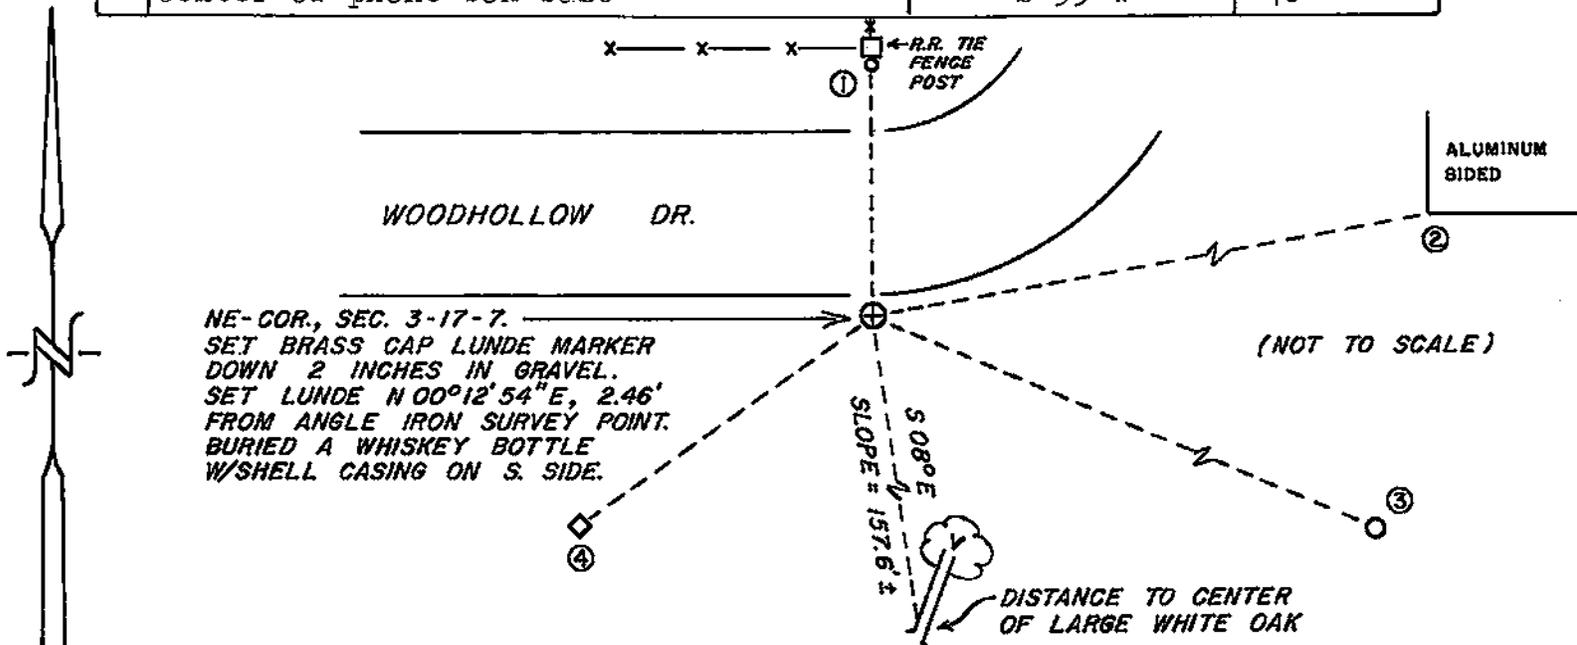

PLAN VIEW DRAWING OF REFERENCE TIES

**MAP SHOWING DISTANCE AND DIRECTION TO OTHER PUBLIC LAND SURVEY CORNERS USED FOR REESTABLISHING THE CORNER**


(not to scale)

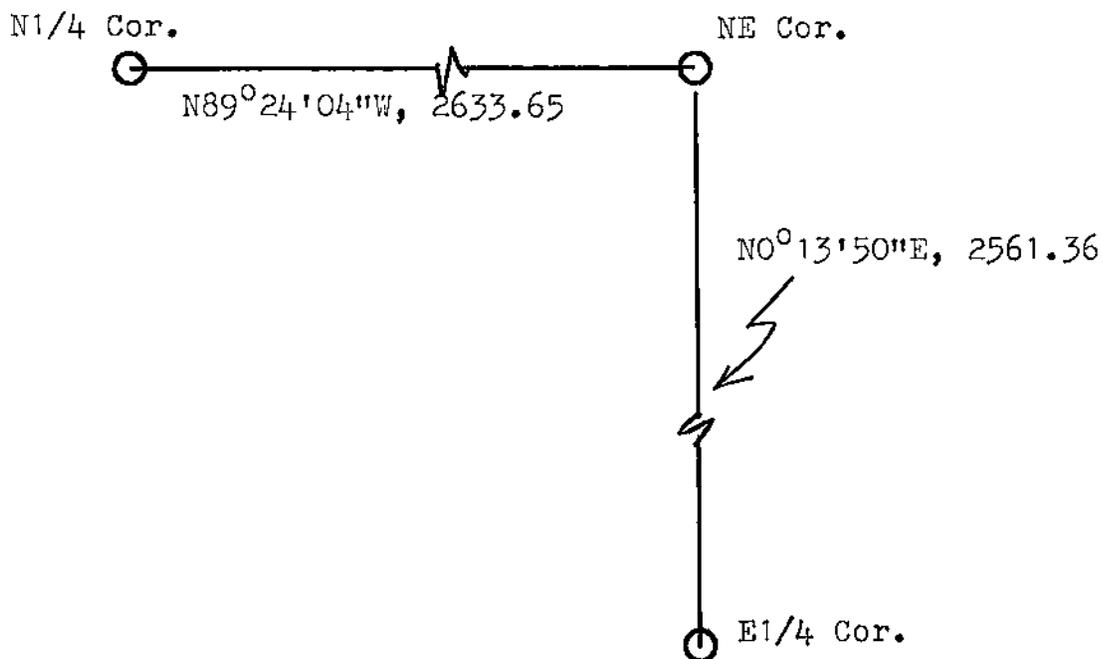

I, William C. Jung, Deputy County Surveyor  
HEREBY CERTIFY THAT THE CORNER LOCATION SHOWN ON THIS RECORD WAS DETERMINED BY ME OR UNDER MY DIRECTION AND CONTROL AND THAT THIS U. S. PUBLIC LAND SURVEY MONUMENT RECORD IS CORRECT AND COMPLETE TO THE BEST OF MY KNOWLEDGE AND BELIEF.

William C. Jung  
Signature

November 5, 1991  
Date

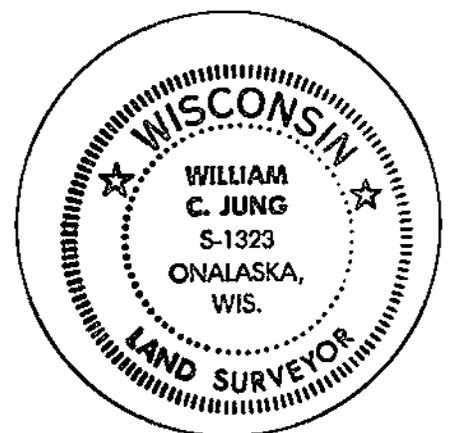

Seal