


21807340020

## U. S. PUBLIC LAND SURVEY MONUMENT RECORD

SECTION 3 T 17 N, R 7 W, TOWN OF Onalaska

LA CROSSE COUNTY

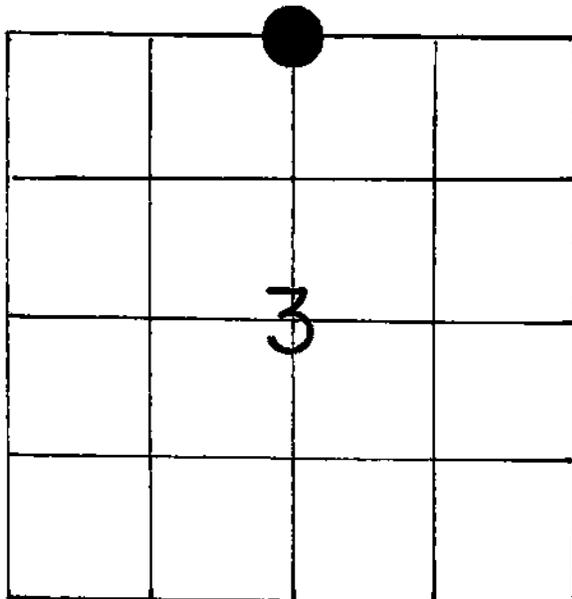

LOCATION OF LANDMARK

WISCONSIN COORDINATE SYSTEM

North

East

Theta Angle

Horiz. Order

Vert. Order

TYPE OF LANDMARK

Set brass cap Lunde marker

BEARINGS ARE REFERENCED TO

Assumed

Crew: WILLIAM C. JUNG  
PETER F. FOLLANSBEE

Date: 3/26/1991

Describe any record evidence, monument evidence, testimonial evidence or any other material evidence you considered and whether the monument was found or restored through acceptance of an obliterated evidence location.


I found an iron pipe at the fence corner which had been used as the corner in previous surveys. I accepted this point as the best available evidence of the original government survey position. I removed the pipe and replaced it with a brass capped Lunde marker.

Describe or show any material discrepancy between the location of the restored corner and that of the corner previously restored or reestablished.

NONE KNOWN

RECORD OF DURABLE WITNESS MONUMENTS


NO	DESCRIPTION	BEARING	DISTANCE
1	Set 1 1/4" x 30" iron pipe	South ±	16.31 Ft.
2	Set 1 3/4" x 28" iron pipe	West ±	12.34 Ft.
3	Set 1 1/4" x 30" iron pipe	East ±	16.42 Ft.
4			

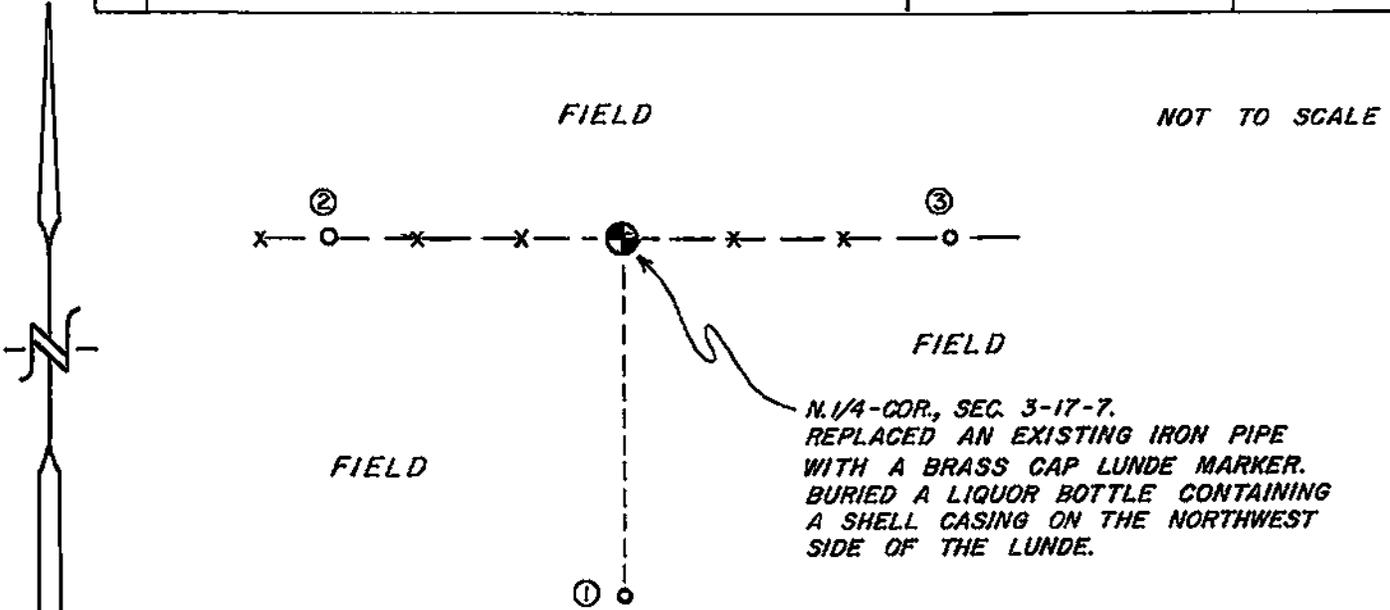

PLAN VIEW DRAWING OF REFERENCE TIES


MAP SHOWING DISTANCE AND DIRECTION TO OTHER PUBLIC LAND SURVEY CORNERS USED FOR REESTABLISHING THE CORNER

(not to scale)

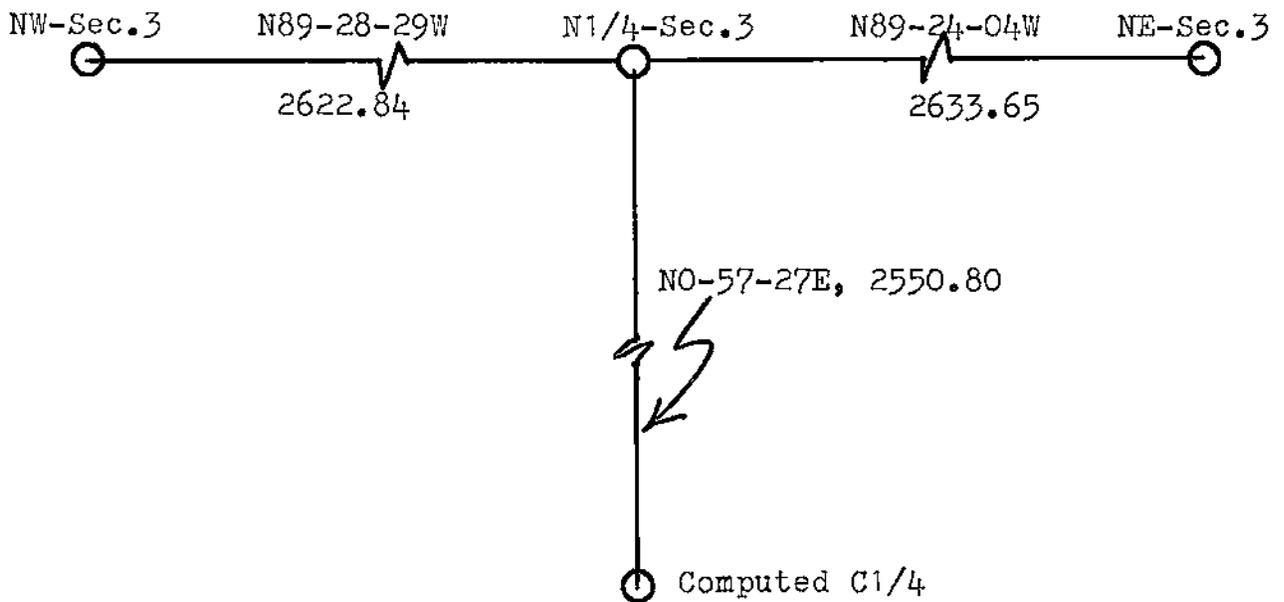

I, William C. Jung, Deputy County Surveyor  
HEREBY CERTIFY THAT THE CORNER LOCATION SHOWN ON THIS RECORD  
WAS DETERMINED BY ME OR UNDER MY DIRECTION AND CONTROL AND  
THAT THIS U. S. PUBLIC LAND SURVEY MONUMENT RECORD IS CORRECT  
AND COMPLETE TO THE BEST OF MY KNOWLEDGE AND BELIEF.

William C. Jung    August 2, 1991  
Signature    Date

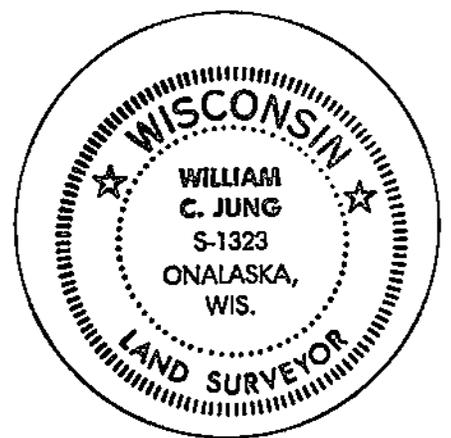

Seal