


21807350020

U. S. PUBLIC LAND SURVEY MONUMENT RECORD

SECTION 2 T 17 N, R 7 W, TOWN OF ONALASKA

LA CROSSE COUNTY

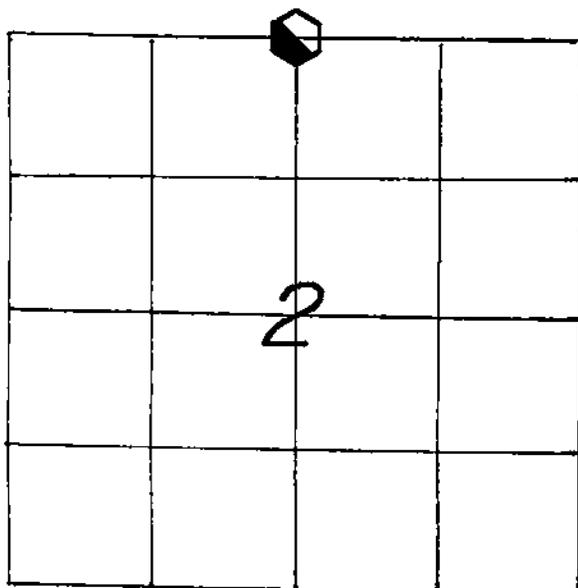

LOCATION OF LANDMARK

CREW: WILLIAM C. JUNG
 PETER F. FOLLANSBEE
 DATE: 8/04/2006

WISCONSIN COORDINATE SYSTEM	
North	725,679.641
East	1,657,783.205
Theta Angle	
Horiz. Order	
Vert. Order	
DATUM:	1983 ('91)
TYPE OF LANDMARK	
30" ALUMINUM BERNTSEN MARKER.	
BEARINGS ARE REFERENCED TO	
GRID NORTH AS PER SECTION DATA.	

Describe any record evidence, monument evidence, testimonial evidence or any other material evidence you considered and whether the monument was found or restored through acceptance of an obliterated evidence location.

Around 40 years ago the current owners to the East and West, Mr. Schmidt and Mr. Buchner, had a disagreement over the North-South line fence at this location. Apparently the Town Board became involved as "fenceviewers". Both landowners told me that a surveyor was hired to "run" this line. K. Don Pederson from LaCrosse Engr. told me that they surveyed a straight line for the Town from occupied fence corners at the 1/16 corners to the North and South of the 1/4 corner. This was by agreement *****

Describe or show any material discrepancy between the location of the restored corner and that of the corner previously restored or reestablished.


NONE KNOWN.

***** between the two landowners. They ran this straight line back in July of 1968. They did not relocate the 1/4 corner or subdivide Sections 2 and 35. To save money, it would appear that the fence was built on a straight line between two fence corners. As this 1/4 corner was not located properly as per Wisconsin law back in 1968, I did not accept the fence. I set the corner "by law", equidistant and on line between the section corners.

RECORD OF DURABLE WITNESS MONUMENTS


MAGNETIC

NO	DESCRIPTION	BEARING	DISTANCE
1	SET A NAIL IN S.E.-SIDE OF A 12" WHITE OAK	N 29° E	68.90 FT.
2	SET A NAIL IN N.-SIDE OF AN 18" WHITE OAK	S 76° E	23.95 FT.
3	SET A NAIL IN W.-SIDE OF A 15" WHITE OAK	S 05° E	21.96 FT.
4	SET A NAIL IN N.W.-SIDE OF A 17" WHITE OAK	S 19° W	7.14 FT.

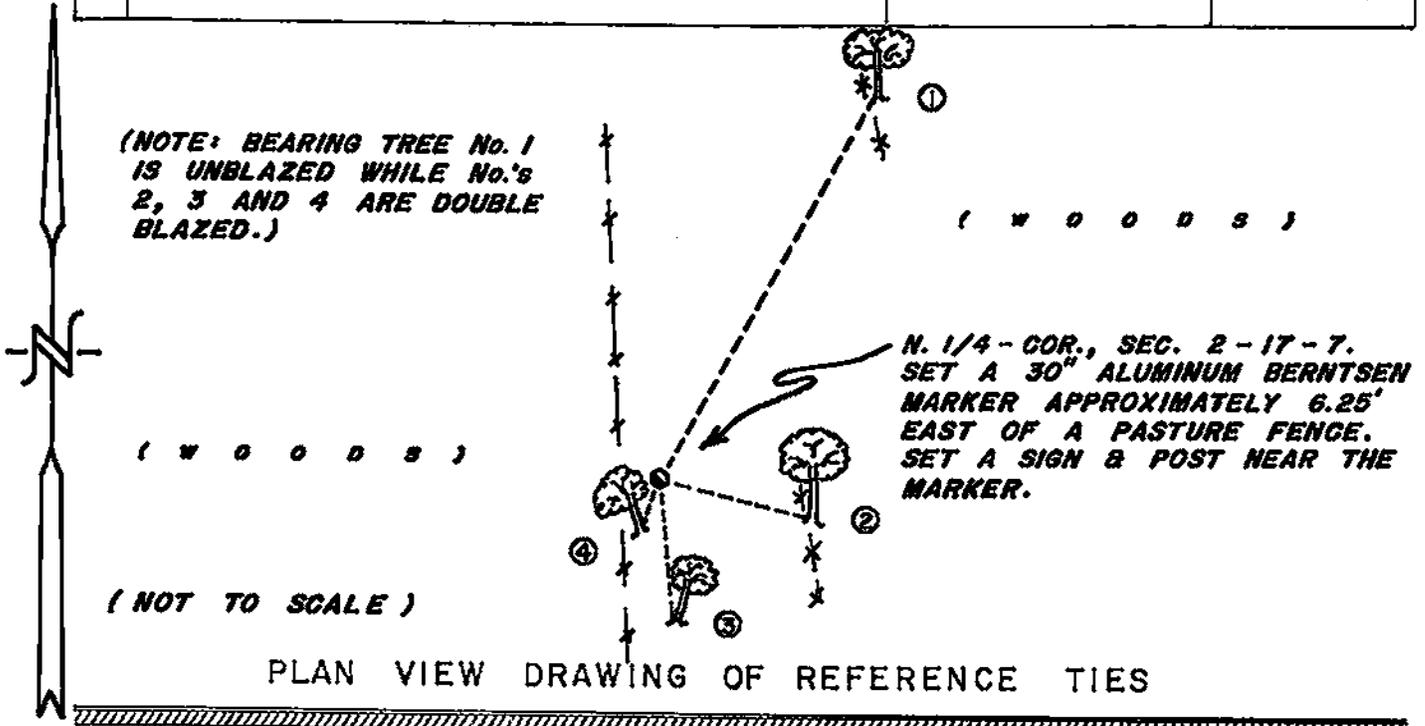

MAP SHOWING DISTANCE AND DIRECTION TO OTHER PUBLIC LAND SURVEY CORNERS USED FOR REESTABLISHING THE CORNER

(GRID BEARINGS AND DISTANCES)
(GRID FACTOR: 0.99994)
(NOT TO SCALE)

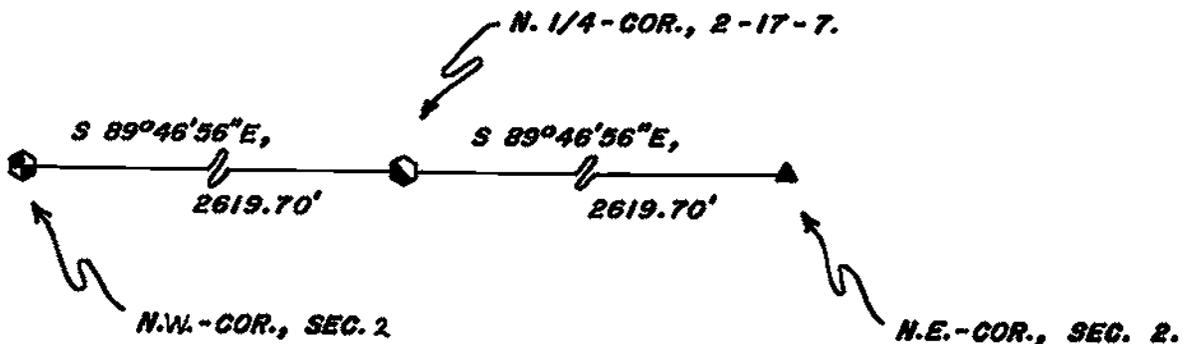

I, WILLIAM G. JUNG, COUNTY SURVEYOR
HEREBY CERTIFY THAT THE CORNER LOCATION SHOWN ON THIS RECORD WAS DETERMINED BY ME OR UNDER MY DIRECTION AND CONTROL AND THAT THIS U. S. PUBLIC LAND SURVEY MONUMENT RECORD IS CORRECT AND COMPLETE TO THE BEST OF MY KNOWLEDGE AND BELIEF.

William C. Jung 9/8/06
Signature Date



Seal