


21807360000

## U. S. PUBLIC LAND SURVEY MONUMENT RECORD

SECTION 1 T 17 N, R 7 W, TOWN OF Onalaska

LA CROSSE COUNTY

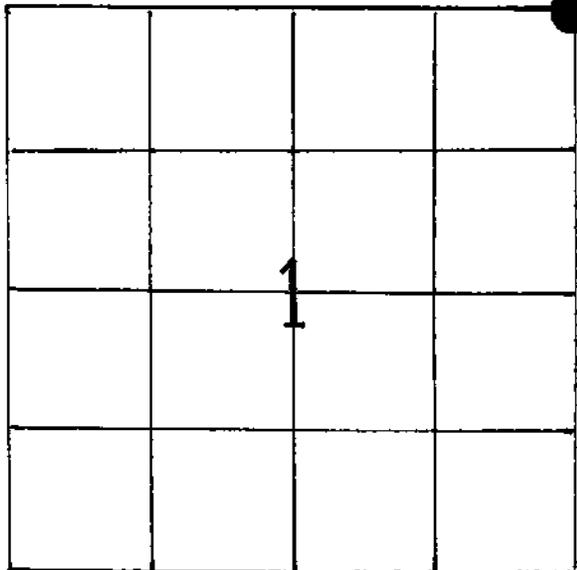

LOCATION OF LANDMARK

Crew: William C. Jung

Date: 5/28/93

Describe any record evidence, monument evidence, testimonial evidence or any other material evidence you considered and whether the monument was found or restored through acceptance of an obliterated evidence location.

I found an iron pipe at the old occupied fence corner. In August of 1977 Phil Smith stated that he set the pipe where he found the remnants of an old rotted square post in the subsoil. Also, to the southwest, is an original bearing tree. I removed the pipe and replaced it with a Lunde marker. I buried a brandy bottle with a shell casing near the marker and also set a post with sign.

Describe or show any material discrepancy between the location of the restored corner and that of the corner previously restored or reestablished.

None known.

## WISCONSIN COORDINATE SYSTEM

North

East

Theta Angle

Horiz. Order

Vert. Order


## TYPE OF LANDMARK

Brass capped Lunde marker

BEARINGS ARE REFERENCED TO

RECORD OF DURABLE WITNESS MONUMENTS  
Magnetic

NO	DESCRIPTION	BEARING	DISTANCE
1	P.K. nail in unblazed 38" burr oak	S56°W	81.96
2	" 44" burr oak	N85°W	57.65
3	Set 1 <sup>3</sup> / <sub>8</sub> " iron pipe	N37°W	10.62
4	P.K. nail in double blazed 14" elm (?)	N24°E	39.16

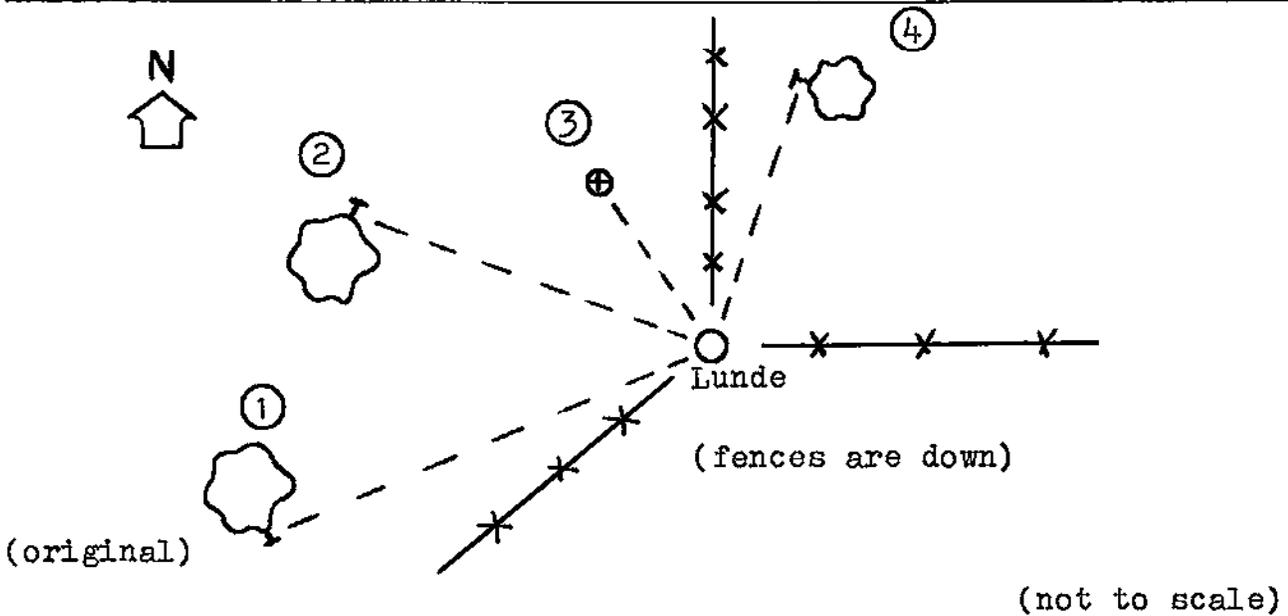


PLAN VIEW DRAWING OF REFERENCE TIES

MAP SHOWING DISTANCE AND DIRECTION TO OTHER PUBLIC LAND SURVEY CORNERS USED FOR REESTABLISHING THE CORNER

No section measurements made by me at this time.

I, William C. Jung, County Surveyor,  
HEREBY CERTIFY THAT THE CORNER LOCATION SHOWN ON THIS RECORD  
WAS DETERMINED BY ME OR UNDER MY DIRECTION AND CONTROL AND  
THAT THIS U. S. PUBLIC LAND SURVEY MONUMENT RECORD IS CORRECT  
AND COMPLETE TO THE BEST OF MY KNOWLEDGE AND BELIEF.

William C. Jung                      6/8/93  
Signature                                      Date

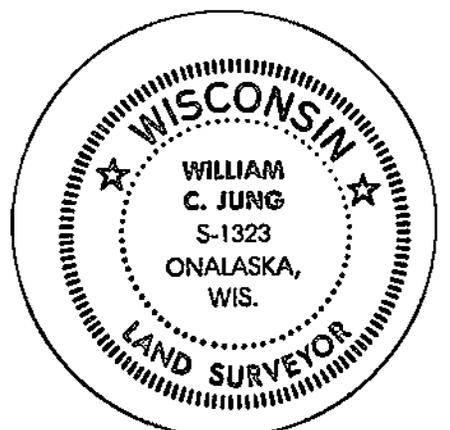

Seal