


21807360020

U. S. PUBLIC LAND SURVEY MONUMENT RECORD

SECTION 1 T 17 N, R 7 W, TOWN OF ONALASKA

LA CROSSE COUNTY

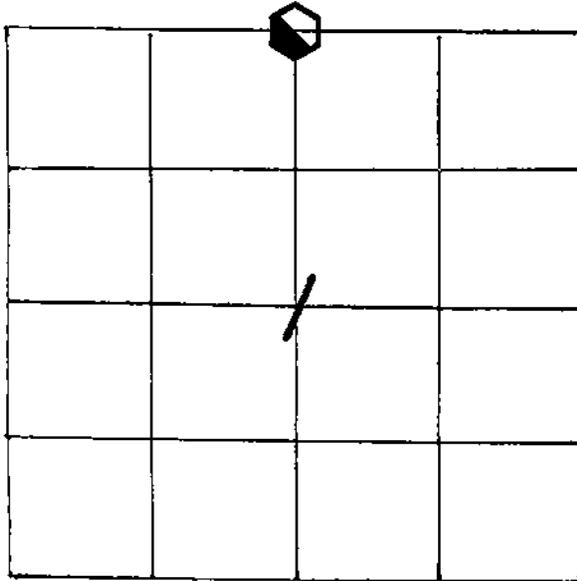

LOCATION OF LANDMARK

CREW: WILLIAM C. JUNG
 PETER F. FOLLANSBEE
 DATE: 9/20/2006

WISCONSIN COORDINATE SYSTEM	
North	725,656.331
East	1,663,042.297
Theta Angle	
Horiz. Order	
Vert. Order	
DATUM:	1983('91)
TYPE OF LANDMARK	
30" ALUMINUM BERNTSEN MARKER.	
BEARINGS ARE REFERENCED TO	
GRID NORTH AS PER SECTION DATA.	

Describe any record evidence, monument evidence, testimonial evidence or any other material evidence you considered and whether the monument was found or restored through acceptance of an obliterated evidence location.

On a bearing of N71°W and at a distance of 90.1 feet I found an old rotted, and partially dead, and downed burr oak. The center of this 18 inch tree was rotted. It is on a steep and rocky sidehill. I believe that this tree was an original bearing tree and as such I set the corner using the original call. At the corner I set a Berntsen marker in a rock pile. It is on top of the West embankment of a logging road.


Describe or show any material discrepancy between the location of the restored corner and that of the corner previously restored or reestablished.

NONE KNOWN.

RECORD OF DURABLE WITNESS MONUMENTS


NO	DESCRIPTION	MAGNETIC	
		BEARING	DISTANCE
1	SET A NAIL IN S.W.-SIDE OF AN 18" OAK	N 25° W	SLOPE= 40.52'
2	SET A NAIL IN S.E.-SIDE OF A 13-1/2" OAK	N 05° E	SLOPE= 53.64'
3	SET A NAIL IN N.W.-SIDE OF A 27" OAK	N 45° E	30.52 FT.
4	SET A NAIL IN W.-SIDE OF A 19-1/2" HICKORY	S 04° W	13.10 FT.

(NOT TO SCALE)

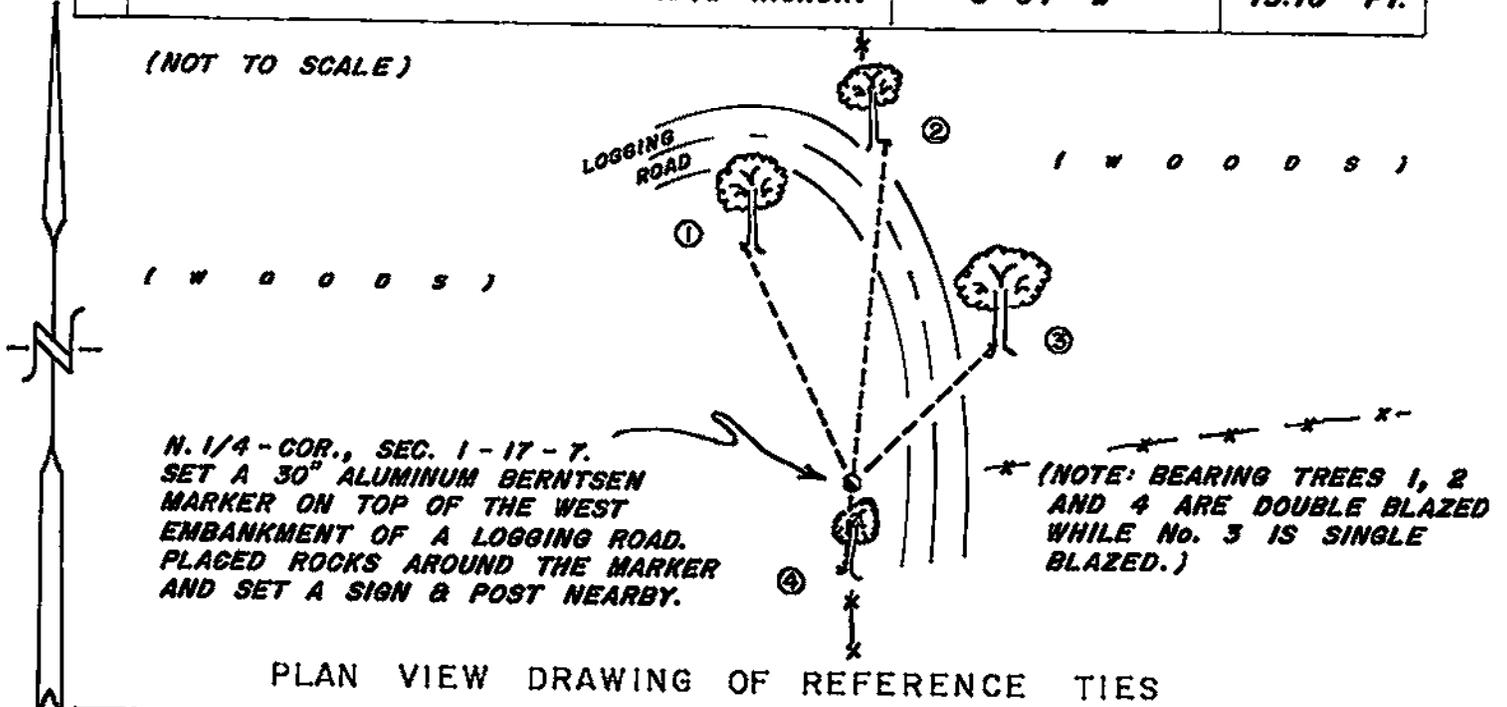

MAP SHOWING DISTANCE AND DIRECTION TO OTHER PUBLIC LAND SURVEY CORNERS USED FOR REESTABLISHING THE CORNER

(GRID BEARINGS AND DISTANCES)
(GRID FACTOR: 0.9999346)
(NOT TO SCALE)

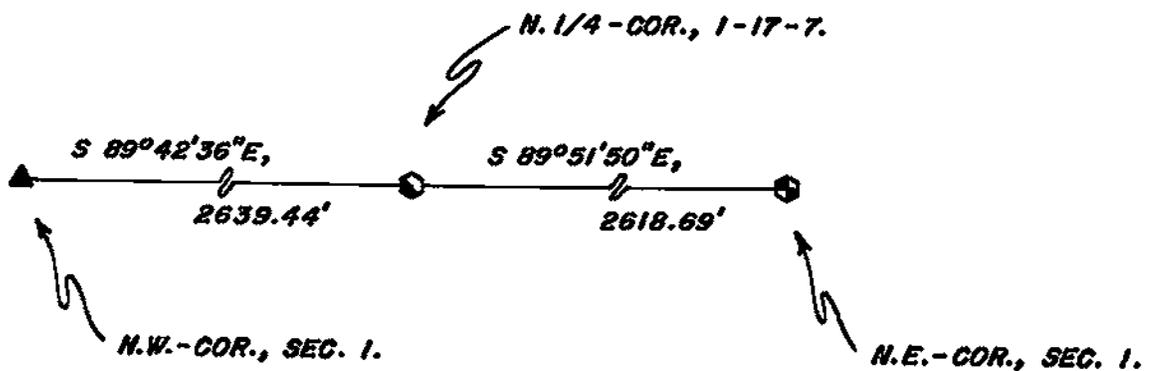

I, WILLIAM G. JUNG, COUNTY SURVEYOR
HEREBY CERTIFY THAT THE CORNER LOCATION SHOWN ON THIS RECORD WAS DETERMINED BY ME OR UNDER MY DIRECTION AND CONTROL AND THAT THIS U. S. PUBLIC LAND SURVEY MONUMENT RECORD IS CORRECT AND COMPLETE TO THE BEST OF MY KNOWLEDGE AND BELIEF.

William C. Jung 11/28/06
Signature Date



Seal