


21708010000

U. S. PUBLIC LAND SURVEY MONUMENT RECORD

SECTION 1 T 17 N, R 8 W, TOWN OF HOLLAND

LA CROSSE COUNTY

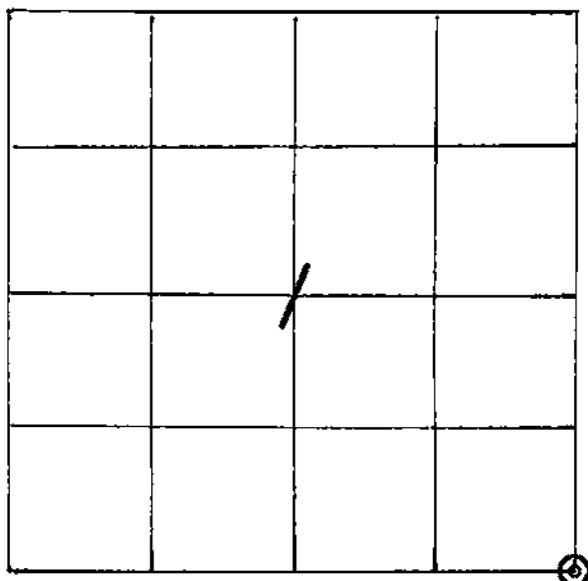

LOCATION OF LANDMARK

CREW: WILLIAM C. JUNG
 PETER F. FOLLANSBEE
 DATE: 11/25/1997

WISCONSIN COORDINATE SYSTEM

North

East

Theta Angle

Horiz. Order

Vert. Order

TYPE OF LANDMARK

P.K. NAIL (TOP IS BROKEN OFF)

BEARINGS ARE REFERENCED TO

Grid

Describe any record evidence, monument evidence, testimonial evidence or any other material evidence you considered and whether the monument was found or restored through acceptance of an obliterated evidence location.


Because of anticipated road construction, I removed our Lunde marker at the corner on 4/22/97. On 11/25/97, I set a P.K. nail at the old corner location.

Describe or show any material discrepancy between the location of the restored corner and that of the corner previously restored or reestablished.

NONE KNOWN.


RECORD OF DURABLE WITNESS MONUMENTS

NO	DESCRIPTION	BEARING	DISTANCE
1	ROUND EDGE OF N.E.-CORNER OF REMOVABLE STORM GRATE	S'WESTERLY ±	43.76 FT.
2	CENTER AT BASE OF LAMP POST FOR RESIDENCE	N'WESTERLY ±	SL. = 85.22'
3	CENTER OF A ROUND IRON PIPE FENCE POST	NORTH ±	41.98 FT.
4	EXIST. P.K. NAIL IN N.W.-SIDE MAPLE IN LAWN (UNBLAZED)	N'EASTERLY ±	66.82 FT.

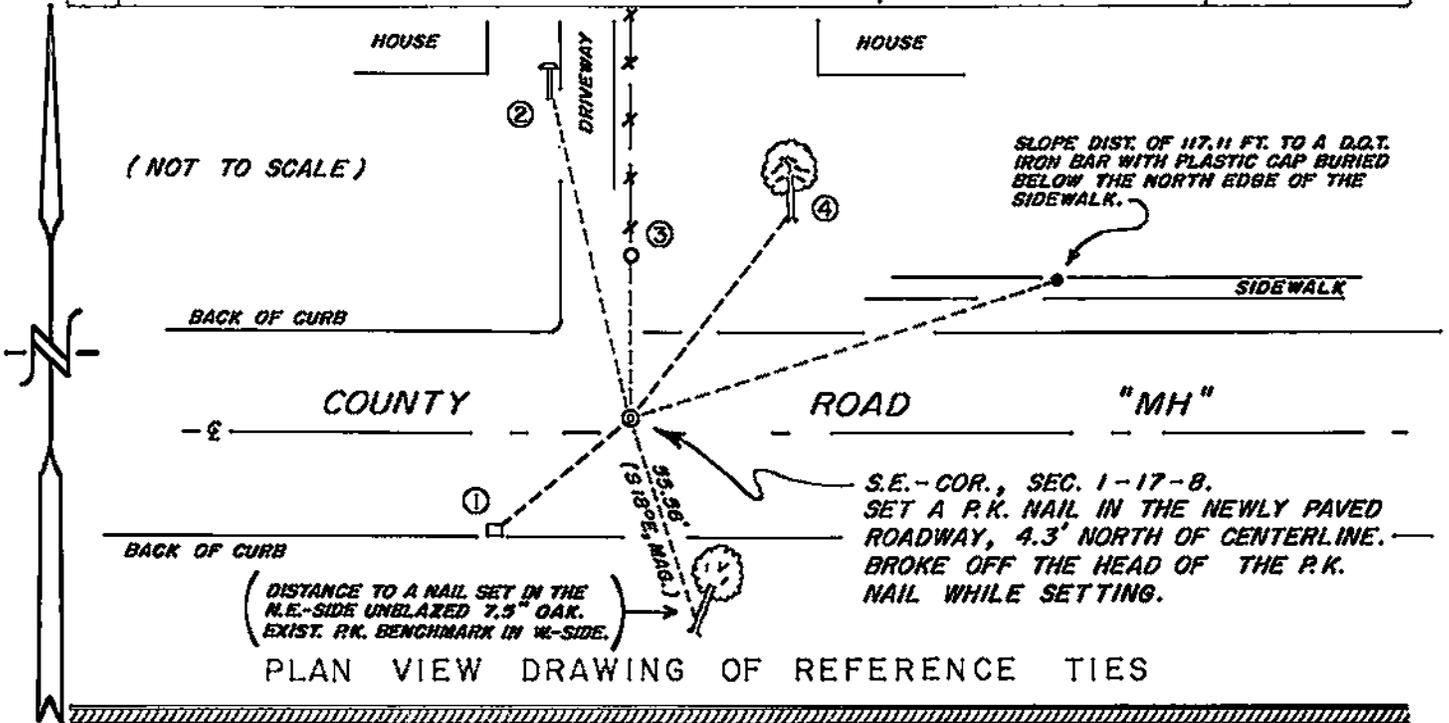


MAP SHOWING DISTANCE AND DIRECTION TO OTHER PUBLIC LAND SURVEY CORNERS USED FOR REESTABLISHING THE CORNER

(not to scale)

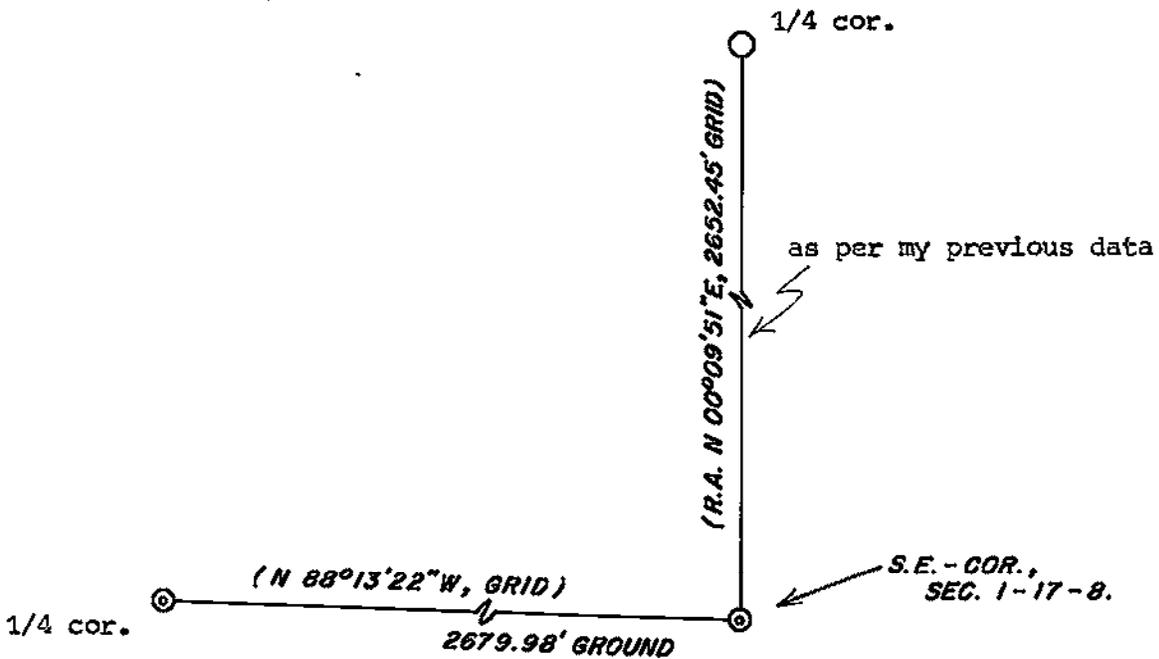


I, WILLIAM C. JUNG, COUNTY SURVEYOR
 HEREBY CERTIFY THAT THE CORNER LOCATION SHOWN ON THIS RECORD
 WAS DETERMINED BY ME OR UNDER MY DIRECTION AND CONTROL AND
 THAT THIS U. S. PUBLIC LAND SURVEY MONUMENT RECORD IS CORRECT
 AND COMPLETE TO THE BEST OF MY KNOWLEDGE AND BELIEF.

William C. Jung 2/11/98
 Signature Date

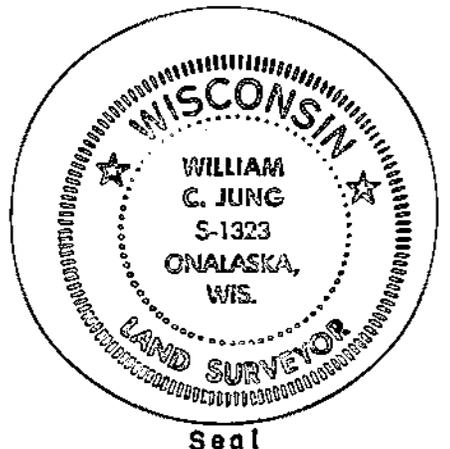

U. S. PUBLIC LAND SURVEY MONUMENT RECORD

SECTION 1 T 17 N, R 8 W, TOWN OF HOLLAND
 LA CROSSE COUNTY

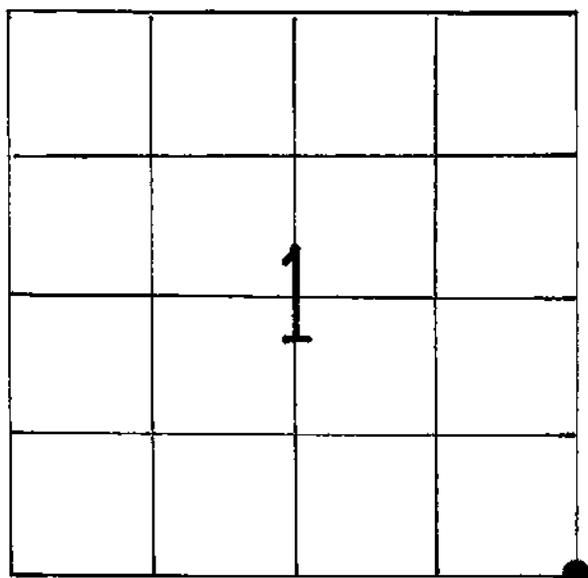

LOCATION OF LANDMARK

Crew: William Jung
 Perry Dahl

5/6/86

Describe any record evidence, monument evidence, testimonial evidence or any other material evidence you considered and whether the monument was found or restored through acceptance of an obliterated evidence location.

I found a 1" iron bar at the corner. This iron bar has been used as the corner in previous surveys. I accepted this bar as the best available evidence of the original government corner position, removed it, and replaced it with a 14" long Berntsen top, down 1". On 5/28/86 I found that the road had been repaved and thus the Berntsen is now below the pavement.

The Berntsen top was knocked out during construction. On 9/6/90 we set a Lunde marker.

Describe or show any material discrepancy between the location of the restored corner and that of the corner previously restored or reestablished.

None known.

South Zone

WISCONSIN COORDINATE SYSTEM	
North	720,610.829
East	1,665,599.991
Theta Angle	
Horiz. Order	
Vert. Order	

TYPE OF LANDMARK

~~Berntsen top~~ Brass capped Lunde marker

BEARINGS ARE REFERENCED TO

Grid


Crew: William Jung
 Peter Follansbee
 Phil Scholze

9/6/90

*Void
 ref*

RECORD OF DURABLE WITNESS MONUMENTS


NO	DESCRIPTION	BEARING	DISTANCE
1	To the center of a round iron pipe fence post	North \pm	33.76'
2	Existing nail and cap in road	East \pm	480'
3	To a P.K. in a hack in an unblazed 18" oak	Magnetic = S44°E	34.87'
4	Set a 1½" iron pipe	South \pm	33.03'

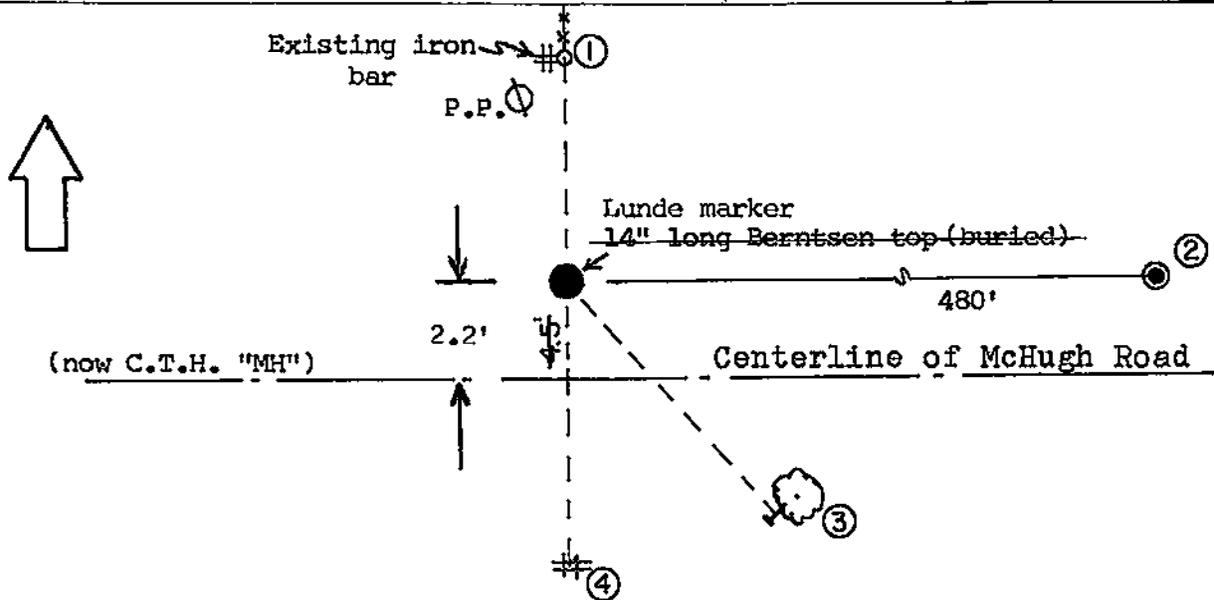

PLAN VIEW DRAWING OF REFERENCE TIES

MAP SHOWING DISTANCE AND DIRECTION TO OTHER PUBLIC LAND SURVEY CORNERS USED FOR REESTABLISHING THE CORNER

(not to scale)
Grid bearings and distances

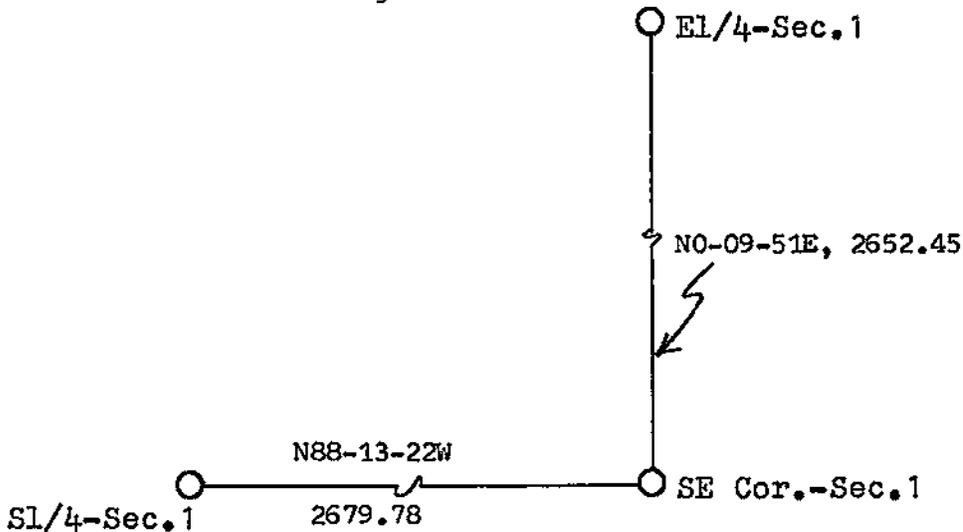

I, William C. Jung, Deputy County Surveyor,
HEREBY CERTIFY THAT THE CORNER LOCATION SHOWN ON THIS RECORD
WAS DETERMINED BY ME OR UNDER MY DIRECTION AND CONTROL AND
THAT THIS U. S. PUBLIC LAND SURVEY MONUMENT RECORD IS CORRECT
AND COMPLETE TO THE BEST OF MY KNOWLEDGE AND BELIEF.

William C. Jung
Signature

6/11/86

Date

Revised: 2/13/91 *wey*



Seal