


21708010020

U. S. PUBLIC LAND SURVEY MONUMENT RECORD

SECTION 12 T 17 N, R 8 W, TOWN OF HOLLAND  
 LA CROSSE COUNTY

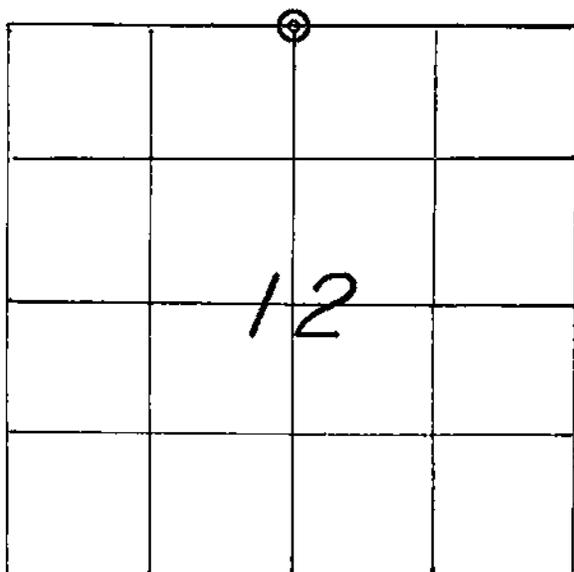

WISCONSIN COORDINATE SYSTEM
North
East
Theta Angle
Horiz. Order
Vert. Order
TYPE OF LANDMARK
P. K. NAIL.
BEARINGS ARE REFERENCED TO
Grid

LOCATION OF LANDMARK

CREW: WILLIAM C. JUNG  
 PETER F. FOLLANBEE  
 DATE: 11/25/97

Describe any record evidence, monument evidence, testimonial evidence or any other material evidence you considered and whether the monument was found or restored through acceptance of an obliterated evidence location.

The monument at this corner was destroyed during road construction. We set a P.K. nail at the old corner location.


Describe or show any material discrepancy between the location of the restored corner and that of the corner previously restored or reestablished.

NONE KNOWN.



U. S. PUBLIC LAND SURVEY MONUMENT RECORD

SECTION 1 T 17 N, R 8 W, TOWN OF HOLLAND  
 LA CROSSE COUNTY

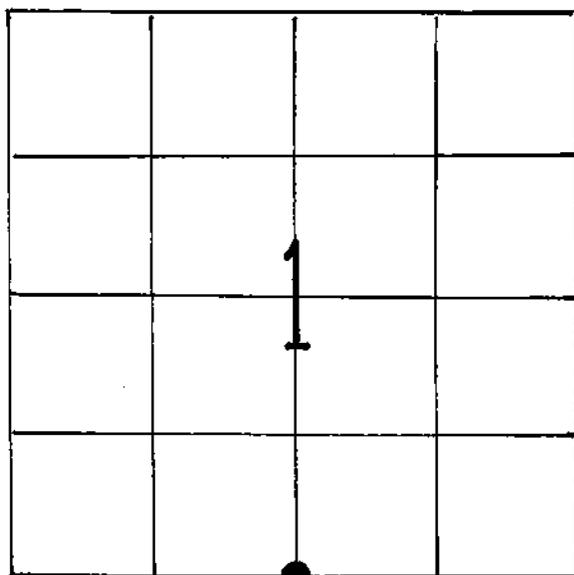

LOCATION OF LANDMARK

Crew: William Jung  
 Perry Dahl

5/5/86

Crew: William C. Jung  
 Peter F. Follansbee

3/13/92

Describe any record evidence, monument evidence, testimonial evidence or any other material evidence you considered and whether the monument was found or restored through acceptance of an obliterated evidence location.

I found an iron pipe at the corner that has been used as the corner in numerous previous surveys. I accepted this pipe as the corner by common usage or report. I think that the pipe should have been 12' East and 5' South, but to do so would cause untold legal problems for the public and surrounding landowners. Also, I cannot completely prove that the corner is wrong. Therefore, I accepted the pipe location as the best available evidence, pounded it down, and set 10" of Barntsen top over it.

Note: Ray Pelishek, Phil Scholze, and Bob Chalsma all agree that the existing pipe location should be used.

Describe or show any material discrepancy between the location of the restored corner and that of the corner previously restored or reestablished.

None known.

South Zone

WISCONSIN COORDINATE SYSTEM	
North	720,693.937
East	1,662,921.505
Theta Angle	
Horiz. Order	
Vert. Order	

TYPE OF LANDMARK

10" Barntsen top over existing iron pipe

BEARINGS ARE REFERENCED TO

Grid

Fd. a P.K. nail set by the D.O.T. after new construction. The old monuments appear to be under the new pavement.

*Void  
 weg*

