


21708012000

U. S. PUBLIC LAND SURVEY MONUMENT RECORD

SECTION 1 T 17 N, R 8 W, TOWN OF HOLLAND

LA CROSSE COUNTY

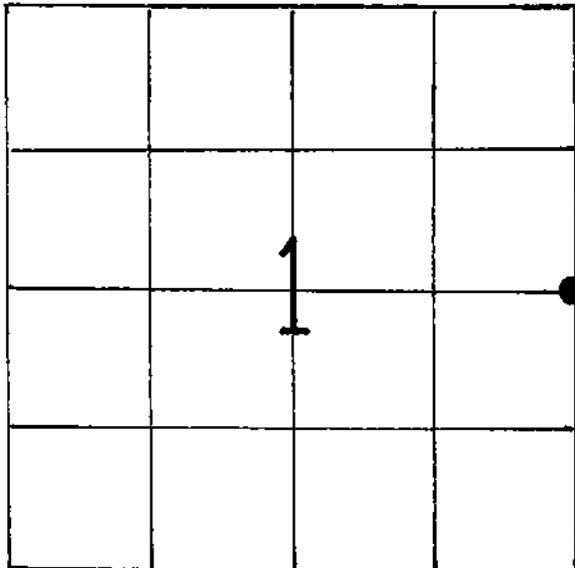

LOCATION OF LANDMARK

Crew: William Jung
Perry Dahl

5/28/86

Crew: William Jung *****
Peter Follansbee

7/8/08

Describe any record evidence, monument evidence, testimonial evidence or any other material evidence you considered and whether the monument was found or restored through acceptance of an obliterated evidence location.

I measured about 1319 feet between the existing fence corners at the C1/4 and CE1/16 corners. I then set the East 1/4 corner on line with the old fence to the West and at a distance of 2638 feet from the C1/4 corner. I set a Brass Capped Lunde Marker, down 21", out in a field.

***** We found our Lunde from 1986. There were two guard pipes East and West of it. Set a sign and post.

Describe or show any material discrepancy between the location of the restored corner and that of the corner previously restored or reestablished.

None known.

South Zone

WISCONSIN COORDINATE SYSTEM

North 723,263.272 (1927)

East 1,665,607.593

Theta Angle

Horiz. Order

Vert. Order

TYPE OF LANDMARK


Brass Capped Lunde Marker

BEARINGS ARE REFERENCED TO

Grid

RECORD OF DURABLE WITNESS MONUMENTS

NO	DESCRIPTION	BEARING	DISTANCE
1	P.K. nail in a hack in an unblazed 6" cedar	-----	166'
2	Set a rebar	West ±	28.48
3	Set an iron pipe behind a steel R/W post	-----	22.84
4			

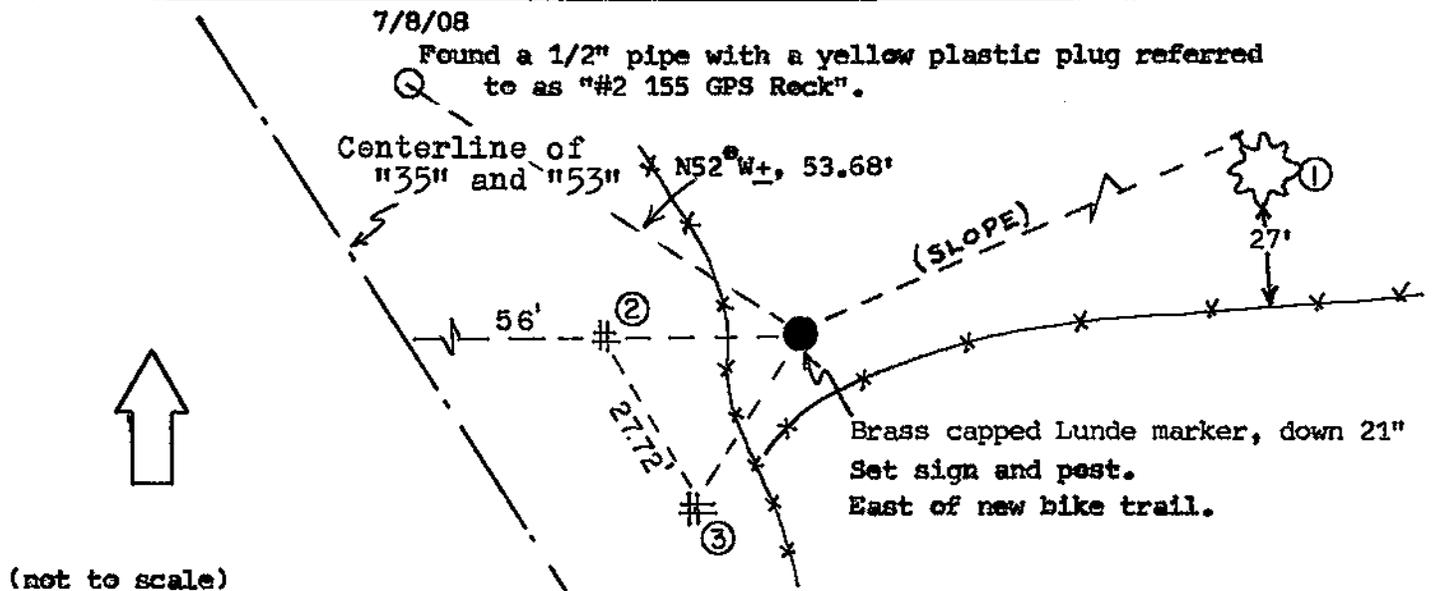


PLAN VIEW DRAWING OF REFERENCE TIES

MAP SHOWING DISTANCE AND DIRECTION TO OTHER PUBLIC LAND SURVEY CORNERS USED FOR REESTABLISHING THE CORNER

(not to scale)

Grid bearings and distances

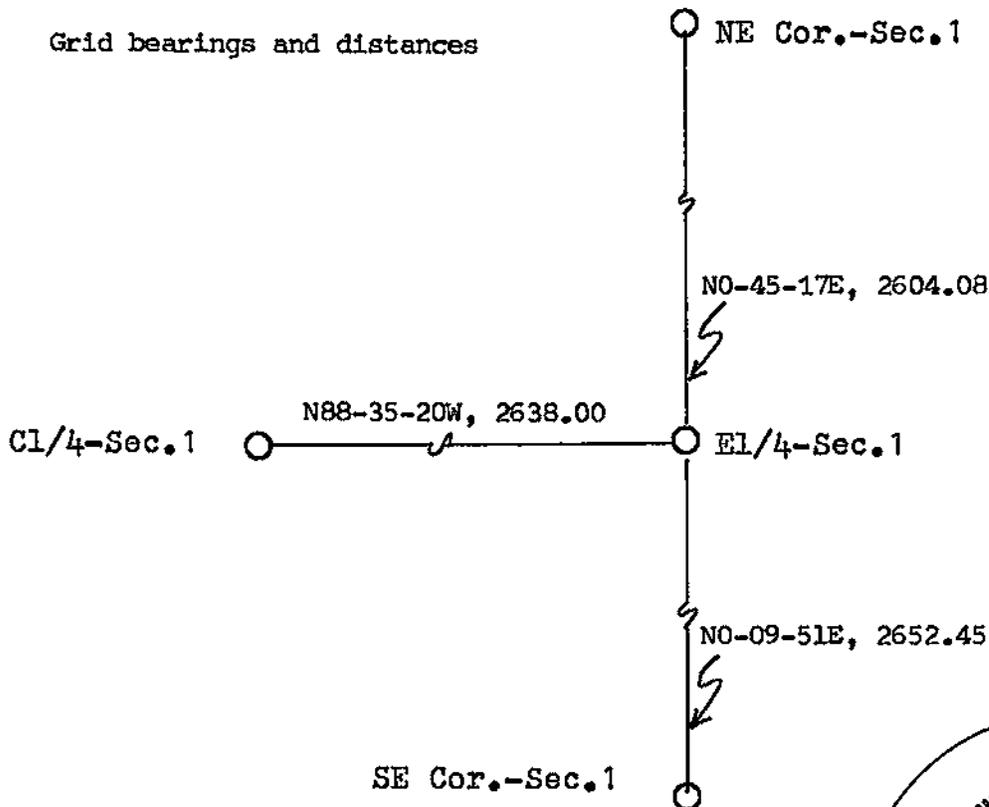

I, William C. Jung, Deputy County Surveyor,
 HEREBY CERTIFY THAT THE CORNER LOCATION SHOWN ON THIS RECORD
 WAS DETERMINED BY ME OR UNDER MY DIRECTION AND CONTROL AND
 THAT THIS U. S. PUBLIC LAND SURVEY MONUMENT RECORD IS CORRECT
 AND COMPLETE TO THE BEST OF MY KNOWLEDGE AND BELIEF.

William C. Jung
 Signature

6/11/86
 Date

Revised: 7/14/08 *wcj*



Seal