


21708012020

U. S. PUBLIC LAND SURVEY MONUMENT RECORD

SECTION 1 T 17 N, R 8 W, TOWN OF HOLLAND
 LA CROSSE COUNTY

SECTION 1

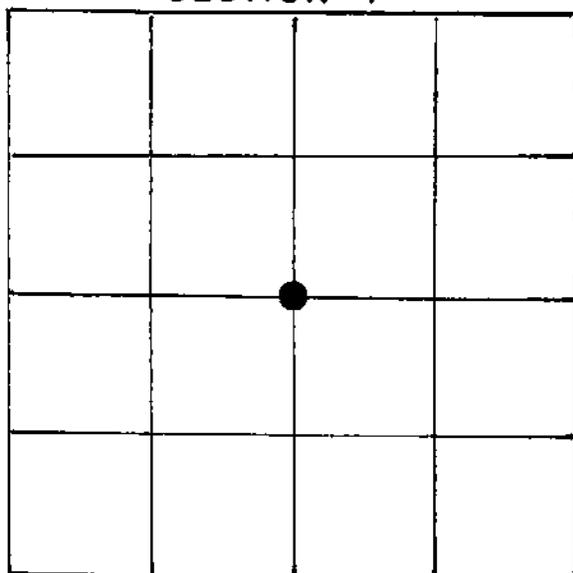

LOCATION OF LANDMARK

South Zone

WISCONSIN COORDINATE SYSTEM	
North	723,328.235
East	1,662,970.393
Theta Angle	
Horiz. Order	
Vert. Order	
TYPE OF LANDMARK	
Brass Capped Lunde Marker	
BEARINGS ARE REFERENCED TO	
Grid	

Crew: William Jung
 Perry Dahl

5/28/86

Describe any record evidence, monument evidence, testimonial evidence or any other material evidence you considered and whether the monument was found or restored through acceptance of an obliterated evidence location.

I found an old fence corner that in my opinion occupies a location where years ago the true C1/4 was monumented at the intersection of the 1/4 lines. All the field evidence that I found would indicate this. I therefore accepted this old fence corner as the best available evidence of that old location, and monumented it with a brass capped Lunde marker.

Describe or show any material discrepancy between the location of the restored corner and that of the corner previously restored or reestablished.

None known.

