


21708020000

U. S. PUBLIC LAND SURVEY MONUMENT RECORD

SECTION 1 T 17 N, R 8 W, TOWN OF HOLLAND
 LA CROSSE COUNTY

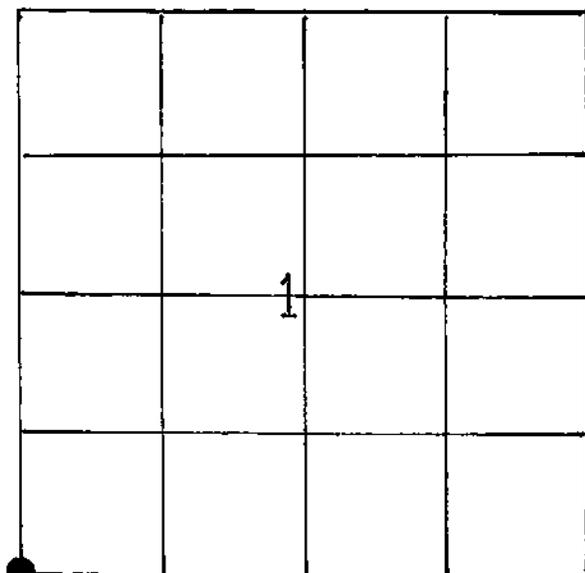

LOCATION OF LANDMARK

Crew: William Jung
 Perry Dahl
 5/5/86

South Zone

WISCONSIN COORDINATE SYSTEM	
North	720,739.415
East	1,660,268.229
Theta Angle	
Horiz. Order	
Vert. Order	
TYPE OF LANDMARK	
Berntsen top	
BEARINGS ARE REFERENCED TO	
Grid	

Describe any record evidence, monument evidence, testimonial evidence or any other material evidence you considered and whether the monument was found or restored through acceptance of an obliterated evidence location.


I found an iron bar at the corner. This bar has been used as the corner in previous surveys. I accepted this bar as the best available evidence of the original government corner position, removed it, and replaced it with a 14" long Berntsen top, down 1".

Describe or show any material discrepancy between the location of the restored corner and that of the corner previously restored or reestablished.

None known.

RECORD OF DURABLE WITNESS MONUMENTS

NO	DESCRIPTION	BEARING	DISTANCE
1	Existing iron pipe	-----	105.17
2	Existing 1 ³ / ₈ " O.D. iron pipe (buried)	North <u>±</u>	32.95
3	To the Southwest corner of a utility box	-----	33.15
4	To the Northwest corner of a utility box	South <u>±</u>	59.40

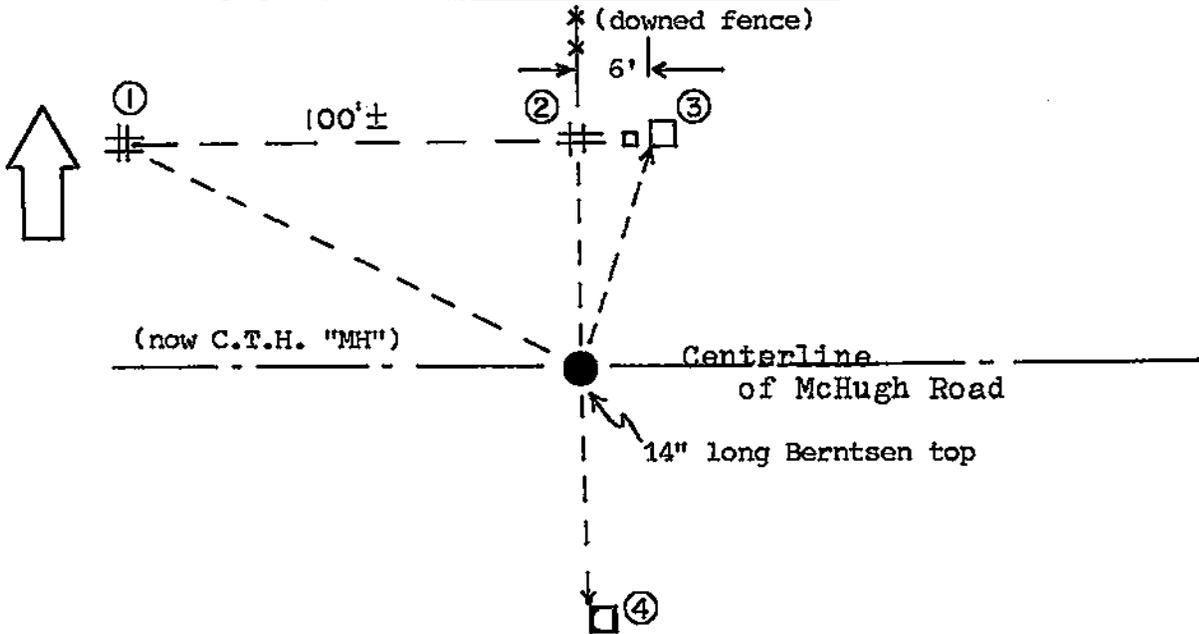


PLAN VIEW DRAWING OF REFERENCE TIES

MAP SHOWING DISTANCE AND DIRECTION TO OTHER PUBLIC LAND SURVEY CORNERS USED FOR REESTABLISHING THE CORNER

(not to scale)


Grid bearings and distances

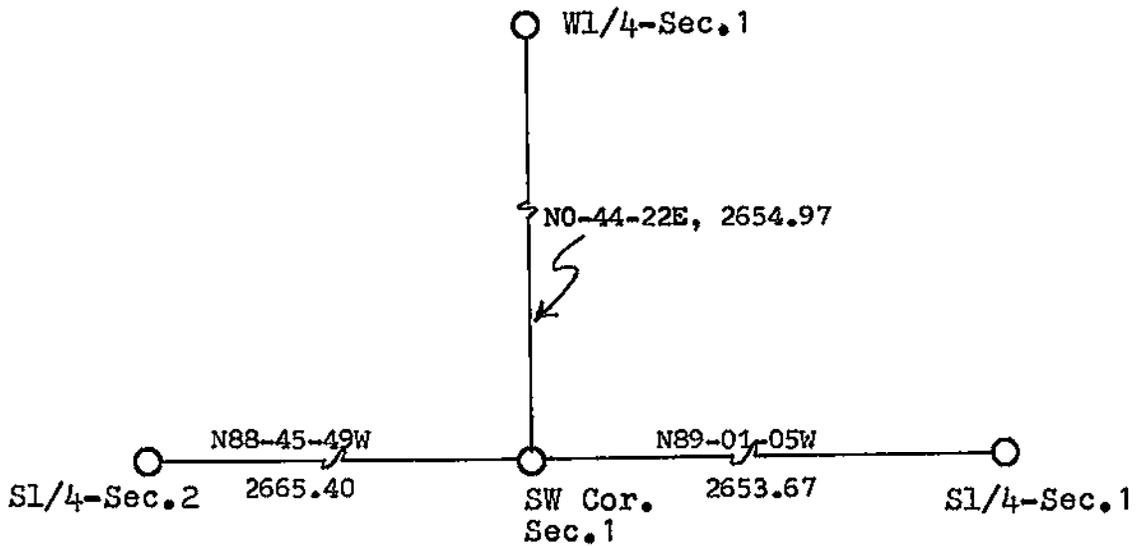

I, William C. Jung, Deputy County Surveyor,
 HEREBY CERTIFY THAT THE CORNER LOCATION SHOWN ON THIS RECORD
 WAS DETERMINED BY ME OR UNDER MY DIRECTION AND CONTROL AND
 THAT THIS U. S. PUBLIC LAND SURVEY MONUMENT RECORD IS CORRECT
 AND COMPLETE TO THE BEST OF MY KNOWLEDGE AND BELIEF.

William C. Jung
 Signature

6/11/86
 Date

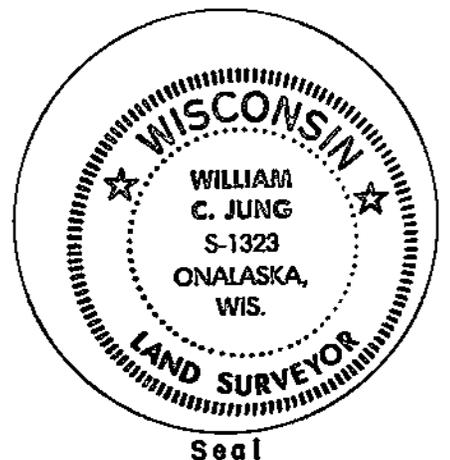

Seal