


21708020020 —

U. S. PUBLIC LAND SURVEY MONUMENT RECORD

SECTION 11 T 17 N, R 8 W, TOWN OF HOLLAND

LA CROSSE COUNTY

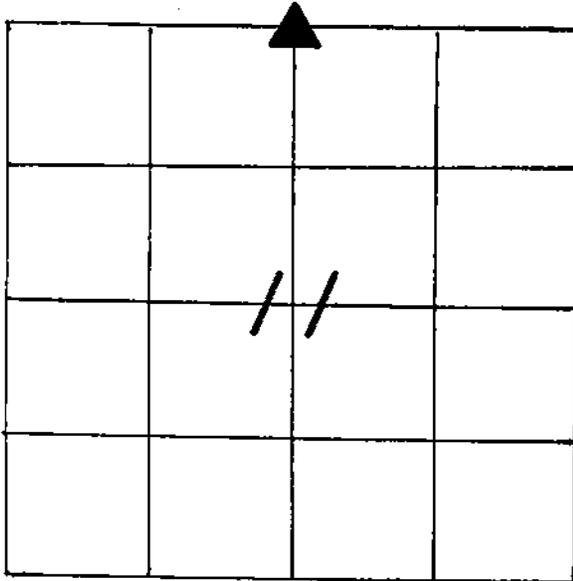

LOCATION OF LANDMARK

CREW: *WILLIAM G. JUNG*
PETER F. FOLLANSBEE
 DATE: *9/30/2004*

WISCONSIN COORDINATE SYSTEM	
North	<i>720,795.089</i>
East	<i>1,626,078.971</i>
Theta Angle	
Horiz. Order	
Vert. Order	
DATUM:	<i>1983('91)</i>
TYPE OF LANDMARK	
<i>RAILROAD SPIKE IN PAVEMENT.</i>	
BEARINGS ARE REFERENCED TO	
<i>GRID NORTH AS PER SECTION DATA.</i>	

Describe any record evidence, monument evidence, testimonial evidence or any other material evidence you considered and whether the monument was found or restored through acceptance of an obliterated evidence location.


Our old Berntsen marker was destroyed during highway construction last year(2004)
 We set a railroad spike at the old corner location after the highway was rebuilt.

Describe or show any material discrepancy between the location of the restored corner and that of the corner previously restored or reestablished.

NONE KNOWN.


RECORD OF DURABLE WITNESS MONUMENTS

NO	DESCRIPTION	BEARING	DISTANCE
1	EX. 12" SPIKE SET FLUSH IN THE GRASS	S.-WESTERLY ±	65.98 FT.
2	EX. 3/4" IRON BAR	NORTH ±	24.93 FT.
3	EX. 3/4" IRON BAR	N.-EASTERLY ±	184.60 FT. (SLOPE)
4	EX. 3/4" IRON BAR	SOUTH ±	50.47 FT.

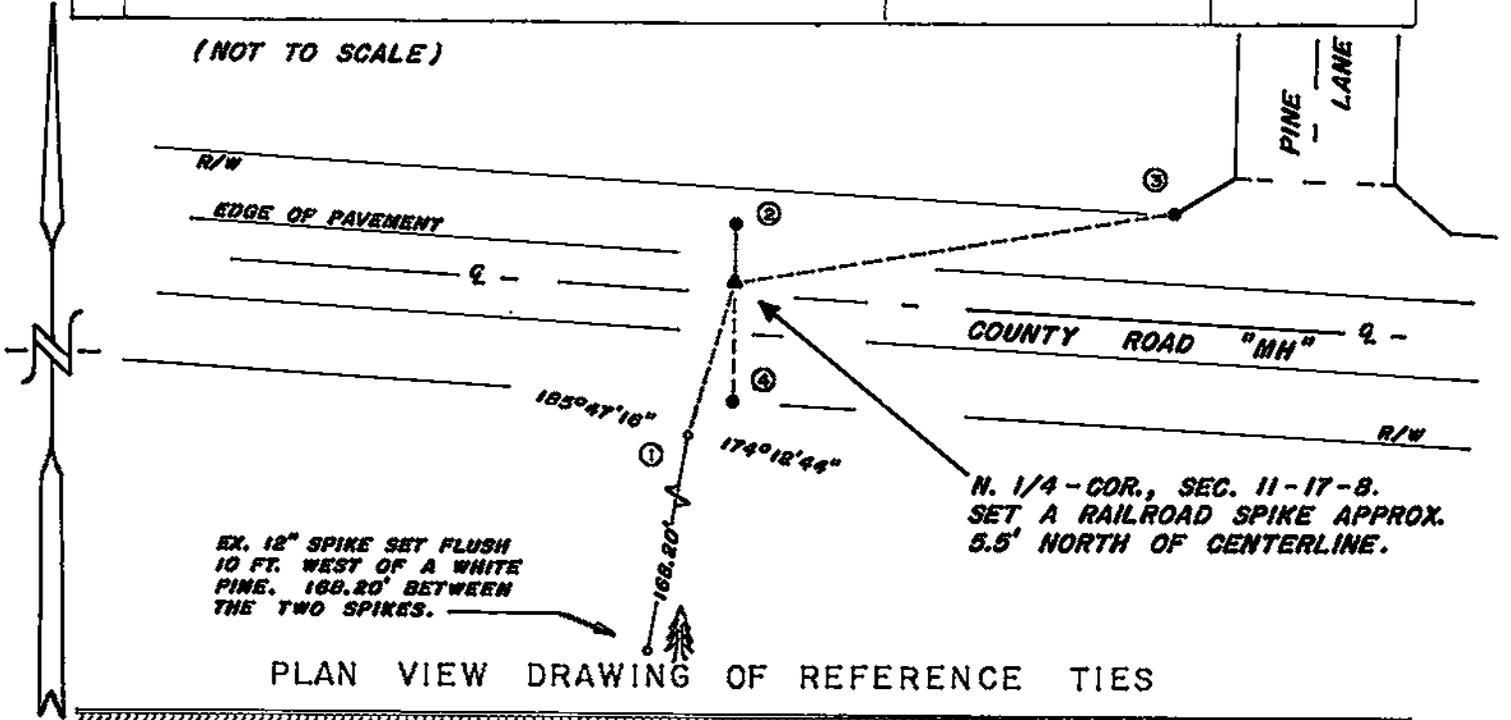

MAP SHOWING DISTANCE AND DIRECTION TO OTHER PUBLIC LAND SURVEY CORNERS USED FOR REESTABLISHING THE CORNER

(GRID BEARINGS AND DISTANCES)
(GRID FACTOR: 0.9999433)
(NOT TO SCALE)

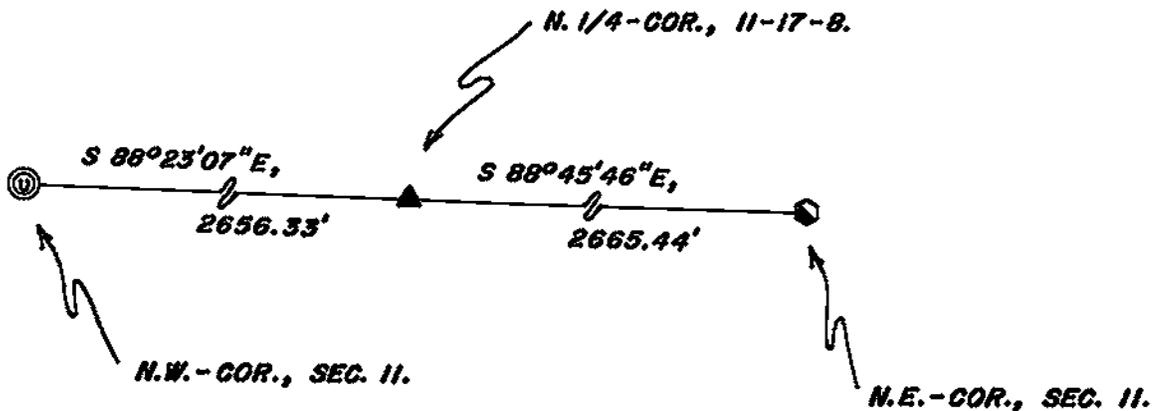

I, WILLIAM C. JUNG, COUNTY SURVEYOR
HEREBY CERTIFY THAT THE CORNER LOCATION SHOWN ON THIS RECORD WAS DETERMINED BY ME OR UNDER MY DIRECTION AND CONTROL AND THAT THIS U. S. PUBLIC LAND SURVEY MONUMENT RECORD IS CORRECT AND COMPLETE TO THE BEST OF MY KNOWLEDGE AND BELIEF.


William C. Jung 3/9/05
Signature Date



Seal

U. S. PUBLIC LAND SURVEY MONUMENT RECORD

SECTION 2 T 17 N, R 8 W, TOWN OF HOLLAND
 LA CROSSE COUNTY

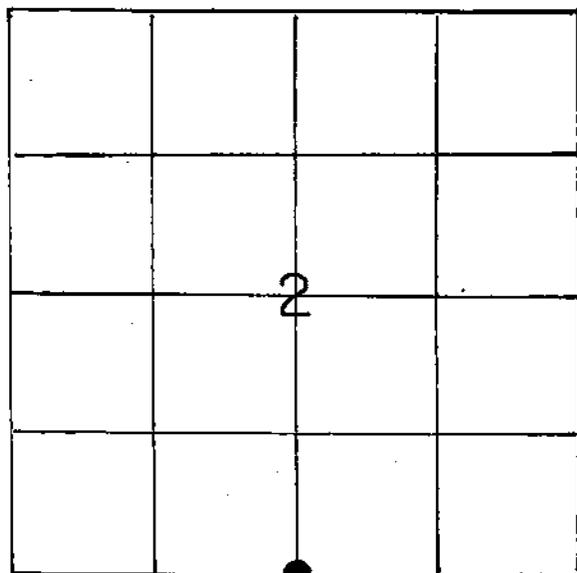

LOCATION OF LANDMARK

Crew: William Jung
 Perry Dahl
 5/2/86

Describe any record evidence, monument evidence, testimonial evidence or any other material evidence you considered and whether the monument was found or restored through acceptance of an obliterated evidence location.

I found an iron bar at the corner. This bar has been used as the corner in previous surveys. I accepted this bar as the best available evidence of the original government corner position, removed it, and replaced it with a 14" long Berntsen top, down 1/2" or so.

Describe or show any material discrepancy between the location of the restored corner and that of the corner previously restored or reestablished.


None known.

South Zone

WISCONSIN COORDINATE SYSTEM	
North	720,796.929
East	1,657,603.449
Theta Angle	
Horiz. Order	
Vert. Order	
TYPE OF LANDMARK	
Berntsen top	
BEARINGS ARE REFERENCED TO	
Grid	


RECORD OF DURABLE WITNESS MONUMENTS

NO	DESCRIPTION	BEARING	DISTANCE
1	Existing iron pipe	North \pm	25.00
2	To the center of a telephone box	-----	37.70
3	To a P.K. nail in a power pole	South \pm	34.27
4	To the center of a telephone box	-----	37.60

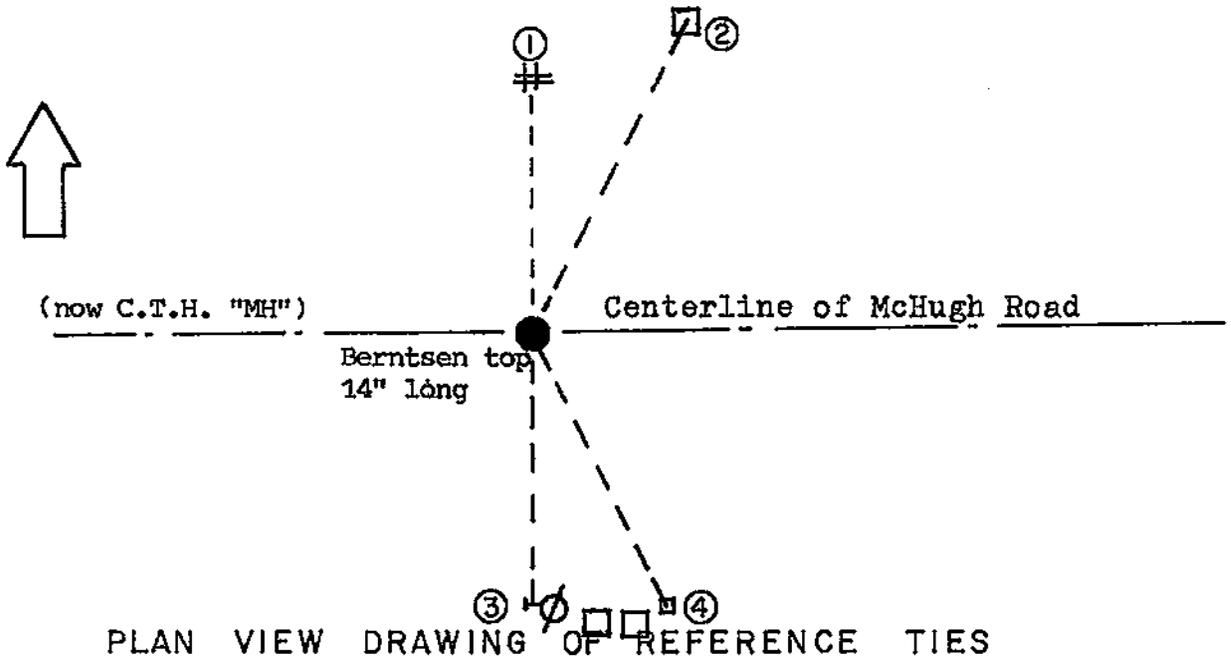

MAP SHOWING DISTANCE AND DIRECTION TO OTHER PUBLIC LAND SURVEY CORNERS USED FOR REESTABLISHING THE CORNER

(not to scale)
Grid bearings and distances

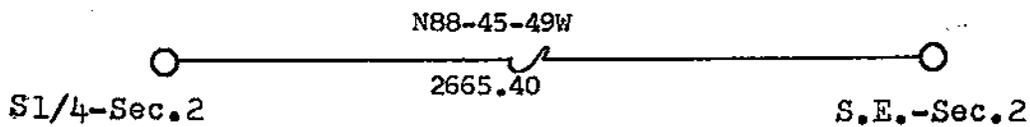

I, William C. Jung, Deputy County Surveyor,
HEREBY CERTIFY THAT THE CORNER LOCATION SHOWN ON THIS RECORD
WAS DETERMINED BY ME OR UNDER MY DIRECTION AND CONTROL AND
THAT THIS U. S. PUBLIC LAND SURVEY MONUMENT RECORD IS CORRECT
AND COMPLETE TO THE BEST OF MY KNOWLEDGE AND BELIEF.

William C. Jung
Signature

6/11/86
Date



Seal