


21708022000

U. S. PUBLIC LAND SURVEY MONUMENT RECORD

SECTION 1 T 17 N, R 8 W, TOWN OF HOLLAND

LA CROSSE COUNTY

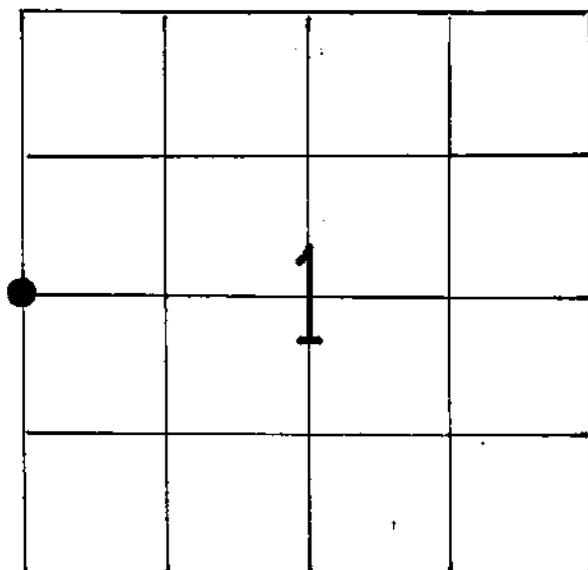

LOCATION OF LANDMARK

Crew: William Jung
Perry Dahl

5/2/86

Describe any record evidence, monument evidence, testimonial evidence or any other material evidence you considered and whether the monument was found or restored through acceptance of an obliterated evidence location.

I found an iron pipe at the old occupied fence corner. I removed the pipe and replaced it with a Berntsen monument. I accepted the fence corner as the best available evidence of the original government corner position. I assume that the pipe has been used in previous survey work.

Describe or show any material discrepancy between the location of the restored corner and that of the corner previously restored or reestablished.

None known.

South Zone

WISCONSIN COORDINATE SYSTEM

North 723,394.163

East 1,660,302.487

Theta Angle

Horiz. Order

Vert. Order

TYPE OF LANDMARK

Berntsen Monument


BEARINGS ARE REFERENCED TO

Grid

RECORD OF DURABLE WITNESS MONUMENTS

| NO | DESCRIPTION | BEARING | DISTANCE |
|----|---|------------------|----------|
| 1 | Set a 1½" iron pipe | North± | 31.75 |
| 2 | P.K. nail in a double blazed 10" Burr oak | Magnetic = S86°W | 34.96 |
| 3 | P.K. nail in a double blazed 9" Burr oak | Magnetic = S72°W | 19.40 |
| 4 | Set a 1½" iron pipe | South± | 15.01 |


(All P.K. nails are in hacks.)

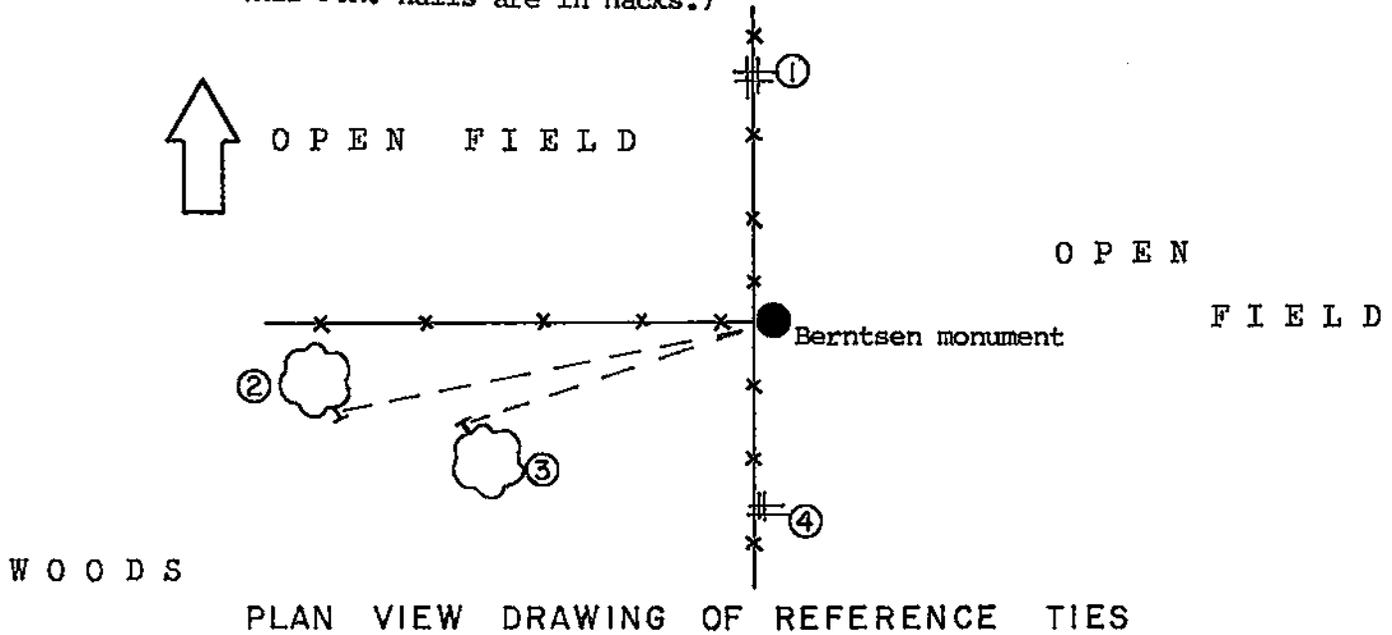

PLAN VIEW DRAWING OF REFERENCE TIES

MAP SHOWING DISTANCE AND DIRECTION TO OTHER PUBLIC LAND SURVEY CORNERS USED FOR REESTABLISHING THE CORNER

(not to scale)
Grid bearings and distances

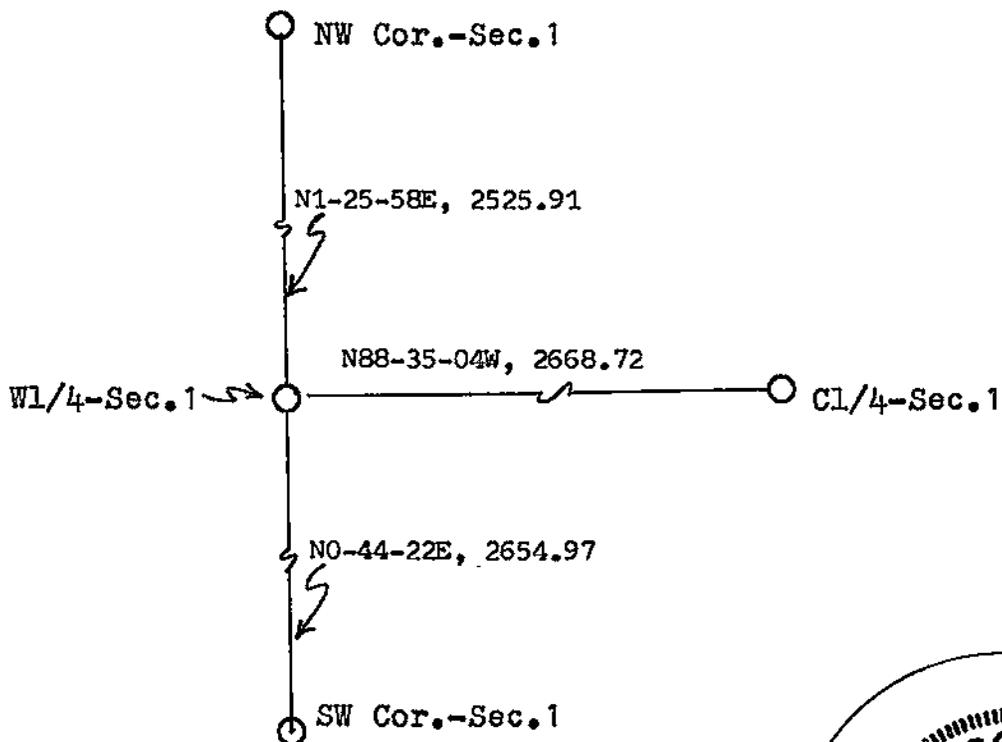

I, William C. Jung, Deputy County Surveyor,
HEREBY CERTIFY THAT THE CORNER LOCATION SHOWN ON THIS RECORD
WAS DETERMINED BY ME OR UNDER MY DIRECTION AND CONTROL AND
THAT THIS U. S. PUBLIC LAND SURVEY MONUMENT RECORD IS CORRECT
AND COMPLETE TO THE BEST OF MY KNOWLEDGE AND BELIEF.

William C. Jung
Signature

6/11/86
Date

