


**21708032000**

U. S. PUBLIC LAND SURVEY MONUMENT RECORD

SECTION 2 T 17 N, R 8 W, TOWN OF HOLLAND  
LA CROSSE COUNTY

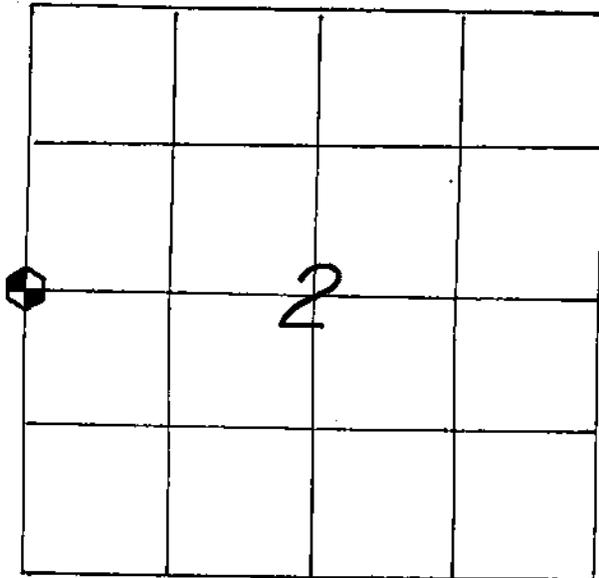

LOCATION OF LANDMARK

CREW: *WILLIAM C. JUNG*  
*PETER F. FOLLANSBEE*  
DATE: *7/15/1998*

WISCONSIN COORDINATE SYSTEM

North

East

Theta Angle

Horiz. Order

Vert. Order

TYPE OF LANDMARK

*BRASS CAP LUNDE MARKER.*

BEARINGS ARE REFERENCED TO

*ASSUMED NORTH.*

Describe any record evidence, monument evidence, testimonial evidence or any other material evidence you considered and whether the monument was found or restored through acceptance of an obliterated evidence location.

I found an iron pipe at the corner that had been used in previous surveys. I accepted this pipe as the best available evidence of the original government corner position. I removed the pipe and replaced it with a Lunde marker.

Describe or show any material discrepancy between the location of the restored corner and that of the corner previously restored or reestablished.

None known.


RECORD OF DURABLE WITNESS MONUMENTS

NO	DESCRIPTION	BEARING	DISTANCE
1	NAIL IN S.-SIDE 27" OAK, 3.5 FT. N. OF FENCE	WESTERLY ±	42.05 FT.
2	NAIL IN S.W.-SIDE 6" OAK	N.'WESTERLY ±	17.21 FT.
3	NAIL IN W.-SIDE 6" OAK	NORTHERLY ±	7.60 FT.
4	NAIL IN S.-SIDE 9" TRIPLE TRUNK OAK	EASTERLY ±	17.61 FT.

( NOT TO SCALE )

W. 1/4 - COR., 2-17-8.  
 SET A BRASS CAP LUNDE MARKER TO REPLACE  
 AN EX. 1-3/4" x 39" I.P. BURIED A WHISKEY  
 BOTTLE CONTAINING A SHELL CASING  
 WITH THE MARKER. THERE IS A 7-1/2"  
 TREE 1.5'± TO THE CENTER, S.'WEST  
 OF THE LUNDE. SET A SIGN &  
 POST TO THE NORTH.


(NOTE: THE FOUR BEARING TREES  
 ARE DOUBLE BLAZED OAKS.)

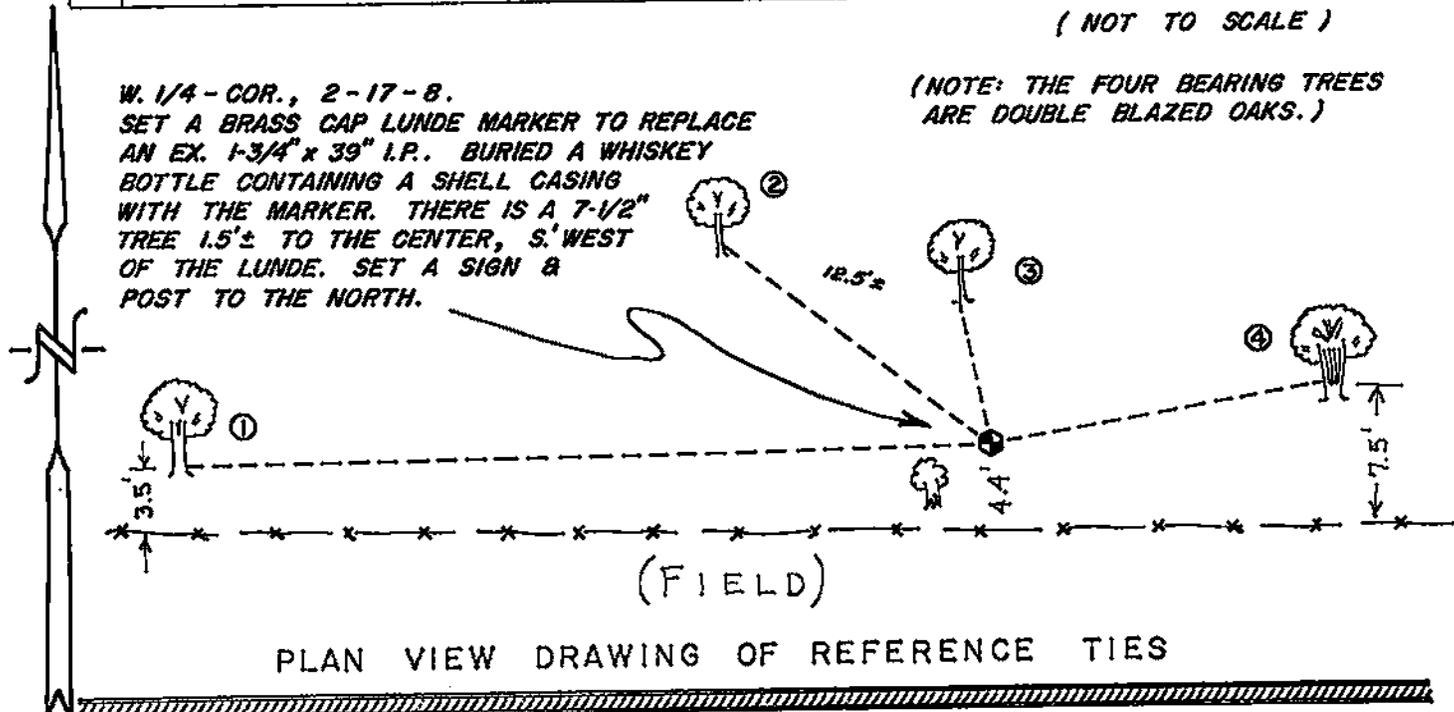

MAP SHOWING DISTANCE AND DIRECTION TO OTHER PUBLIC LAND  
 SURVEY CORNERS USED FOR REESTABLISHING THE CORNER

(not to scale)

( ARROW LAND SURVEYING MEASUREMENTS )

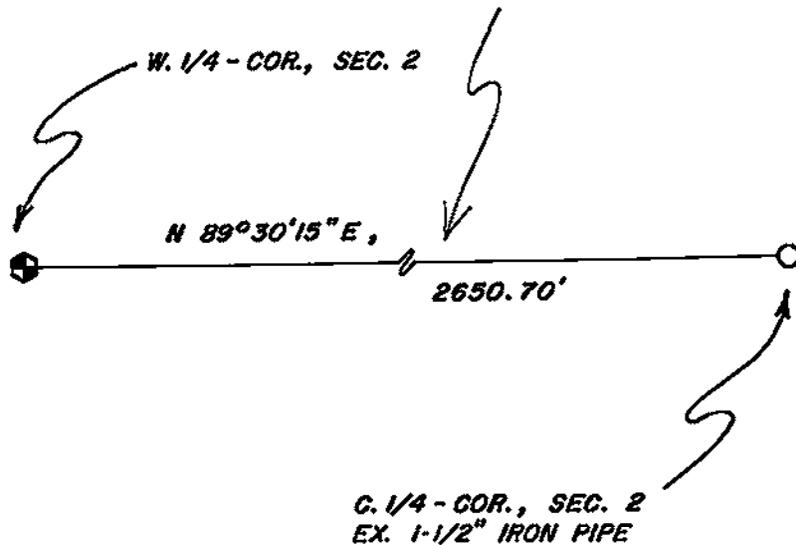

I, WILLIAM C. JUNG, COUNTY SURVEYOR  
 HEREBY CERTIFY THAT THE CORNER LOCATION SHOWN ON THIS RECORD  
 WAS DETERMINED BY ME OR UNDER MY DIRECTION AND CONTROL AND  
 THAT THIS U. S. PUBLIC LAND SURVEY MONUMENT RECORD IS CORRECT  
 AND COMPLETE TO THE BEST OF MY KNOWLEDGE AND BELIEF.

William C. Jung 3/23/99  
 Signature Date

