


21708042000

U. S. PUBLIC LAND SURVEY MONUMENT RECORD

SECTION 3 T 17 N, R 8 W, TOWN OF HOLLAND

LACROSSE COUNTY

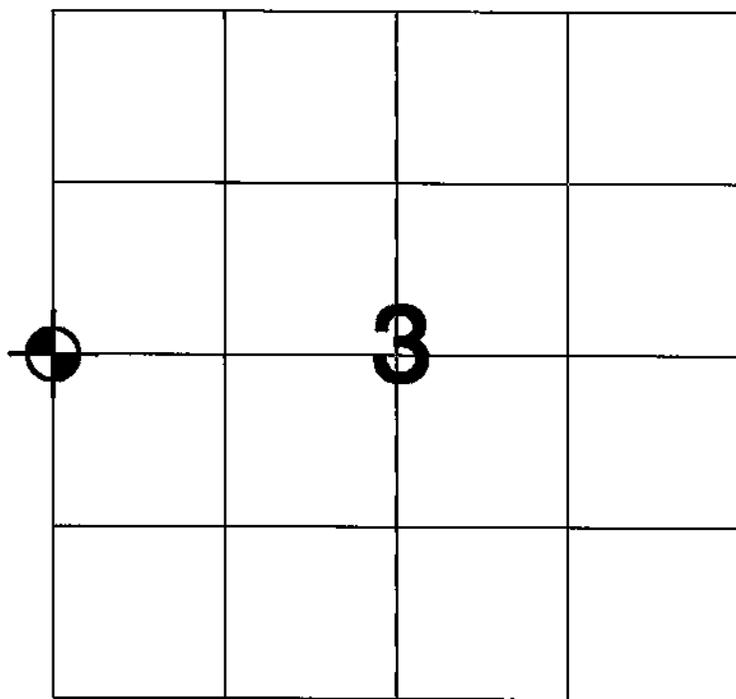

LOCATION OF LANDMARK

| |
|--|
| WISCONSIN COORDINATE SYSTEM |
| NORTH |
| EAST |
| THETA ANGLE |
| HORIZ. ORDER |
| VERT. ORDER |
| TYPE OF LANDMARK FOUND 1-1/2" I.P.I.P.E |
| BEARINGS ARE REFERENCED TO ASSUMED |

CREW: RICHARD A. BERG
DUSTIN B. BERG

Describe any record evidence, monument evidence, testimonial evidence or any other material evidence you considered and whether the monument was found or restored through acceptance of an obliterated evidence location.

WE FOUND AN EXISTING 1-1/2" IRON PIPE AT THE APPROXIMATE LOCATION OF THE COMPUTED CORNER AND ACCEPTED IT AS THE W1/4 CORNER OF SECTION 3, T17N, R8W.

Describe or show any material discrepancy between the location of the restored corner and that of the corner previously restored or reestablished.


None Known.

NOV 07 2005

COUNTY CLERK'S OFFICE

RECORD OF DURABLE WITNESS MONUMENTS


| NO | DESCRIPTION | BEARING | DISTANCE |
|----|-----------------------|-------------|----------|
| 1 | SET NAIL IN 12" MAPLE | N53°43'47"W | 50.01' |
| 2 | SET NAIL IN 20" MAPLE | S57°19'25"W | 76.09' |
| 3 | SET NAIL IN 15" MAPLE | S32°54'13"E | 75.89' |
| 4 | 10" SPIKE IN GROUND | S28°38'48"E | 15.50' |

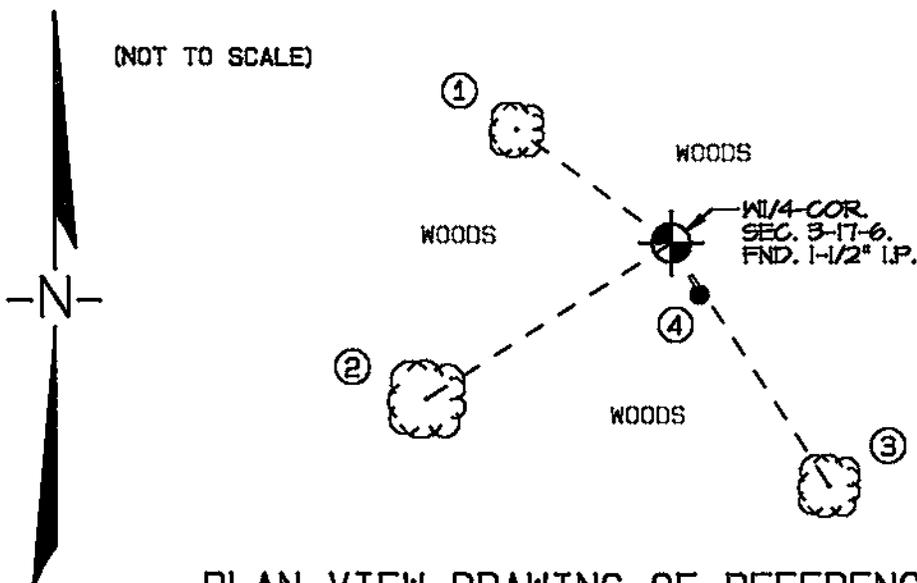

PLAN VIEW DRAWING OF REFERENCE TIES

MAP SHOWING DISTANCE AND DIRECTION TO OTHER PUBLIC LAND SURVEY CORNERS USED FOR REESTABLISHING THE CORNER

(NOT TO SCALE)

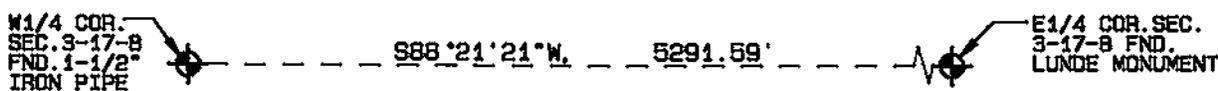

I, RICHARD A. BERG, REGISTERED LAND SURVEYOR

HEREBY CERTIFY THAT THE CORNER LOCATION SHOWN ON THIS RECORD WAS DETERMINED BY ME OR UNDER MY DIRECTION AND CONTROL AND THAT THIS U. S. PUBLIC LAND SURVEY MONUMENT RECORD IS CORRECT AND COMPLETE TO THE BEST OF MY KNOWLEDGE AND BELIEF.

Richard A. Berg
SIGNATURE

11-07-05
DATE

