


21708090000

## U. S. PUBLIC LAND SURVEY MONUMENT RECORD

SECTION 16 T 17 N, R 8 W, TOWN OF ONALASKA

LA CROSSE COUNTY

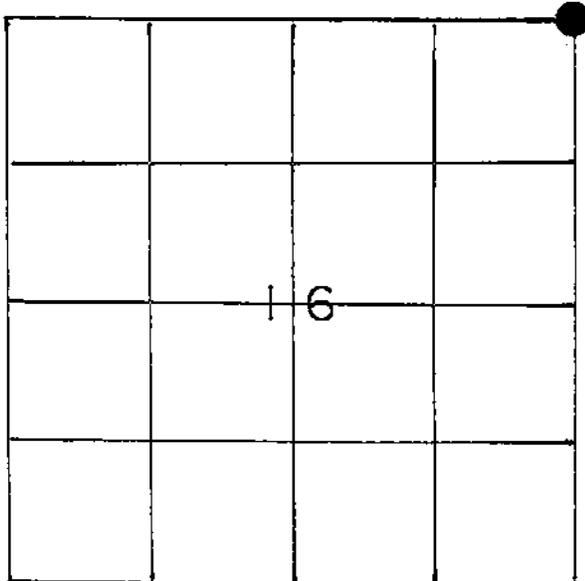

LOCATION OF LANDMARK

Crew: William Jung  
 Perry Dahl  
 4/18/85

WISCONSIN COORDINATE SYSTEM
North
East
Theta Angle
Horiz. Order
Vert. Order
TYPE OF LANDMARK
3" BRASS CAPPED MONUMENT
BEARINGS ARE REFERENCED TO

Describe any record evidence, monument evidence, testimonial evidence or any other material evidence you considered and whether the monument was found or restored through acceptance of an obliterated evidence location.


I found a 3" brass capped marker at the corner. It was stamped  $\frac{9}{16} | \frac{10}{15}$ , 17N-8W, 1963, no. 8, and is on the Northwest side of the dwy. Chalsma and Berg have used this corner in surveys. I accepted this monument as the best available evidence of the original government corner position.

Describe or show any material discrepancy between the location of the restored corner and that of the corner previously restored or reestablished.

None known.

RECORD OF DURABLE WITNESS MONUMENTS

NO	DESCRIPTION	BEARING	DISTANCE
1	1½" IRON PIPE (existing, up 1.8')	North ±	74.0'
2	UNBAZED TREE, 17" (dist. to P.K. in back)	_____	16.32'
3	PUNCH HOLE IN CULVERT END	_____	22.15'
4	P.K. NAIL (existing)	North ±	? 45.16'

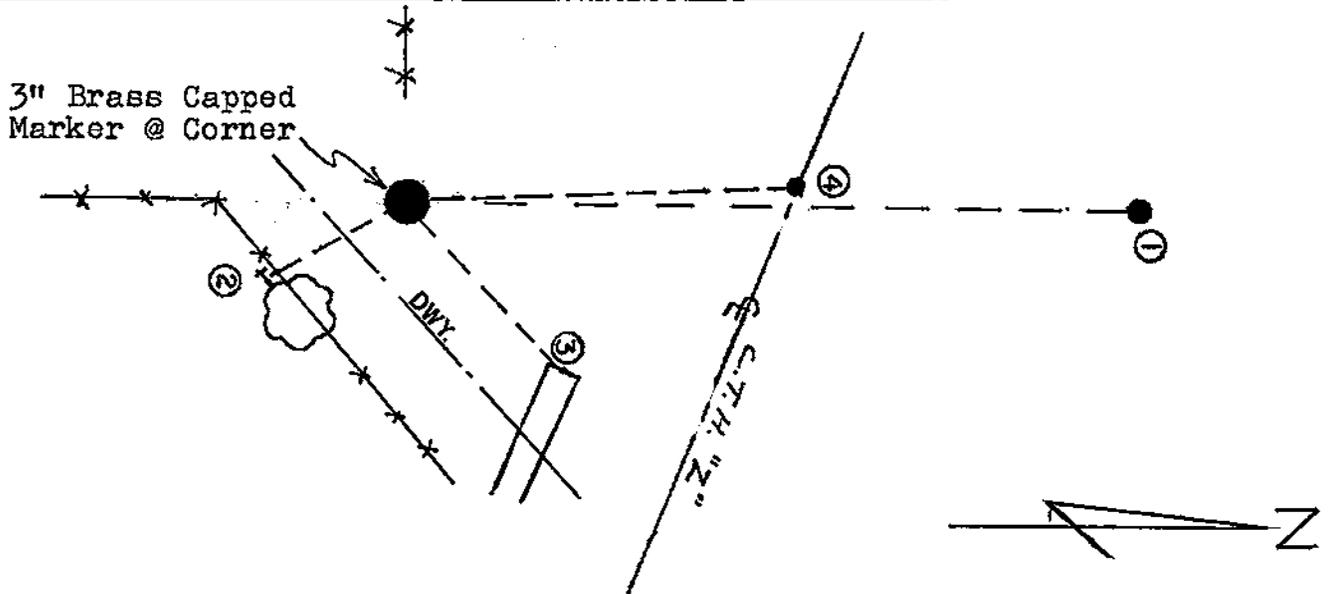

PLAN VIEW DRAWING OF REFERENCE TIES




MAP SHOWING DISTANCE AND DIRECTION TO OTHER PUBLIC LAND SURVEY CORNERS USED FOR REESTABLISHING THE CORNER

No measurements made by me at this time.

I, William C. Jung, Deputy County Surveyor,  
 HEREBY CERTIFY THAT THE CORNER LOCATION SHOWN ON THIS RECORD  
 WAS DETERMINED BY ME OR UNDER MY DIRECTION AND CONTROL AND  
 THAT THIS U. S. PUBLIC LAND SURVEY MONUMENT RECORD IS CORRECT  
 AND COMPLETE TO THE BEST OF MY KNOWLEDGE AND BELIEF.

William C. Jung  
 Signature

2/14/86  
 Date

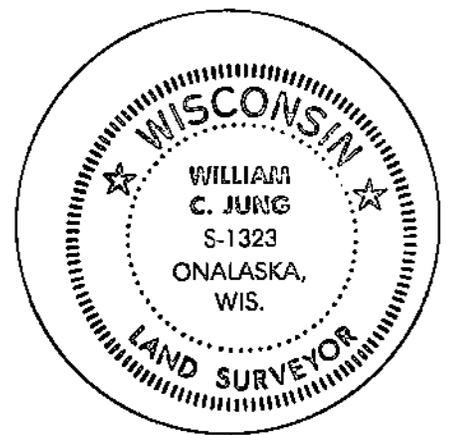

Seal