


21708110000

U. S. PUBLIC LAND SURVEY MONUMENT RECORD

SECTION 13 T 17 N, R 8 W, TOWN OF Onalaska
 LA CROSSE COUNTY

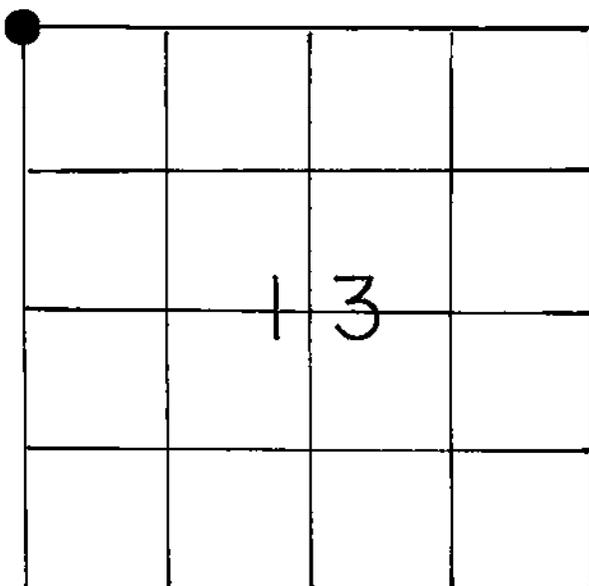

LOCATION OF LANDMARK

WISCONSIN COORDINATE SYSTEM
North
East
Theta Angle
Horiz. Order
Vert. Order
TYPE OF LANDMARK
Existing 3" brass capped monument
BEARINGS ARE REFERENCED TO

Crew: William C. Jung
 Peter Follansbee

Date: 12/8/88

Describe any record evidence, monument evidence, testimonial evidence or any other material evidence you considered and whether the monument was found or restored through acceptance of an obliterated evidence location.


The U.S.B.S. set a 3" brass capped monument at this corner in 1931. It has since been used as the corner in several surveys. Terry Kerwin found the monument well off plumb and straightened it up. The corner is on the Northeast side of a "tire" flower bed. A 1 1/2" witness pipe, pounded flush, is 0.46' Southeast of the corner. I accepted this monument as the best available evidence of the original government corner position.

Describe or show any material discrepancy between the location of the restored corner and that of the corner previously restored or reestablished.

None known.

RECORD OF DURABLE WITNESS MONUMENTS

NO	DESCRIPTION	BEARING	DISTANCE
1	Existing "X", by Cheryl, in concrete over culvert, on North side of culvert	-----	51.07
2	Set bolt and cap in the road	West \pm	80.55
3	" " " " " " "	South \pm	102.04
4	Set 2 1/2" iron pipe near fence corner	"	154.79

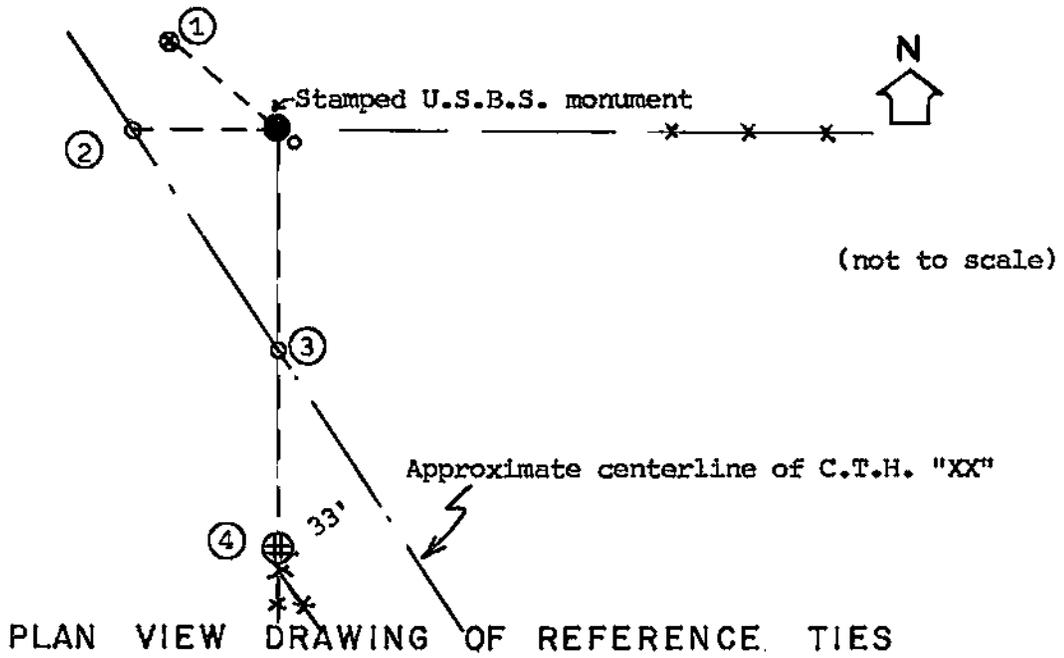


MAP SHOWING DISTANCE AND DIRECTION TO OTHER PUBLIC LAND SURVEY CORNERS USED FOR REESTABLISHING THE CORNER

(no measurements made by me at this time)

I, William C. Jung, Deputy County Surveyor,
 HEREBY CERTIFY THAT THE CORNER LOCATION SHOWN ON THIS RECORD
 WAS DETERMINED BY ME OR UNDER MY DIRECTION AND CONTROL AND
 THAT THIS U. S. PUBLIC LAND SURVEY MONUMENT RECORD IS CORRECT
 AND COMPLETE TO THE BEST OF MY KNOWLEDGE AND BELIEF.

William C. Jung 1/17/89
 Signature Date

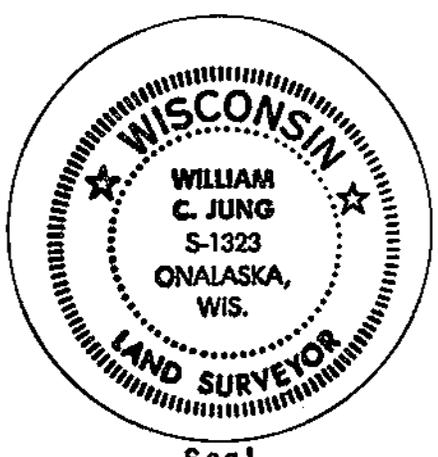

Seal