


21708110020

U. S. PUBLIC LAND SURVEY MONUMENT RECORD

SECTION 11 T 17 N, R 8 W, TOWN OF HOLLAND

LA CROSSE COUNTY

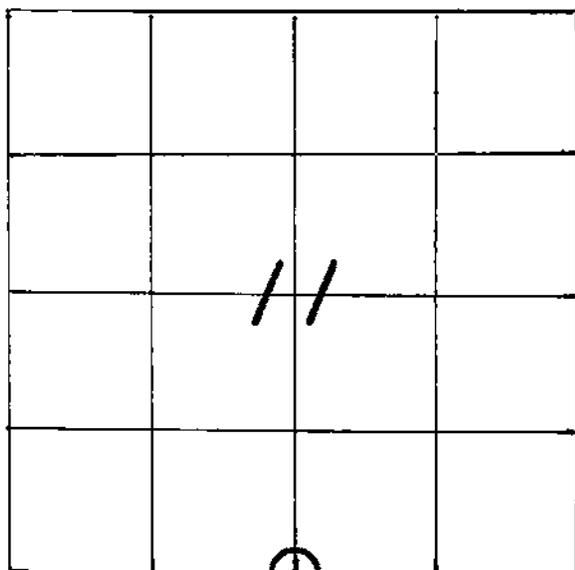

LOCATION OF LANDMARK

CREW: WILLIAM C. JUNG
 PETER F. FOLLANSBEE
 DATE: 11/04/2008

WISCONSIN COORDINATE SYSTEM

North

East

Theta Angle

Horiz. Order

Vert. Order

TYPE OF LANDMARK

3/4" x 30" IRON BAR WITH AN ALUMINUM CAP.

BEARINGS ARE REFERENCED TO

TRUE NORTH AS PER SECTION DATA.

Describe any record evidence, monument evidence, testimonial evidence or any other material evidence you considered and whether the monument was found or restored through acceptance of an obliterated evidence location.


Greg Hofmeister set an iron pipe at this corner in 1980. I found and accepted his pipe as the corner. I drove a capped bar into the pipe. The pipe was buried in an old field.

Describe or show any material discrepancy between the location of the restored corner and that of the corner previously restored or reestablished.

NONE KNOWN.


RECORD OF DURABLE WITNESS MONUMENTS

NO	DESCRIPTION	MAGNETIC	
		BEARING	DISTANCE
1	SET A NAIL IN N.E.-SIDE OF A 14" NORWAY PINE	N 25° W	32.10 FT.
2	SET A NAIL IN S.E.-SIDE OF AN 8" NORWAY PINE	N 16° E	34.70 FT.
3	SET A NAIL IN N.W.-SIDE OF A 10" NORWAY PINE	N 55° E	24.28 FT.
4	SET A NAIL IN N.-SIDE OF A DOUBLE NORWAY	N 89° E	50.61 FT.

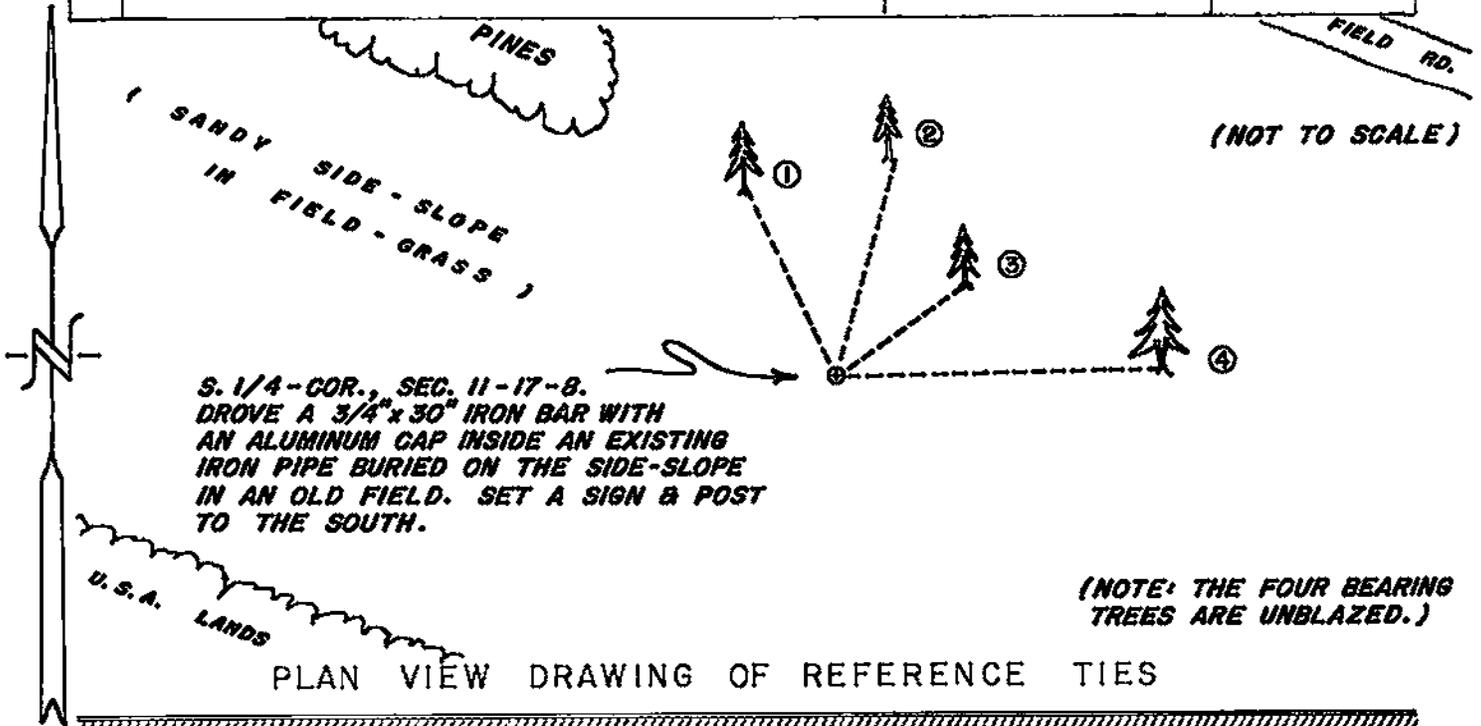

MAP SHOWING DISTANCE AND DIRECTION TO OTHER PUBLIC LAND SURVEY CORNERS USED FOR REESTABLISHING THE CORNER

(BEARING BASIS IS TRUE NORTH)
(G. HOFMEISTER MEASUREMENTS)
(NOT TO SCALE)

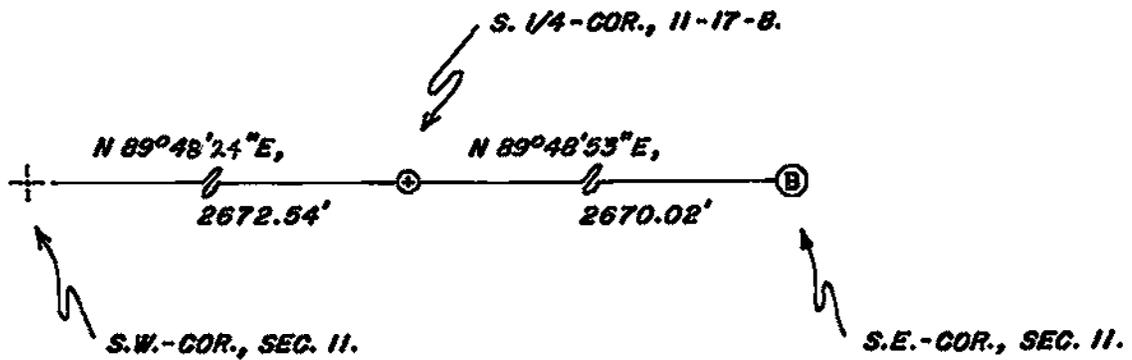

I, WILLIAM C. JUNG, COUNTY SURVEYOR
HEREBY CERTIFY THAT THE CORNER LOCATION SHOWN ON THIS RECORD WAS DETERMINED BY ME OR UNDER MY DIRECTION AND CONTROL AND THAT THIS U. S. PUBLIC LAND SURVEY MONUMENT RECORD IS CORRECT AND COMPLETE TO THE BEST OF MY KNOWLEDGE AND BELIEF.

William C. Jung
Signature

11/20/08
Date



Seal