


21708120020

U. S. PUBLIC LAND SURVEY MONUMENT RECORD

SECTION 12 T 17 N, R 8 W, TOWN OF HOLLAND/ONALASKA
 LA CROSSE COUNTY

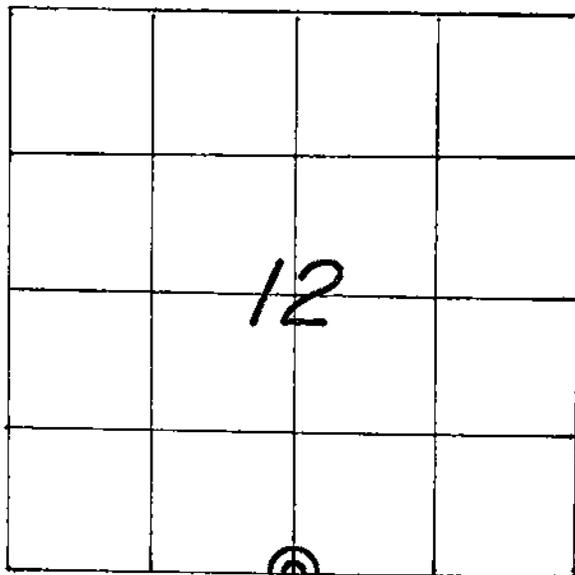

LOCATION OF LANDMARK

CREW: **WILLIAM C. JUNG**
PETER F. FOLLANSBEE
 DATE: **10/30/2003**

WISCONSIN COORDINATE SYSTEM	
North	715,376.179
East	1,631,364.242
Theta Angle	
Horiz. Order	
Vert. Order	
DATUM:	1983('91)
TYPE OF LANDMARK	
EXISTING P.K. NAIL.	
BEARINGS ARE REFERENCED TO	

Describe any record evidence, monument evidence, testimonial evidence or any other material evidence you considered and whether the monument was found or restored through acceptance of an obliterated evidence location.


Gary Watts set an iron pipe at this corner in 1981. That pipe was used as the corner in subsequent surveys. When the new highway was built, that pipe was destroyed. Someone then set a P.K. nail at this corner. The P.K. was then used as the corner in more surveys. I made enough measurements to verify the correct position of the existing P.K. nail and tied it off. The P.K. nail appears to be at Watts' old location.

Describe or show any material discrepancy between the location of the restored corner and that of the corner previously restored or reestablished.


NONE KNOWN.

RECORD OF DURABLE WITNESS MONUMENTS

NO	DESCRIPTION	BEARING	DISTANCE
1	S.E.-COR. STORM GRATE RIM. (OUTSIDE EDGE)	N.' WESTERLY ±	10.41 FT.
2	SET P.K. NAIL IN CENTER OF PAINTED AERIAL TARGET	N.' EASTERLY ±	(slope) 69.62 FT.
3	N.W.-COR. STORM GRATE RIM. (OUTSIDE EDGE)	S.' EASTERLY ±	29.40 FT.
4	SET RAILROAD SPIKE AT NORTH END OF BRIDGE	S.' EASTERLY ±	37.85 FT.

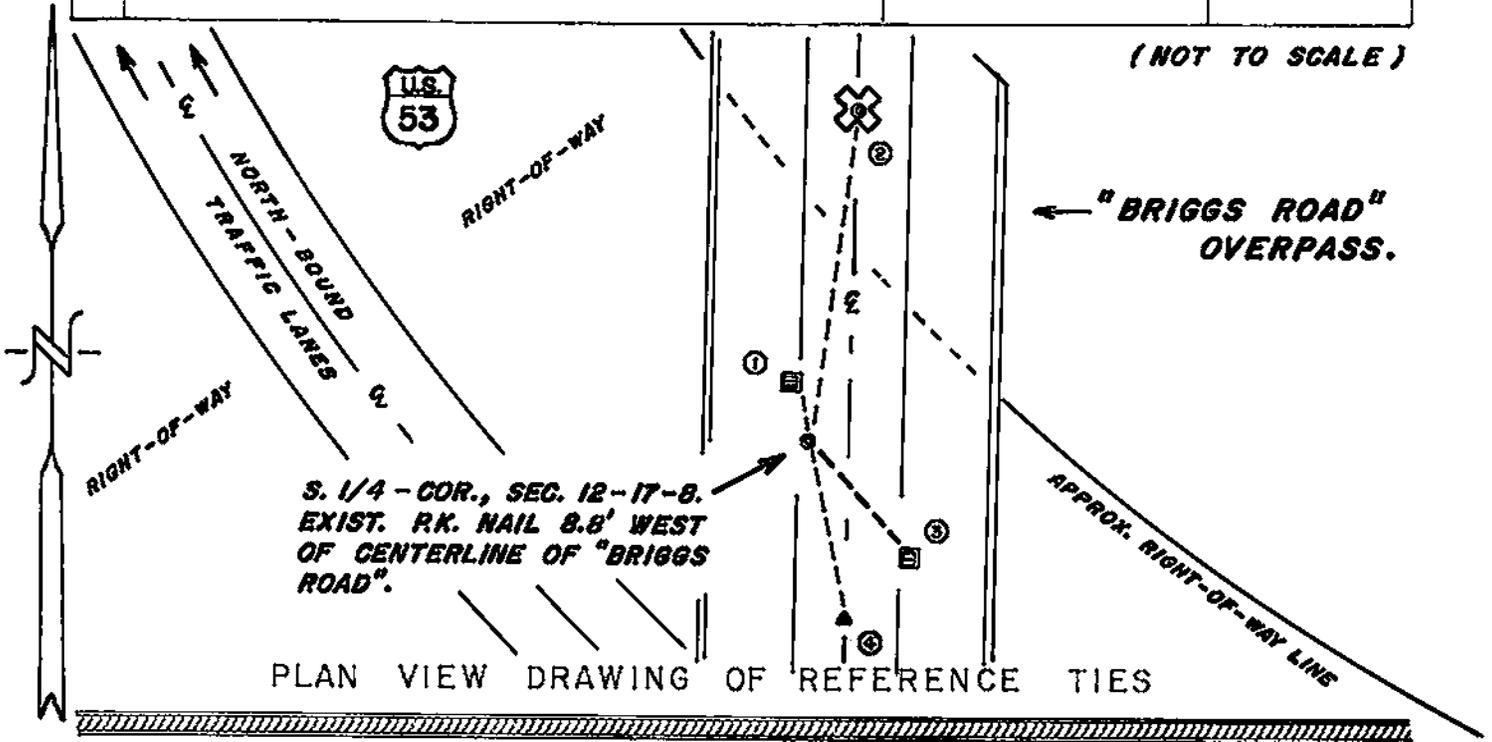


MAP SHOWING DISTANCE AND DIRECTION TO OTHER PUBLIC LAND SURVEY CORNERS USED FOR REESTABLISHING THE CORNER

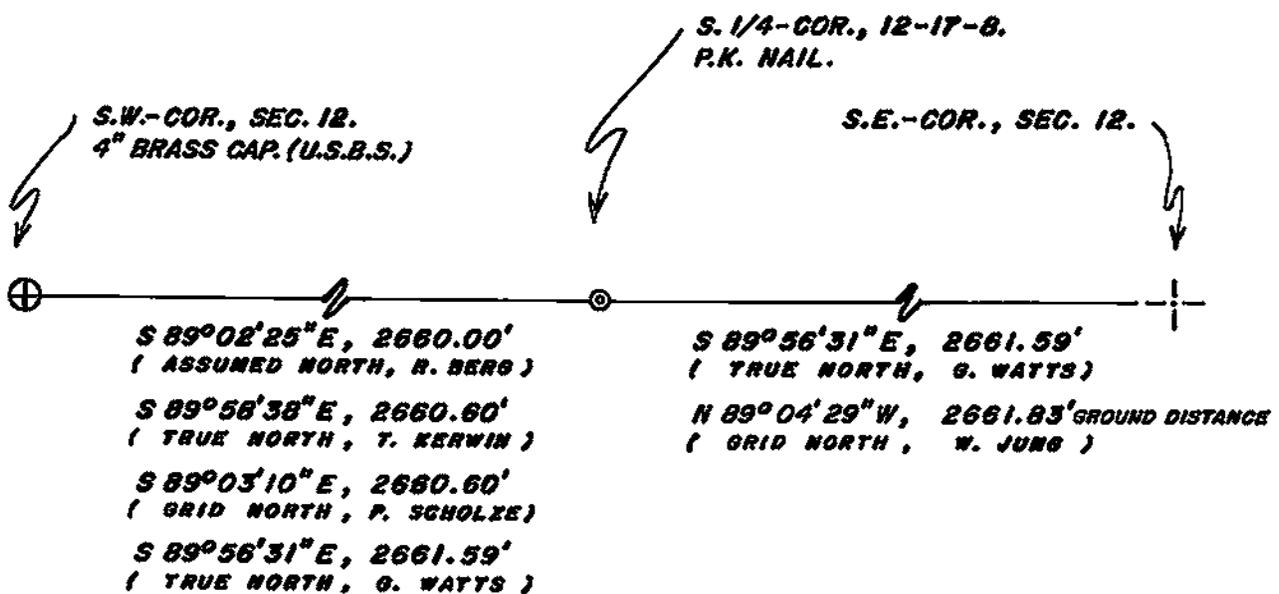

I, WILLIAM C. JUNG, COUNTY SURVEYOR
 HEREBY CERTIFY THAT THE CORNER LOCATION SHOWN ON THIS RECORD
 WAS DETERMINED BY ME OR UNDER MY DIRECTION AND CONTROL AND
 THAT THIS U. S. PUBLIC LAND SURVEY MONUMENT RECORD IS CORRECT
 AND COMPLETE TO THE BEST OF MY KNOWLEDGE AND BELIEF.

William C. Jung 1/20/05
 Signature Date

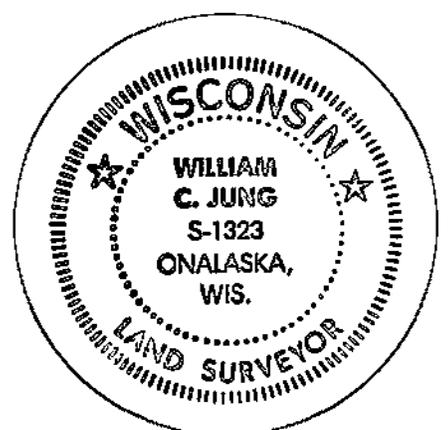

Seal