


21708140000

## U. S. PUBLIC LAND SURVEY MONUMENT RECORD

SECTION 13 T 17 N, R 8 W, TOWN OF Onalaska

LA CROSSE COUNTY

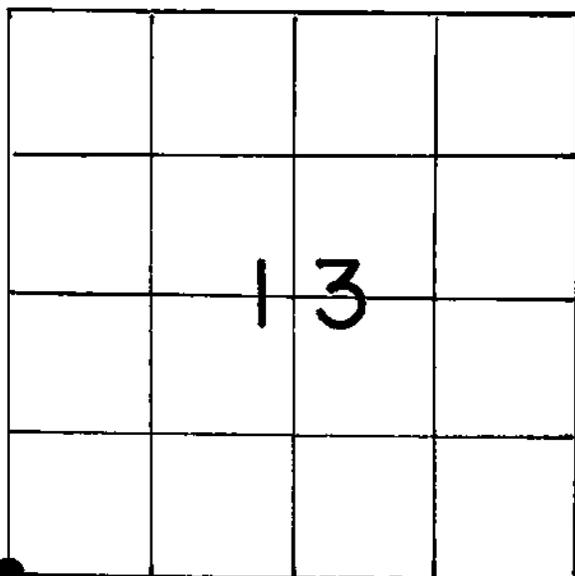

LOCATION OF LANDMARK

Crew: William C. Jung  
Peter Follansbee

Date: 12/8/88

Describe any record evidence, monument evidence, testimonial evidence or any other material evidence you considered and whether the monument was found or restored through acceptance of an obliterated evidence location.

The 1932 Corps of Engineers' notes call for a U.S.B.S. standard concrete monument, was set at this corner in August of 1931.  
that

Follansbee and I dug for and searched extensively for this monument as did Terry Kerwin, RLS. I have come to the conclusion that someone removed this monument. This has happened in other cases. The Corps field notes are quite specific about the location of this monument. I reset the corner following the calls in these notes. I set a 2 $\frac{1}{4}$ "x4'± iron pipe.

Describe or show any material discrepancy between the location of the restored corner and that of the corner previously restored or reestablished.

I found an iron pipe 21.71' to the North. I could not agree to this being the corner. I removed the pipe and replaced it with a rebar. I had found this 1 $\frac{1}{4}$ " rebar 10.32' to the S-SW and had removed it. It was not of record. If it was also intended to be the corner, I could not agree with it either.

WISCONSIN COORDINATE SYSTEM

North

East

Theta Angle

Horiz. Order

Vert. Order

TYPE OF LANDMARK


2 $\frac{1}{4}$ " iron pipe

BEARINGS ARE REFERENCED TO


Assumed

RECORD OF DURABLE WITNESS MONUMENTS

NO	DESCRIPTION	BEARING	DISTANCE
1	P.K. in 5" single blazed bearing tree	Mag.= N76°E	18.82
2	Replaced pipe with 1 1/4" rebar, flush	North±	21.71
3	Remnants of old rotted wood fence post	Mag.= N9°E	20.4
4			

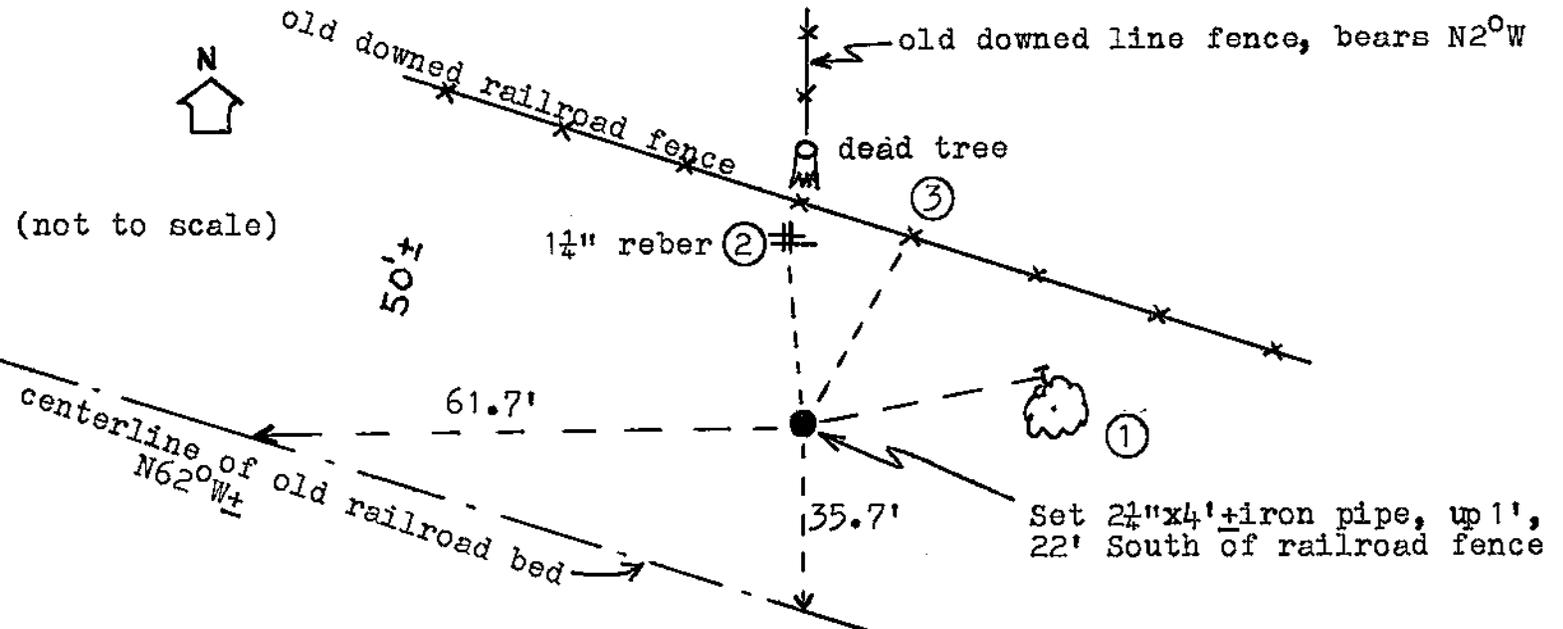


MAP SHOWING DISTANCE AND DIRECTION TO OTHER PUBLIC LAND SURVEY CORNERS USED FOR REESTABLISHING THE CORNER  
(not to scale)

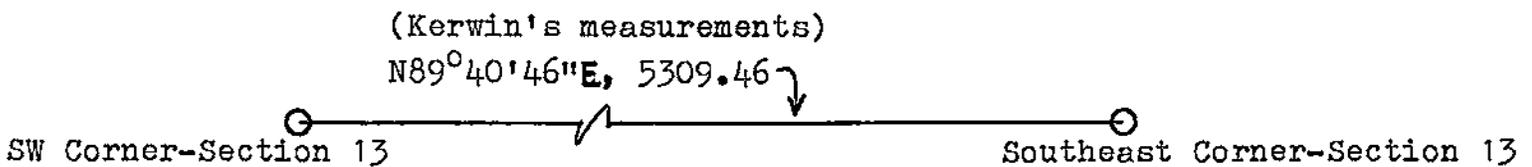

I, William C. Jung, Deputy County Surveyor,  
HEREBY CERTIFY THAT THE CORNER LOCATION SHOWN ON THIS RECORD WAS DETERMINED BY ME OR UNDER MY DIRECTION AND CONTROL AND THAT THIS U. S. PUBLIC LAND SURVEY MONUMENT RECORD IS CORRECT AND COMPLETE TO THE BEST OF MY KNOWLEDGE AND BELIEF.

William C. Jung  
Signature

1/17/89  
Date

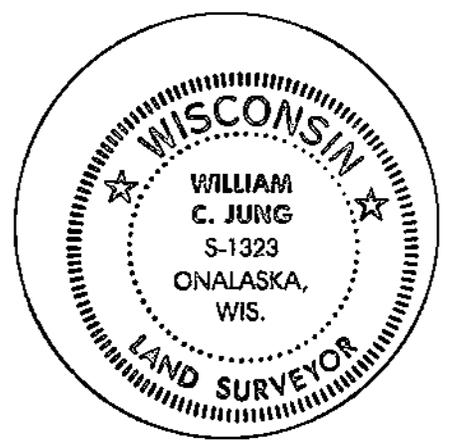

Seal