


21708150000

U. S. PUBLIC LAND SURVEY MONUMENT RECORD

SECTION 15 T 17 N, R 8 W, TOWN OF ONALASKA

LA CROSSE COUNTY

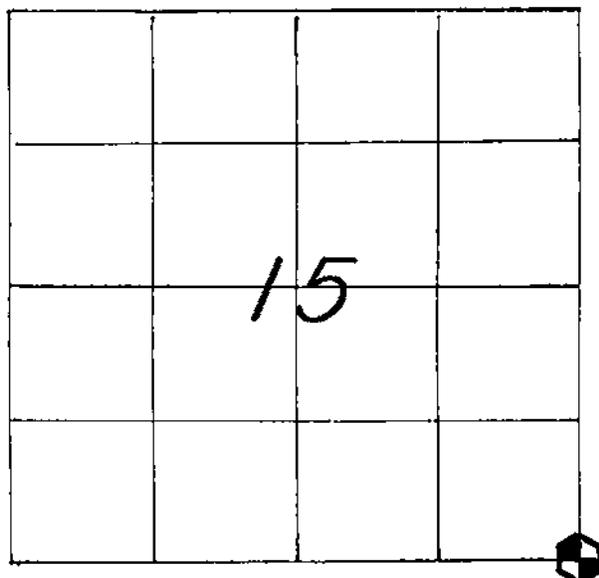

LOCATION OF LANDMARK

CREW: WILLIAM C. JUNG
 PETER F. FOLLANSBEE
 DATE: 3/23/1998

WISCONSIN COORDINATE SYSTEM

North

East

Theta Angle

Horiz. Order

Vert. Order

TYPE OF LANDMARK

BRASS CAP LUNDE MARKER

BEARINGS ARE REFERENCED TO

ASSUMED NORTH.

Describe any record evidence, monument evidence, testimonial evidence or any other material evidence you considered and whether the monument was found or restored through acceptance of an obliterated evidence location.

I found a pipe at the old occupied fence corner that had been used as the corner in several previous surveys. I accepted this location as the best available evidence of the original government corner position and replaced the pipe with a brass capped Lunde marker.


Describe or show any material discrepancy between the location of the restored corner and that of the corner previously restored or reestablished.

NONE KNOWN.

RECORD OF DURABLE WITNESS MONUMENTS

ASSUMED


NO	DESCRIPTION	BEARING	DISTANCE
1	EXISTING 1-3/4" IRON PIPE(O.D.)	N 89°27'24" W	239.94 FT.
2	EXISTING 1-3/4" IRON PIPE(O.D.)	N 48°10'18" W	319.31 FT.
3	EXISTING 5/8" ROUND IRON BAR	N 00°07'13" E	211.11 FT.
4	SET A NAIL IN S-SIDE 28" BURR OAK (UNBLAZED)	EAST ± (MAG.)	51.72 FT.

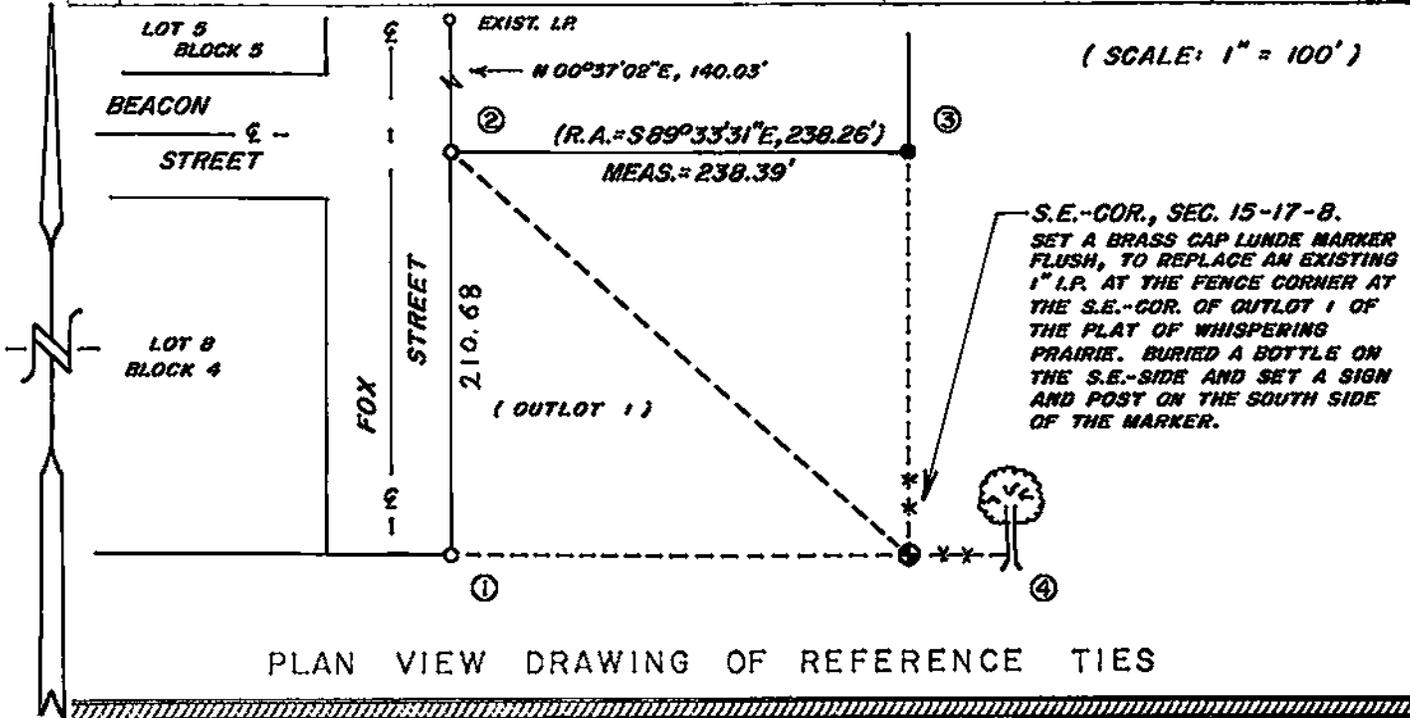

PLAN VIEW DRAWING OF REFERENCE TIES

MAP SHOWING DISTANCE AND DIRECTION TO OTHER PUBLIC LAND SURVEY CORNERS USED FOR REESTABLISHING THE CORNER

I made no section measurements at this time. The location of this corner had been confirmed through previous survey work by others.

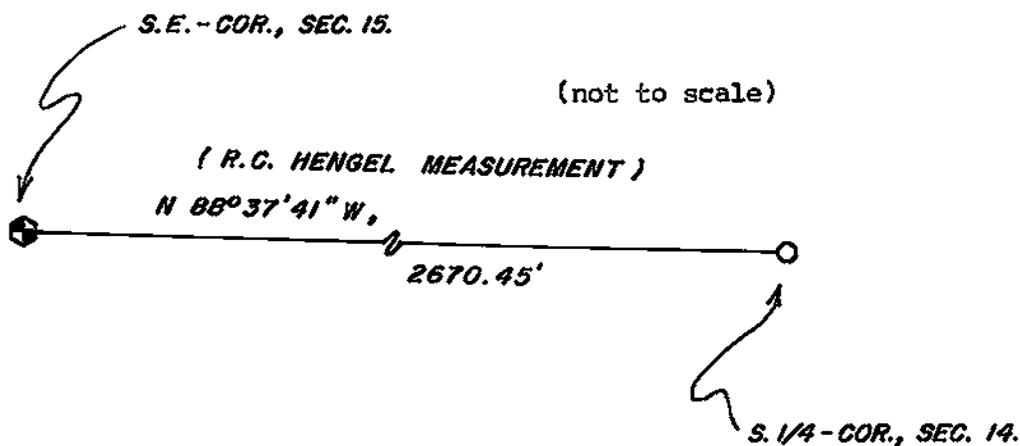

I, WILLIAM C. JUNG, COUNTY SURVEYOR
HEREBY CERTIFY THAT THE CORNER LOCATION SHOWN ON THIS RECORD WAS DETERMINED BY ME OR UNDER MY DIRECTION AND CONTROL AND THAT THIS U. S. PUBLIC LAND SURVEY MONUMENT RECORD IS CORRECT AND COMPLETE TO THE BEST OF MY KNOWLEDGE AND BELIEF.

William C. Jung Signature
October 28, 1998 Date



Seal