


21708150020

## U. S. PUBLIC LAND SURVEY MONUMENT RECORD

SECTION 15 T 17 N, R 8 W, TOWN OF ONALASKA

LA CROSSE COUNTY

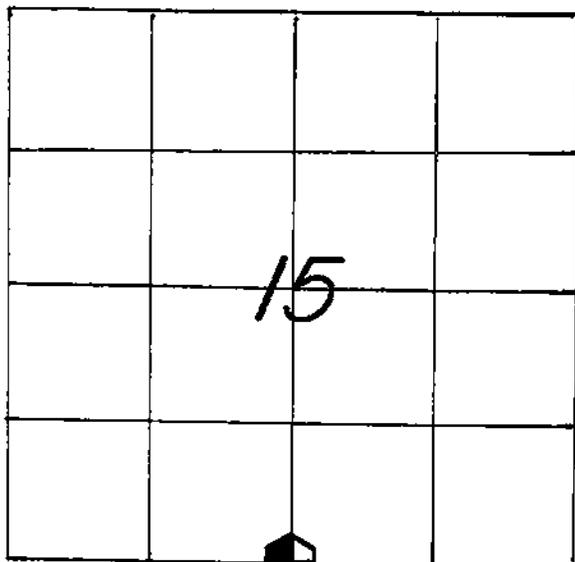

LOCATION OF LANDMARK

CREW: WILLIAM C. JUNG  
 PETER F. FOLLANSBEE  
 DATE: 6/25/2008

WISCONSIN COORDINATE SYSTEM	
North	710,269.480
East	1,620,658.561
Theta Angle	
Horiz. Order	
Vert. Order	
DATUM:	1983('91)
TYPE OF LANDMARK	
BRASS CAP LUNDE MARKER.	
BEARINGS ARE REFERENCED TO	
GRID NORTH AS PER SECTION DATA.	

Describe any record evidence, monument evidence, testimonial evidence or any other material evidence you considered and whether the monument was found or restored through acceptance of an obliterated evidence location.


There was a stone at this corner. I believe that it was knocked out or destroyed when the driveway and culvert were put in. I set the Lunde marker at the location of the old stone. The stone is of record and shows up first (with our surviving records) in the 1932 Corps notes.

Describe or show any material discrepancy between the location of the restored corner and that of the corner previously restored or reestablished.

**NONE KNOWN.**


RECORD OF DURABLE WITNESS MONUMENTS

NO	DESCRIPTION	BEARING	DISTANCE
1	EX. 1" O.D. IRON PIPE SOUTHEAST OF A FENCE CORNER	N.-WESTERLY ±	72.72 FT.
2	SET A R.K. NAIL IN S.-SIDE OF WEST TRUNK OF LOGUST	EAST ±	110.44 FT.
3	EX. BRASS CAP CORPS. MARKER ON FLOWAGE LINE(L-79)	S 02°14'55"E ASSUMED	453.25 FT.
4	EX. BRASS CAP CORPS. MARKER ON FLOWAGE LINE(L-80)	S 88°02'35"W ASSUMED	470.07 FT.

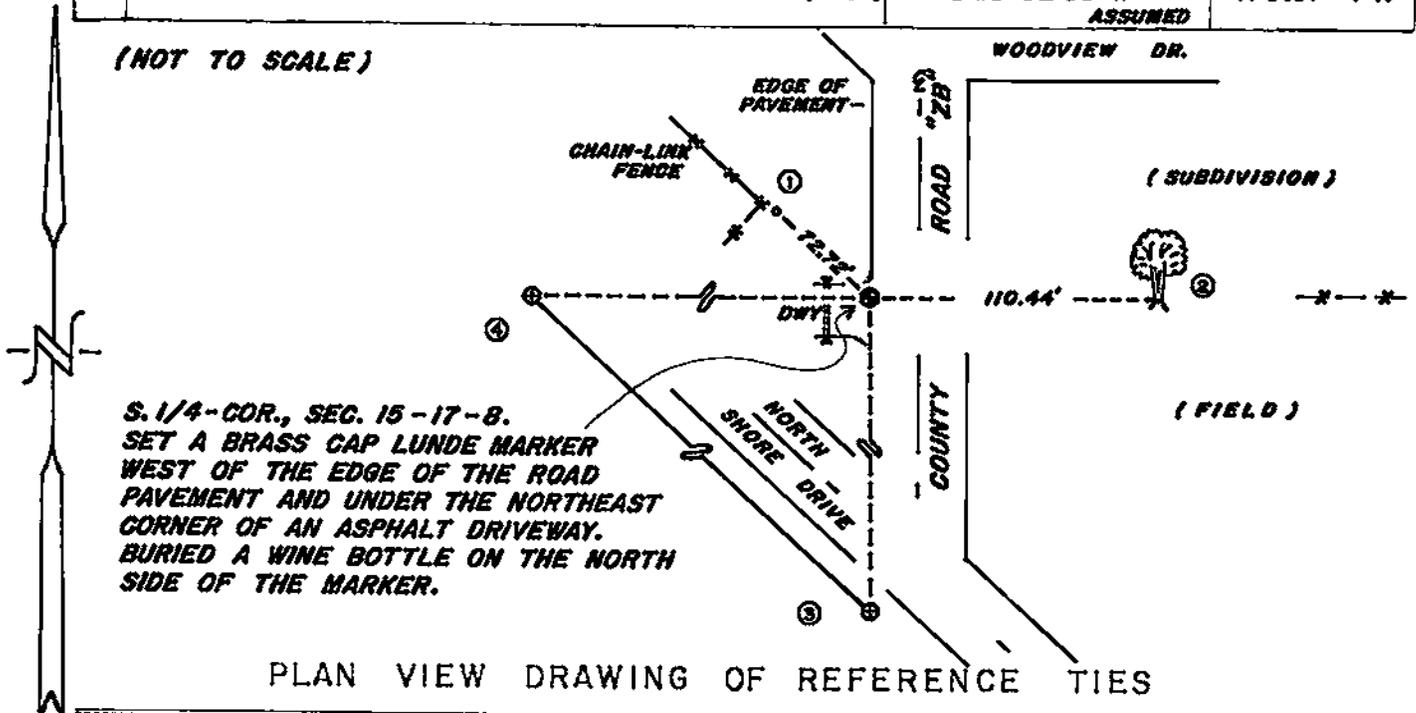

MAP SHOWING DISTANCE AND DIRECTION TO OTHER PUBLIC LAND SURVEY CORNERS USED FOR REESTABLISHING THE CORNER

(GRID BEARINGS AND DISTANCES)  
(GRID FACTOR: 0.999948)  
(NOT TO SCALE)

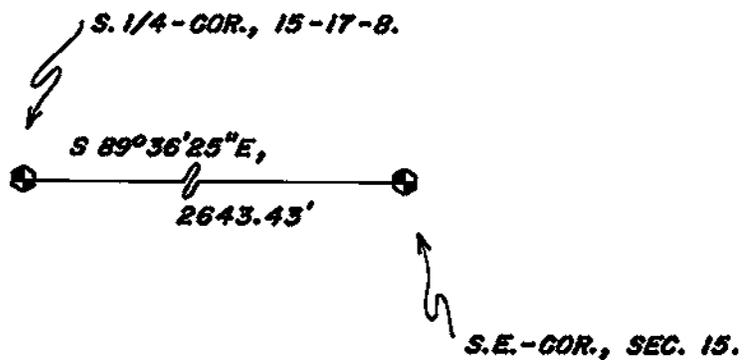

I, WILLIAM C. JUNG, COUNTY SURVEYOR  
HEREBY CERTIFY THAT THE CORNER LOCATION SHOWN ON THIS RECORD WAS DETERMINED BY ME OR UNDER MY DIRECTION AND CONTROL AND THAT THIS U. S. PUBLIC LAND SURVEY MONUMENT RECORD IS CORRECT AND COMPLETE TO THE BEST OF MY KNOWLEDGE AND BELIEF.

William C. Jung                      10/31/08  
Signature                                      Date



Seal