


21708152000

U. S. PUBLIC LAND SURVEY MONUMENT RECORD

SECTION 14 T 17 N, R 8 W, TOWN OF ONALASKA

LA CROSSE COUNTY

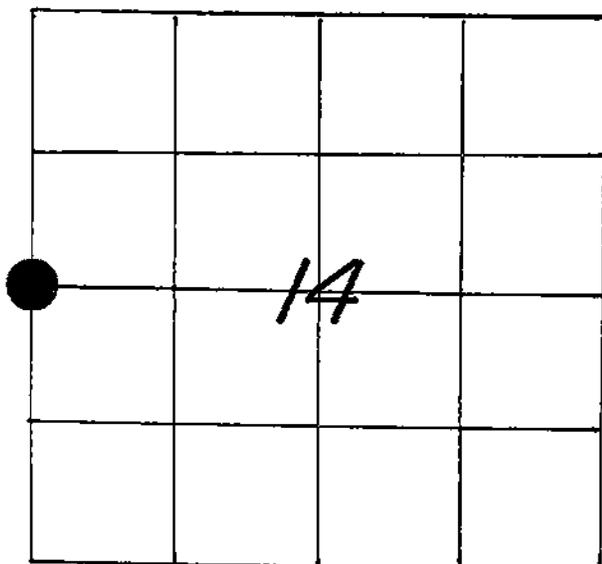

WISCONSIN COORDINATE SYSTEM

North

East

Theta Angle

Horiz. Order

Vert. Order

TYPE OF LANDMARK

1/4" REBAR BURIED IN AN EMBANKMENT.

BEARINGS ARE REFERENCED TO

TRUE NORTH AS PER SECTION DATA.

LOCATION OF LANDMARK

CREW: WILLIAM G. JUNG
 PETER F. FOLLANSBEE
 DATE: 5/19/2005

Describe any record evidence, monument evidence, testimonial evidence or any other material evidence you considered and whether the monument was found or restored through acceptance of an obliterated evidence location.


The iron pipe set here in 1932 was apparently knocked out. Paul Fairchild set an iron bar at this corner last April. We found and tied off his bar. After discussing this corner with Paul, I agree with his placement of the bar.

Describe or show any material discrepancy between the location of the restored corner and that of the corner previously restored or reestablished.


NONE KNOWN.

RECORD OF DURABLE WITNESS MONUMENTS

NO	DESCRIPTION	MAGNETIC	
		BEARING	DISTANCE
1	SET A NAIL IN N.E.-SIDE OF AN 18" UNBLAZED OAK	N 16° W	5.33 FT.
2	SET A NAIL IN S.W.-SIDE OF A 3-1/2" UNBLAZED OAK	S 81° E	23.59 FT.
3	SET A 3/4" x 30" IRON BAR WITH A RED PLASTIC CAP	S 10° E	59.58 FT.
4	SET A 3/4" x 30" IRON BAR WITH A RED PLASTIC CAP	S 35° W	38.69 FT.

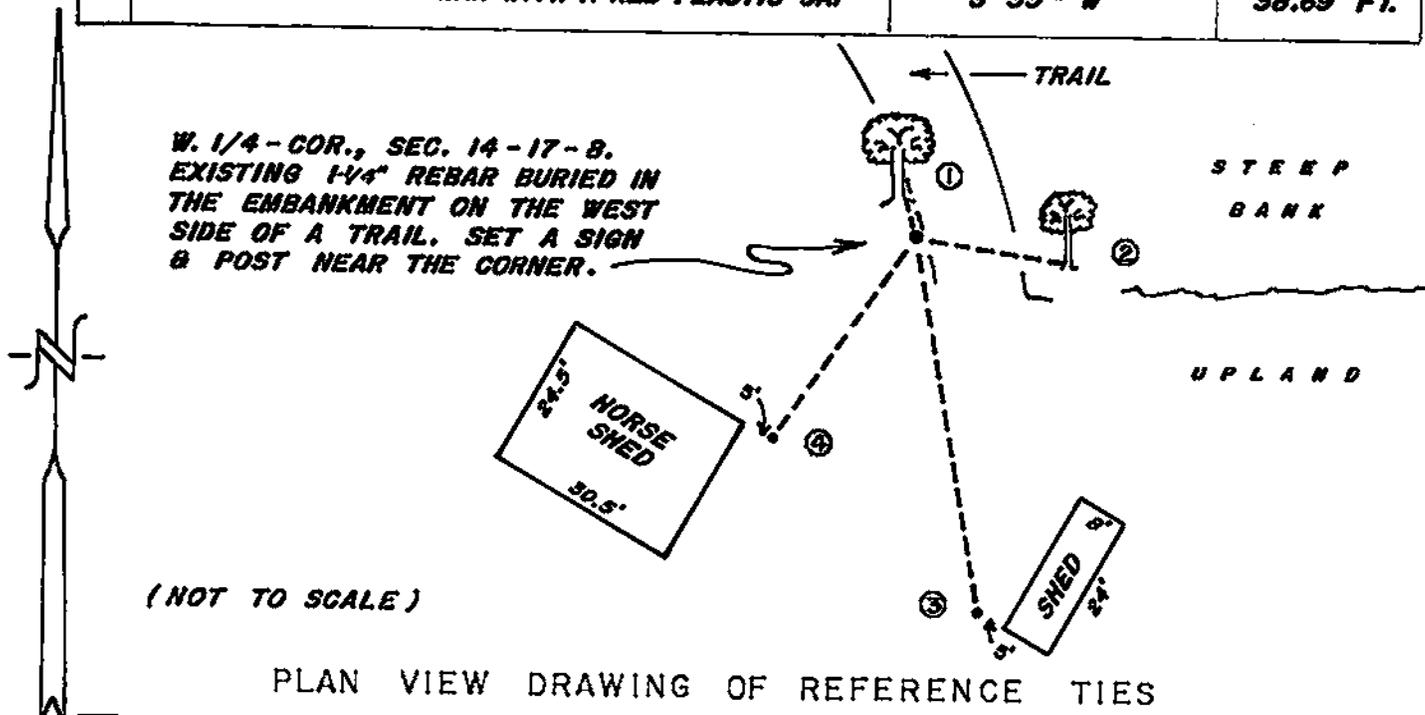

MAP SHOWING DISTANCE AND DIRECTION TO OTHER PUBLIC LAND SURVEY CORNERS USED FOR REESTABLISHING THE CORNER

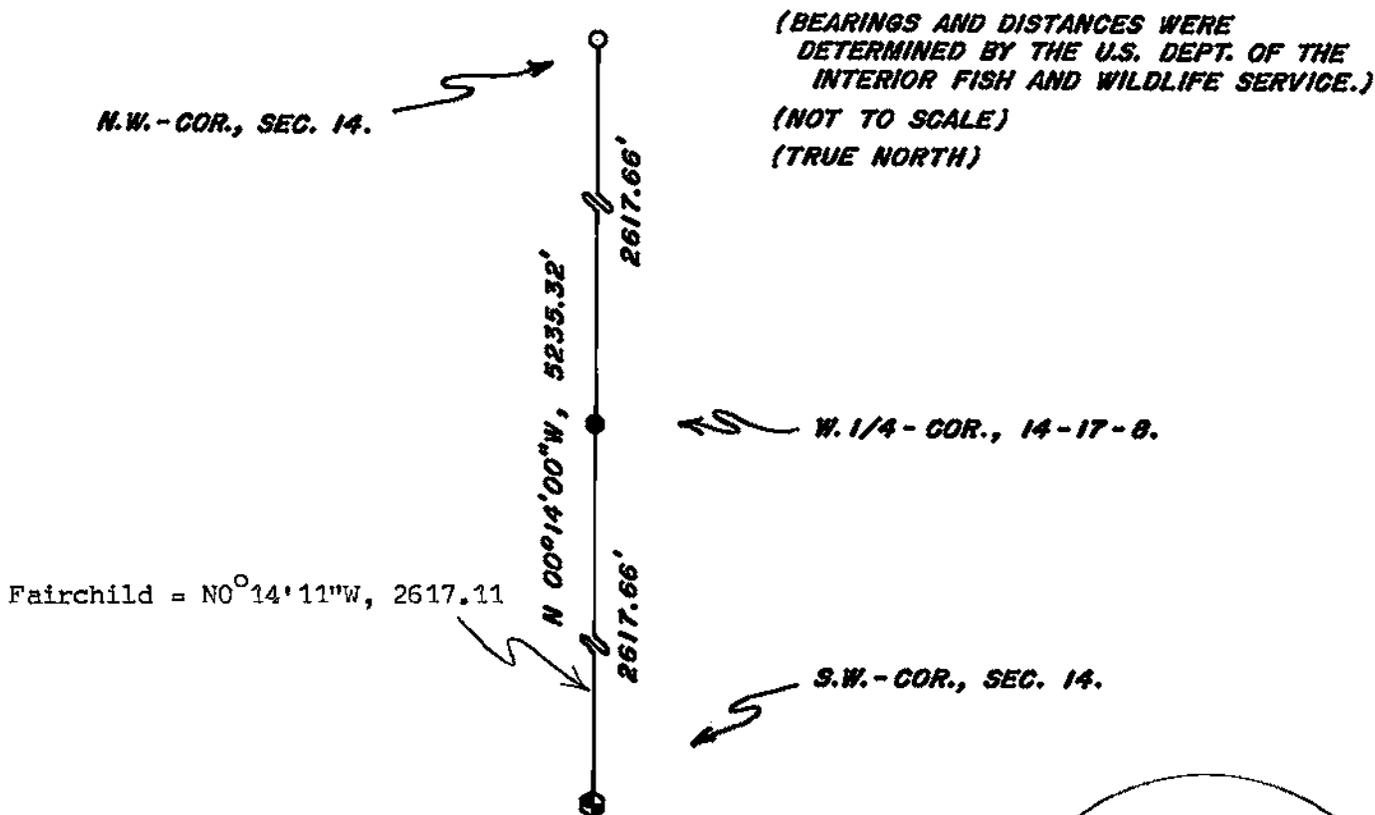

I, WILLIAM C. JUNG, COUNTY SURVEYOR
HEREBY CERTIFY THAT THE CORNER LOCATION SHOWN ON THIS RECORD WAS DETERMINED BY ME OR UNDER MY DIRECTION AND CONTROL AND THAT THIS U. S. PUBLIC LAND SURVEY MONUMENT RECORD IS CORRECT AND COMPLETE TO THE BEST OF MY KNOWLEDGE AND BELIEF.

William C. Jung 11/18/05
Signature Date

