


21708230000

## U. S. PUBLIC LAND SURVEY MONUMENT RECORD

SECTION 24 T 17 N, R 8 W, TOWN OF ONALASKA

LA CROSSE COUNTY

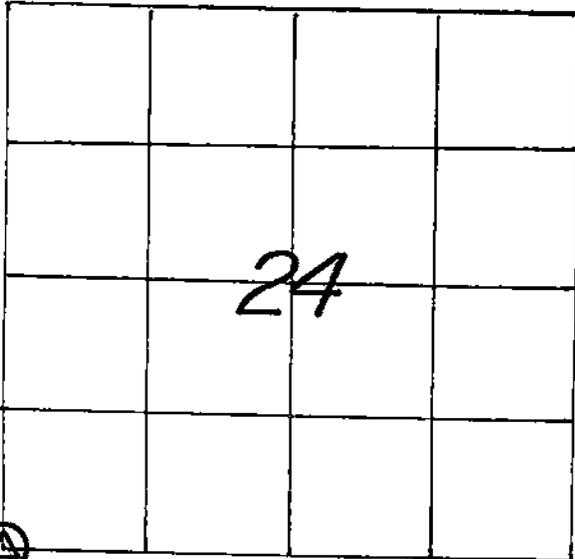

LOCATION OF LANDMARK

CREW: WILLIAM C. JUNG  
 PETER F. FOLLANSBEE  
 DATE: 8/19/2005

WISCONSIN COORDINATE SYSTEM

North 704,864.835

East 1,628,575.745

Theta Angle

Horiz. Order

Vert. Order

1983(91)

TYPE OF LANDMARK

3/4" BRASS CAP CORPS MARKER.

BEARINGS ARE REFERENCED TO

GRID NORTH AS PER SECTION DATA.

Describe any record evidence, monument evidence, testimonial evidence or any other material evidence you considered and whether the monument was found or restored through acceptance of an obliterated evidence location.


I found the Corps marker as noted on Graham's 1985 tie sheet and made new ties.

Describe or show any material discrepancy between the location of the restored corner and that of the corner previously restored or reestablished.

NONE KNOWN.


RECORD OF DURABLE WITNESS MONUMENTS

NO	DESCRIPTION	BEARING	DISTANCE
1	SET A 3/4" x 30" IRON BAR WITH A RED PLASTIC CAP	WEST ±	30.43 FT.
2	SET A 3/4" x 30" IRON BAR WITH A RED PLASTIC CAP	NORTH ±	29.17 FT.
3	SET A 3/4" x 30" IRON BAR WITH A RED PLASTIC CAP	EAST ±	30.18 FT.
4	SET A 3/4" x 30" IRON BAR WITH A RED PLASTIC CAP	SOUTH ±	29.79 FT.

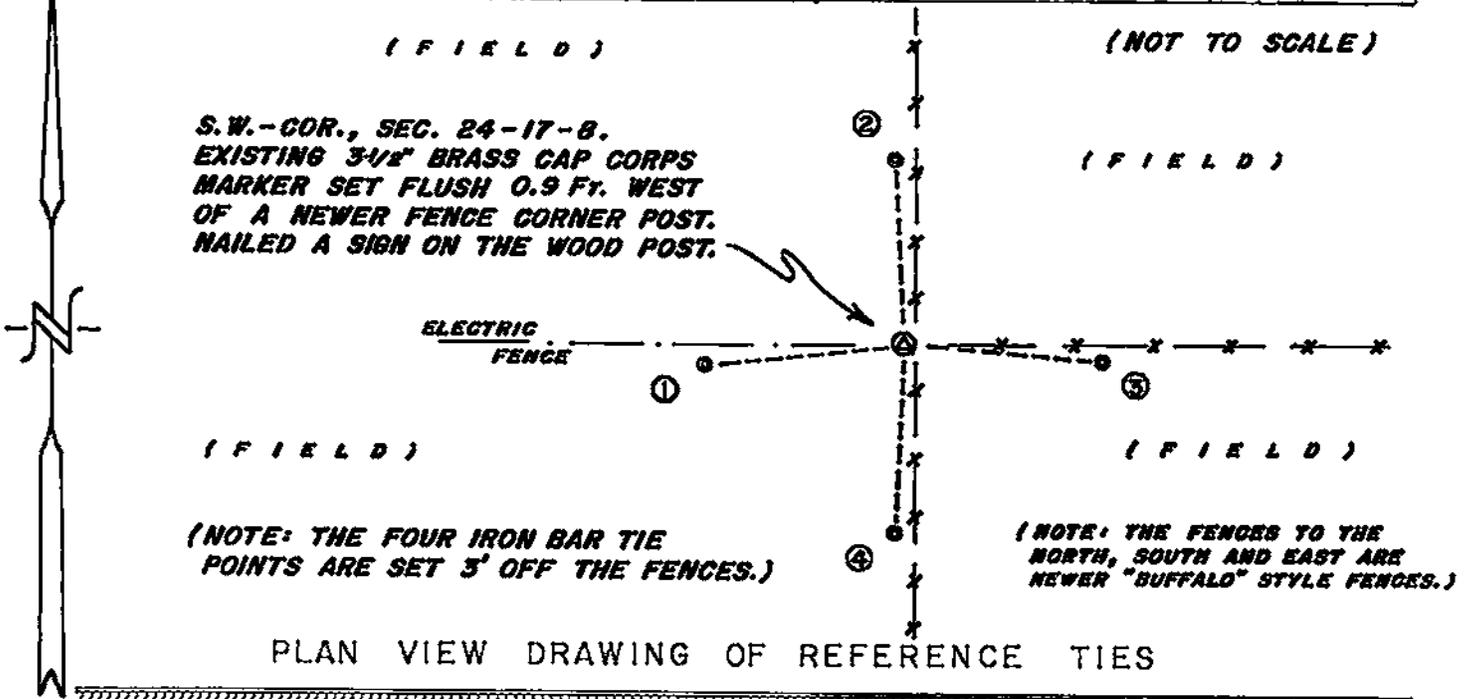

MAP SHOWING DISTANCE AND DIRECTION TO OTHER PUBLIC LAND SURVEY CORNERS USED FOR REESTABLISHING THE CORNER

(GRID BEARINGS AND DISTANCES)  
(GRID FACTOR: 0.99994797)  
(NOT TO SCALE)

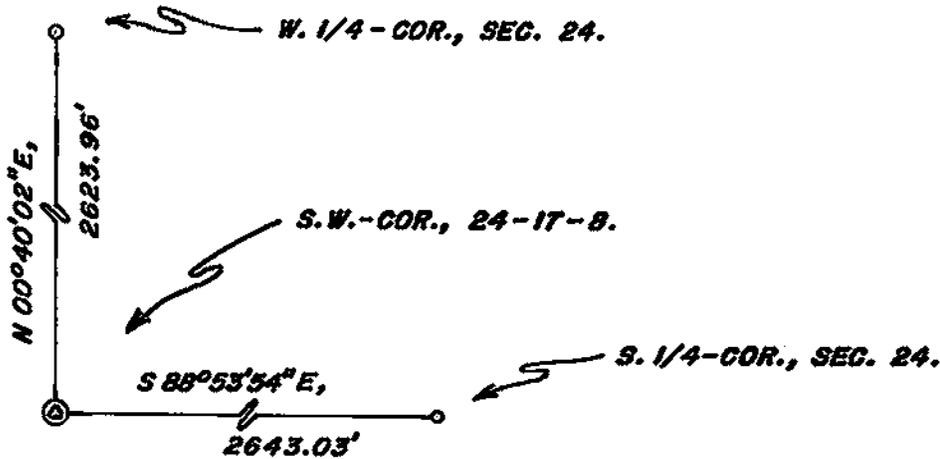

I, WILLIAM C. JUNG, COUNTY SURVEYOR  
HEREBY CERTIFY THAT THE CORNER LOCATION SHOWN ON THIS RECORD  
WAS DETERMINED BY ME OR UNDER MY DIRECTION AND CONTROL AND  
THAT THIS U. S. PUBLIC LAND SURVEY MONUMENT RECORD IS CORRECT  
AND COMPLETE TO THE BEST OF MY KNOWLEDGE AND BELIEF.

William C. Jung 11/18/05  
Signature Date




Seal

U. S. PUBLIC LAND SURVEY MONUMENT RECORD

INSTRUCTIONS: This record shall show the location of the corner and shall include all of the following nine elements (a through i).

- (a) Identify the corner by reference to the U.S. public land survey system.
- = Corner monument restored.

NE. CORNER, SEC. 26,  
T. 17 N., R. 2 W.,  
4TH P.M.,  
LA CROSSE COUNTY, WISC.

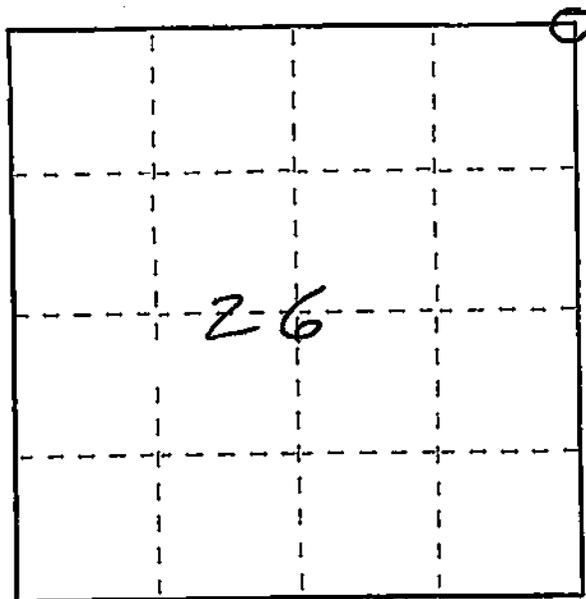


- (b) Describe any record evidence, monument evidence, occupational evidence, testimonial evidence or any other material evidence you considered, and whether the monument was found or placed.

SET IN CORRELATION WITH E 1/4 COR., SEC. 23, & 1/16<sup>TH</sup> COR. ON E. LINE OF SE 1/4, SEC. 23, PER TRANE Co. SURVEY MONUMENTS, AT LOCATION INDICATED BY MR. PEDRATTI, ADJOINING OWNER, AS BEING THE LOCATION OF A U.S.B.S. MONUMENT FOR THE CORNER, SAID U.S.B.S. MONUMENT AS NOTED IN U.S. FISH & WILDLIFE SERVICE MEMO TO U.S. ARMY CORPS OF ENGINEERS IN 1930, AND LOCATED IN SUBSEQUENT C.O.F.E 1931 SURVEY.

- (c) In the plan view drawing below, provide reference ties to at least 4 witness monuments, or, if the location is within a municipality, to at least 2 witness monuments. (Witness monuments shall be made of concrete, natural stone, iron or other equally durable material.) Describe witness monuments.

- (d) Show a plan view drawing depicting the relevant monuments and reference ties which is sufficient in detail to enable accurate relocation of the corner monument if the corner monument is disturbed. Indicate north.

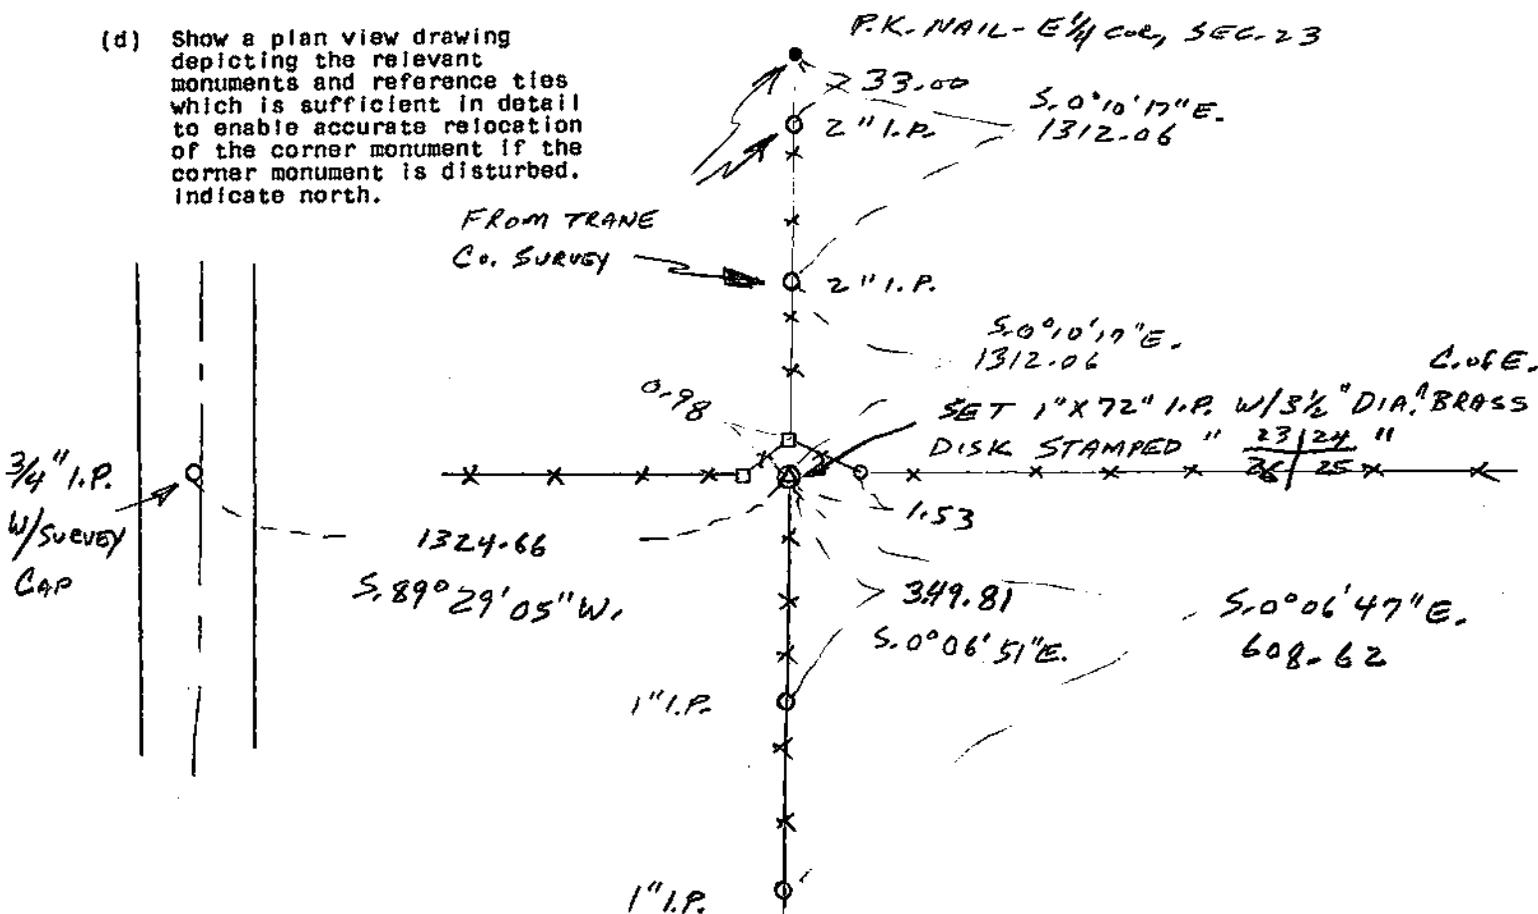

(e) Describe any material discrepancy between the location of the corner as restored or reestablished and the location of that corner as previously restored or reestablished by distance and direction. Show the discrepancy on the plan view drawing under (d), above. Show the distances between the corner as previously restored or reestablished and (1) the corner as restored or reestablished, and (2) to at least 2 of the witness monuments shown on the drawing in (d), above.


NONE

(f) Was the corner restored through acceptance of (1) an obliterated evidence location, or, (2) a found perpetuated location?

WITH TWO WRITTEN AND ONE TESTIMONIAL LOCATION DESCRIPTIONS, ALL MATCHING BOTH RECENT AND HISTORIC SURVEYS, I BELIEVE THIS QUALIFIES AS A FOUND PERPETUATED LOCATION - THE U.S.B.S. CONG. MON. WAS <sup>ONLY</sup> RECENTLY REMOVED.

(g&h) Was the corner reestablished through lost corner proportionate methods? If so, show the method, including the directions and distances to other public land survey corners used as evidence or used for proportioning in determining the corner location?

No.

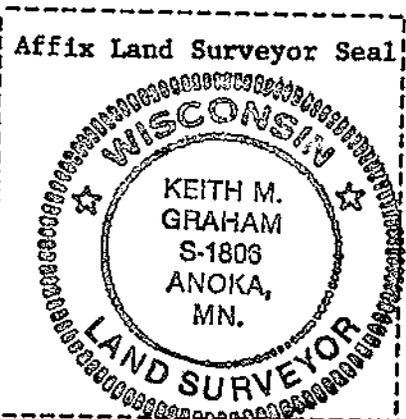

(1) I, KEITH M. GRAHAM  
(type or print name) certify that the corner location shown on this record was determined by me or under my direction and control and that this U.S. Public Land Survey Monument Record is correct and complete to the best of my knowledge and belief.

Keith M. Graham 1/25/85  
Signature Date