


21708232000

U. S. PUBLIC LAND SURVEY MONUMENT RECORD

SECTION 23 T 17 N, R 8 W, TOWN OF ONALASKA
 LA CROSSE COUNTY

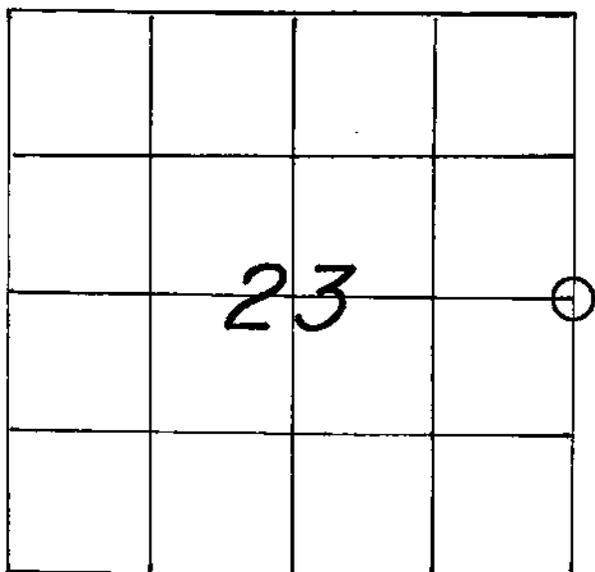

WISCONSIN COORDINATE SYSTEM
North
East
Theta Angle
Horiz. Order
Vert. Order
TYPE OF LANDMARK
Set 1" x 30" IRON PIPE.
BEARINGS ARE REFERENCED TO

LOCATION OF LANDMARK

Crew: WILLIAM C. JUNG
 PETER F. FOLLANSBEE
 Date: 6/17/1996

Describe any record evidence, monument evidence, testimonial evidence or any other material evidence you considered and whether the monument was found or restored through acceptance of an obliterated evidence location.

I found at the corner a P.K. nail that had been used as the corner in several previous surveys. This P.K. also fits the occupied conditions. I accepted this location as the best available evidence of the original government corner position and drove an iron pipe over the P.K. nail.


Describe or show any material discrepancy between the location of the restored corner and that of the corner previously restored or reestablished.

NONE KNOWN.

RECORD OF DURABLE WITNESS MONUMENTS

NO	DESCRIPTION	BEARING	DISTANCE
1	Set 1" x 20½" I.P. 3.5' N. of pavement	Northwesterly±	19.61 Ft.
2	Set 1-¾"x 19" I.P. 3.5' N. of pave't	Northeasterly±	19.40 Ft.
3	Set ½" x 14½" I.B. 2' S. of pavement	Southeasterly±	34.30 Ft.
4	Ex. 1-¾" I.P.(set sign & post to east)	South ±	28.84 Ft.

(Not to scale)

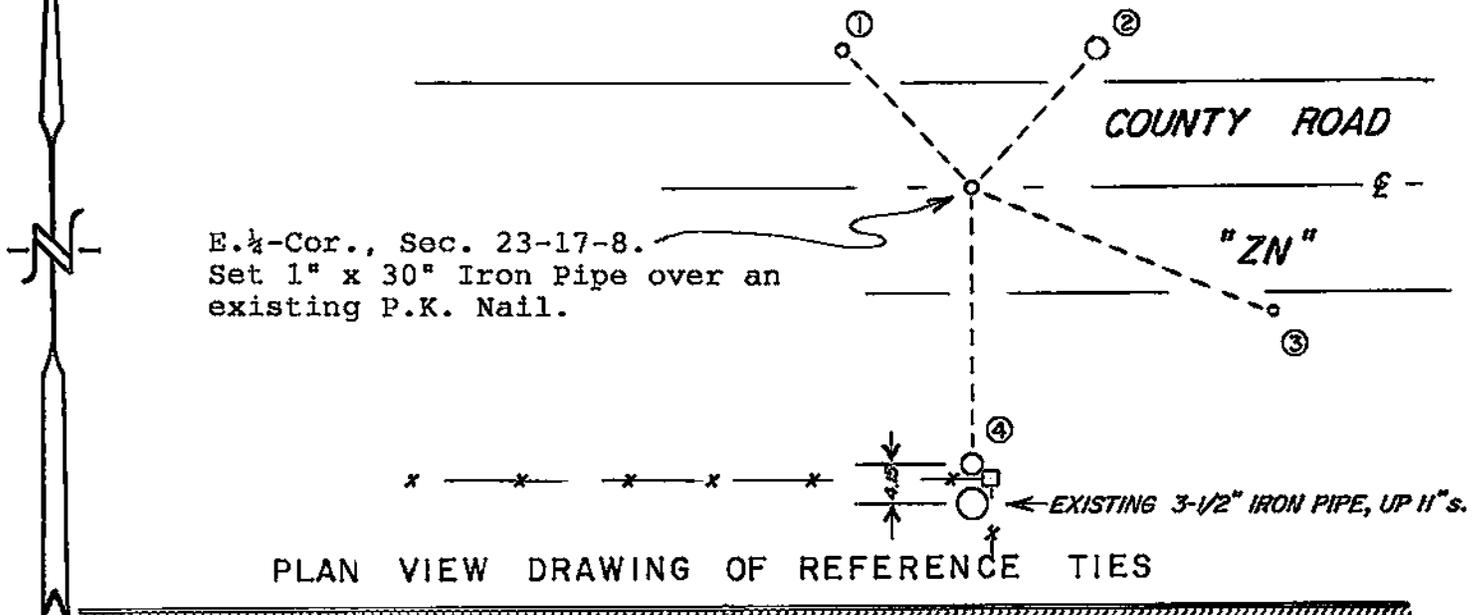

PLAN VIEW DRAWING OF REFERENCE TIES


MAP SHOWING DISTANCE AND DIRECTION TO OTHER PUBLIC LAND SURVEY CORNERS USED FOR REESTABLISHING THE CORNER

No section measurements were made by me at this time. The location of this corner was confirmed through previous survey work.

I, William C. Jung, County Surveyor
 HEREBY CERTIFY THAT THE CORNER LOCATION SHOWN ON THIS RECORD
 WAS DETERMINED BY ME OR UNDER MY DIRECTION AND CONTROL AND
 THAT THIS U. S. PUBLIC LAND SURVEY MONUMENT RECORD IS CORRECT
 AND COMPLETE TO THE BEST OF MY KNOWLEDGE AND BELIEF

William C. Jung
 Signature

12/4/96
 Date

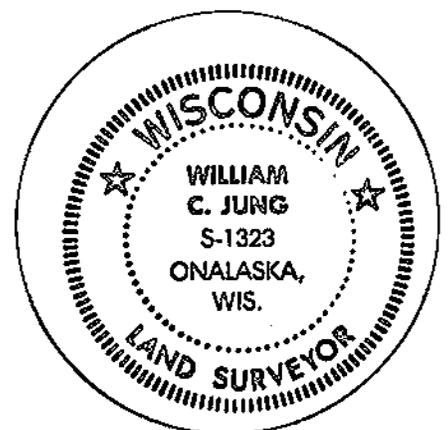

Seal


U. S. PUBLIC LAND SURVEY MONUMENT RECORD

INSTRUCTIONS: This record shall show the location of the corner and shall include all of the following nine elements (a through i).

(a) Identify the corner by reference to the U.S. public land survey system.

O = Corner monument restored.

E 1/4 COR., SEC. 23,
T. 17 N., R. 8 W.,
4TH P.M.,
LACROSSE COUNTY.

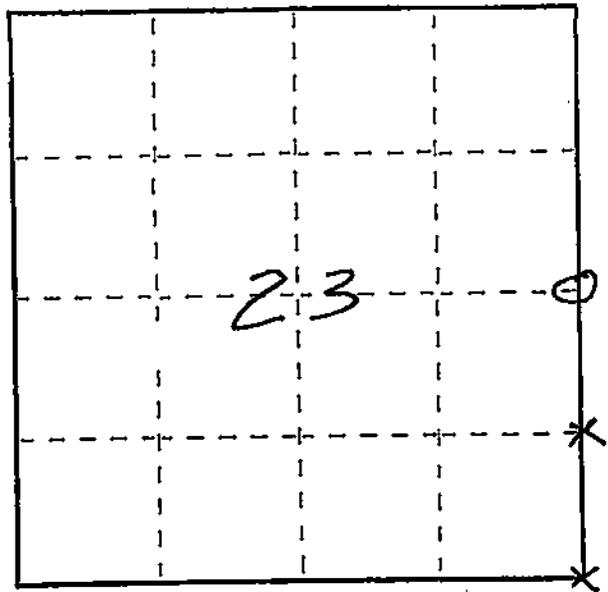


(b) Describe any record evidence, monument evidence, occupational evidence, testimonial evidence or any other material evidence you considered, and whether the monument was found or placed.

FOUND P.K. Nail on \ominus IDENTIFIED AS 1/4 CORNER USED IN TRANE CO. SURVEY BY ADJACENT OWNER, MR. PEDRATTI, WHO ALSO POINTED OUT 1/16th CORNER ONE, LINE OF SE COR., & FORMER LOCATION OF U.S.B.S. CONC. MON. AT SE CORNER OF SEC. 23. SURVEY DATA AGREES WITH THIS.

(c) In the plan view drawing below, provide reference ties to at least 4 witness monuments, or, if the location is within a municipality, to at least 2 witness monuments. (Witness monuments shall be made of concrete, natural stone, iron or other equally durable material.) Describe witness monuments.

(d) Show a plan view drawing depicting the relevant monuments and reference ties which is sufficient in detail to enable accurate relocation of the corner monument if the corner monument is disturbed. Indicate north.

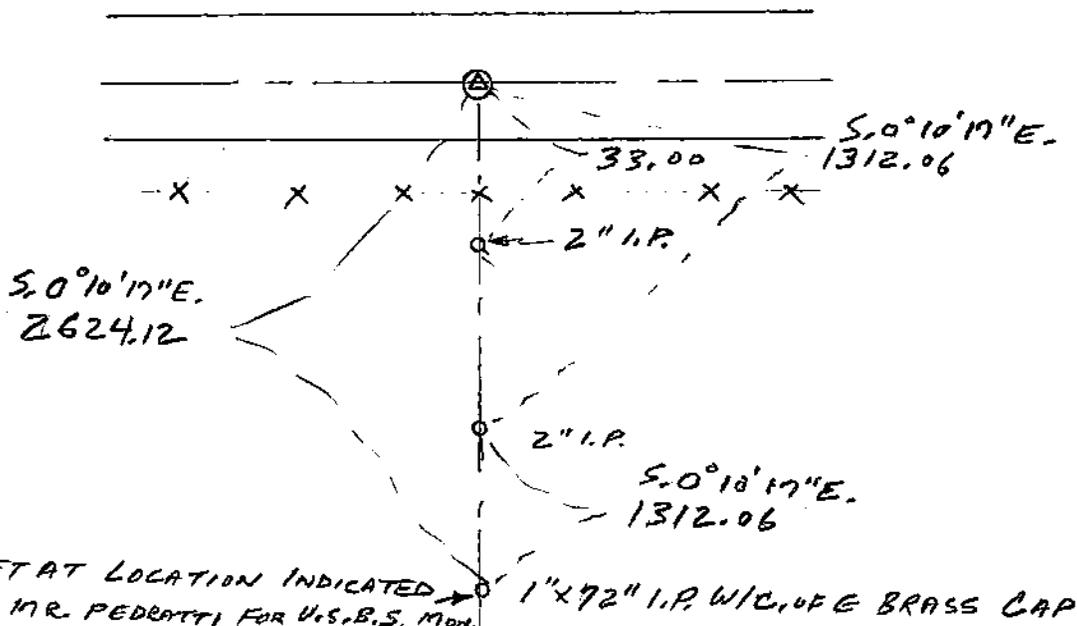

(e) Describe any material discrepancy between the location of the corner as restored or reestablished and the location of that corner as previously restored or reestablished by distance and direction. Show the discrepancy on the plan view drawing under (d), above. Show the distances between the corner as previously restored or reestablished and (1) the corner as restored or reestablished, and (2) to at least 2 of the witness monuments shown on the drawing in (d), above.


NONE

(f) Was the corner restored through acceptance of (1) an obliterated evidence location, or, (2) a found perpetuated location?

(g&h) Was the corner reestablished through lost corner proportionate methods? If so, show the method, including the directions and distances to other public land survey corners used as evidence or used for proportioning in determining the corner location?

No.

(i) I, KEITH M. GRAHAM
(type or print name) certify that the corner location shown on this record was determined by me or under my direction and control and that this U.S. Public Land Survey Monument Record is correct and complete to the best of my knowledge and belief.

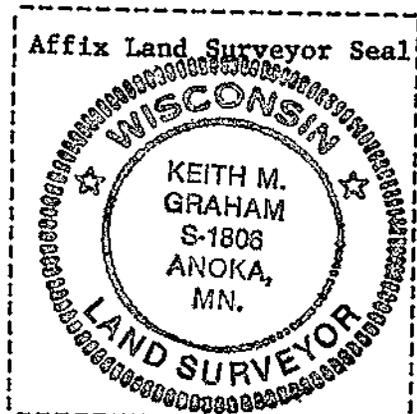

Keith M. Graham Dec. 5, 1984
Signature Date