


21708240020

## U. S. PUBLIC LAND SURVEY MONUMENT RECORD

SECTION 24 T 17 N, R 8 W, TOWN OF ONALASKA  
 LA CROSSE COUNTY

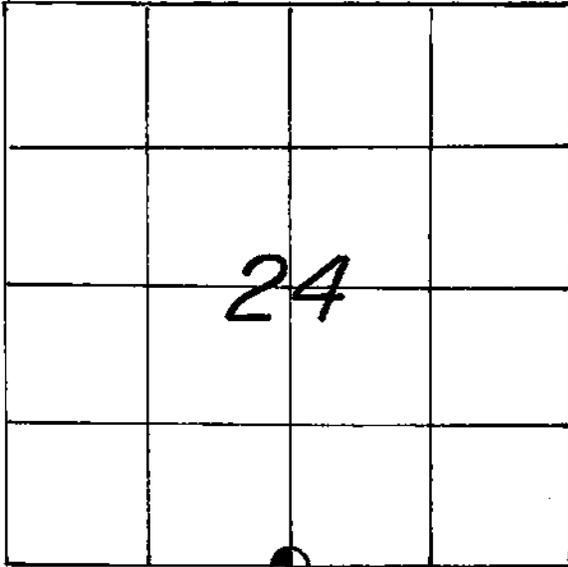

LOCATION OF LANDMARK

## WISCONSIN COORDINATE SYSTEM

North

East

Theta Angle

Horiz. Order

Vert. Order

## TYPE OF LANDMARK

Existing 5/8" Rebar.

BEARINGS ARE REFERENCED TO

Crew: WILLIAM C. JUNG  
 PETER F. FOLLANSBEE  
 Date: 1/04/1996

Describe any record evidence, monument evidence, testimonial evidence or any other material evidence you considered and whether the monument was found or restored through acceptance of an obliterated evidence location.


We found and tied off an iron bar set at the corner by Paul Fairchild. Fairchild set the corner by single proportionate measurement.

Describe or show any material discrepancy between the location of the restored corner and that of the corner previously restored or reestablished.

None Known.

RECORD OF DURABLE WITNESS MONUMENTS

NO	DESCRIPTION	BEARING	DISTANCE
1	Existing Spike at Fairchild survey point	Westerly $\pm$	16.06 Ft.
2	Set P.K. Nail at road intersection	Northeasterly $\pm$	24.20 Ft.
3	Set P.K. Nail in N.-side of Power pole	Southeasterly $\pm$	90.10 Ft.
4	Set P.K. Nail in NE-side of Light pole	Southeasterly $\pm$	60.92 Ft.

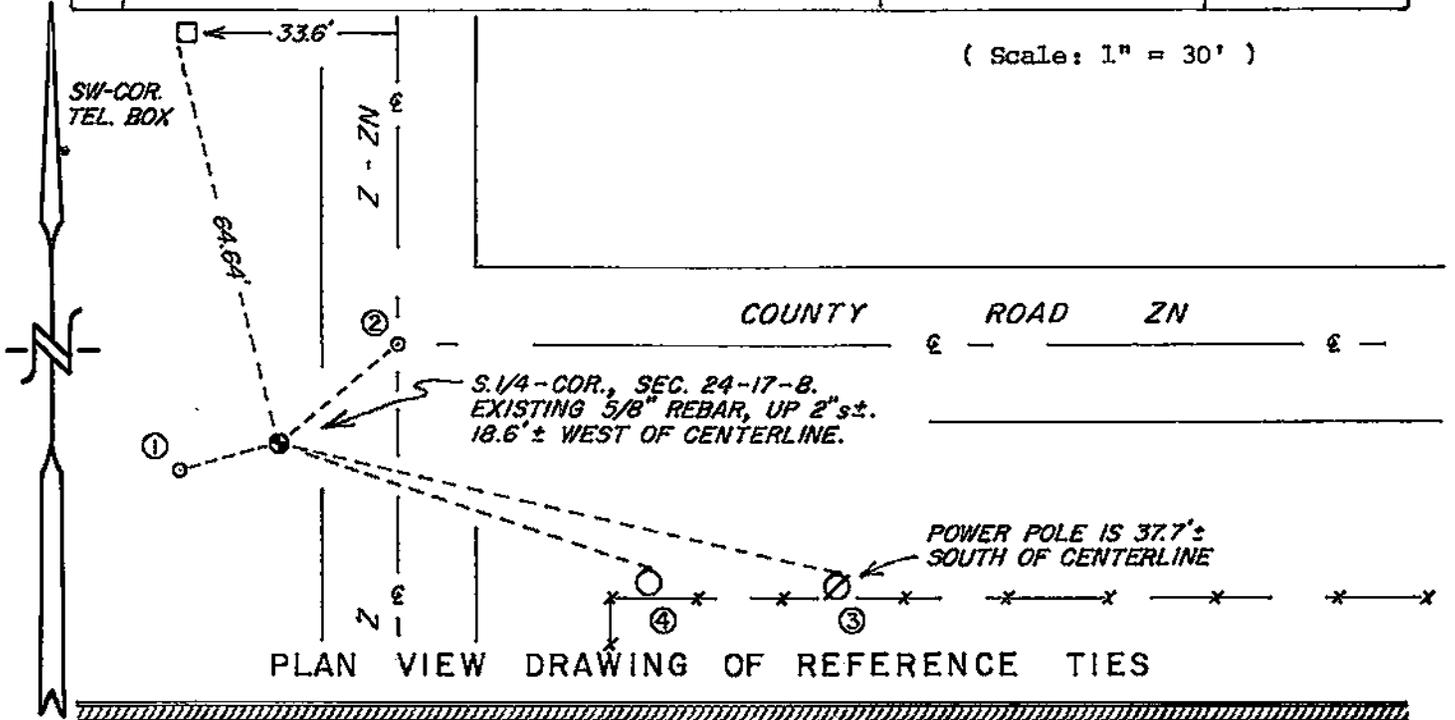


MAP SHOWING DISTANCE AND DIRECTION TO OTHER PUBLIC LAND SURVEY CORNERS USED FOR REESTABLISHING THE CORNER

No section measurements were made by me at this time. Fairchild just recently finished surveying out Section 24.

I, William C. Jung, County Surveyor  
 HEREBY CERTIFY THAT THE CORNER LOCATION SHOWN ON THIS RECORD  
 WAS DETERMINED BY ME OR UNDER MY DIRECTION AND CONTROL AND  
 THAT THIS U. S. PUBLIC LAND SURVEY MONUMENT RECORD IS CORRECT  
 AND COMPLETE TO THE BEST OF MY KNOWLEDGE AND BELIEF.

William C. Jung  
 Signature

1/5/96  
 Date

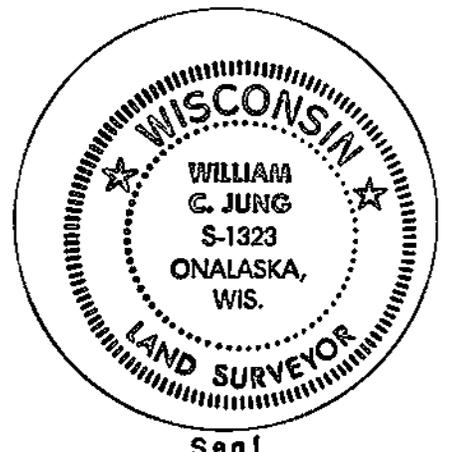

Seal