


# TREMPEALEAU COUNTY

## U.S. PUBLIC LAND SURVEY MONUMENT RECORD

SECTION Corner common to Sections 5, 6, 31 & 32  
 T. 17 & 18 N., R. 8 W.  
 Type of monument 7/8" X30" REBAR WITH ALUMINUM CAP  
 Location indicated on sketch -  -

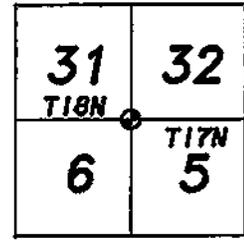

Location Sketch


Describe any record evidence, monument evidence, occupational evidence, testimonial evidence or any other material evidence you considered, and whether the monument was found or placed.

ORIGINAL GOVERNMENT ACCESSORIES WERE SEARCHED FOR, BUT NOTHING WAS FOUND. OTHER MONUMENT EVIDENCE WAS SEARCHED FOR AND A CONCRETE MONUMENT WITH A BRONZE CAP, AS CALLED FOR BY THE UNITED STATES BIOLOGICAL SURVEY, WAS FOUND. MONUMENT WAS FOUND TIPPED SOUTHEASTERLY. ALSO FOUND BOTH U.S.B.S. BEARING TREES. THE OAK TREE WAS FOUND IN GOOD CONDITION AND THE MAPLE TREE FOUND PARTIALLY DOWN. THE U.S.B.S. REESTABLISHED THIS CORNER IN 1931 BY SINGLE PROPORTIONATE MEASUREMENT BETWEEN THE SOUTHWEST CORNER OF SECTION 36-18-9 AND THE SOUTHEAST CORNER OF SECTION 32-18-8. THIS POSITION MATCHES THIS SINGLE PROPORTIONATE POSITION BY LESS THAN 2 FEET EAST/WEST AND BY LESS THAN 4 FEET NORTH/SOUTH. IT MATCHES UNITED STATES ENGINEER OFFICE DISTANCE TO THE SOUTH QUARTER CORNER OF SECTION 31-18-8 BY ABOUT 1 FOOT. IT MATCHES U.S.E.O. DISTANCE TO THE SOUTHEAST CORNER OF SECTION 32-18-8 BY ABOUT 2 FEET. IT ALSO MATCHES ORIGINAL GOVERNMENT DISTANCE TO THE EAST QUARTER CORNER OF SECTION 31-18-8 BY LESS THAN 8 FEET. THEREFORE, BELIEVING FOUND MONUMENT, AS DESCRIBED TO BE THE BEST AVAILABLE EVIDENCE OF THIS CORNER'S ORIGINAL LOCATION, A 7/8" X30" REBAR WITH AN ALUMINUM CAP WAS SET AT THE ORIGINAL, VERTICAL, LOCATION OF THE FOUND, TIPPED, MONUMENT AND REFERENCED AS SHOWN BELOW.

Show a plan view drawing depicting the relevant monuments, providing reference ties to at least 4 witness monuments. Describe witness monuments. Show relationship to occupation.

o SET 5/8" X24" REBAR WITH PLASTIC CAP

BEARINGS SHOWN TO NEAREST DEGREE ARE COMPASS BEARINGS OTHER BEARINGS ARE BASED ON THE TREMPEALEAU COUNTY COORDINATE SYSTEM

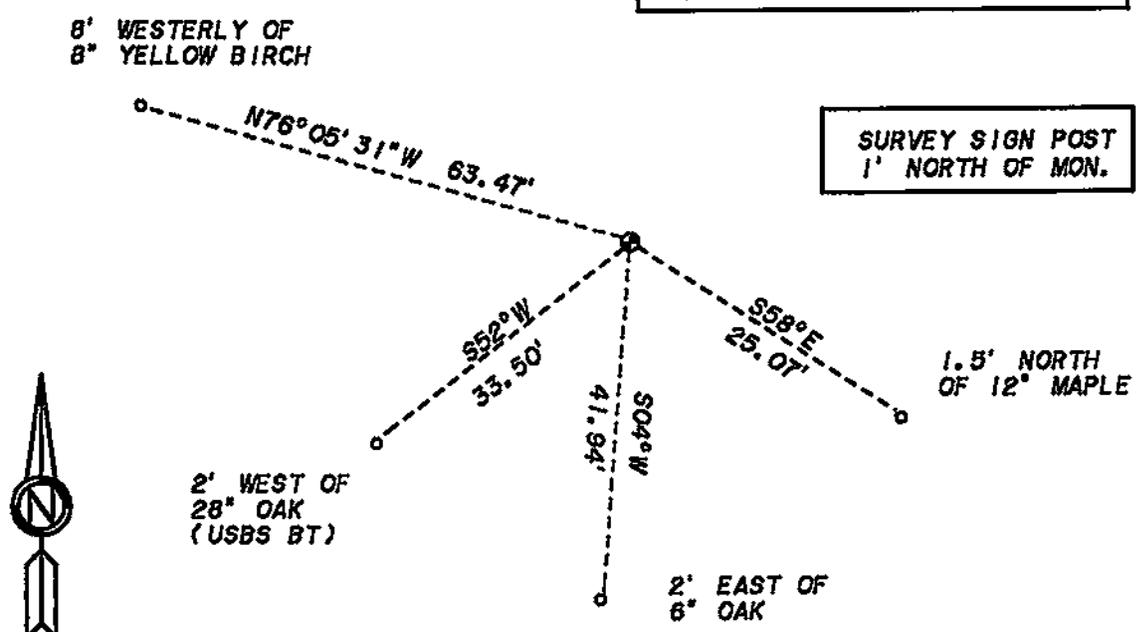

no scale

Corner Identifier number 88-336

Describe any material discrepancy between the location of the corner as restored or reestablished and the location of that corner as previously restored or reestablished by distance and direction. Show the discrepancy on the plan view drawing. Show the distances between the corner as restored or reestablished, and (1) the corner as restored or reestablished, and (2) to at least 2 of the witness monuments shown on the drawing.

**NO MATERIAL DISCREPANCY WAS FOUND.**

Was the corner restored through acceptance of (1) an obliterated evidence location, (2) a found perpetuated location, or (3) an existent corner location?

**A FOUND PERPETUATED LOCATION.**

Was the corner reestablished through lost corner proportionate methods? If so, show the method including the directions and distances to other public land survey corners used as evidence or used for proportioning in determining the corner location.

**NO.**

Show the corner history of record in chronological order from Original Government Survey to present.

**ORIGINAL GOVERNMENT SURVEY - JAS. FREEMAN - NOVEMBER 1845  
SET POST AT SECTION CORNER. MARKED TWO BEARING TREES.**

**UNITED STATES BIOLOGICAL SURVEY - CAMPBELL - SEPTEMBER 1931  
SURVEYS FOR WILD LIFE REFUGE NEAR THE MISSISSIPPI RIVER. SETS A STANDARD  
BIOLOGICAL SURVEY CONCRETE POST 14" IN THE GROUND AT THE SOUTHEAST CORNER  
OF SECTION 31-18-8. MARKED TWO BEARING TREES.**

**UNITED STATES ENGINEER OFFICE - WIELDE - JULY 1932  
SURVEYS FOR LOCK AND DAM SYSTEM ALONG THE MISSISSIPPI RIVER. NOTES  
INDICATE FINDING A 3" DIAMETER CONCRETE MONUMENT WITH A BRONZE CAP AT THE  
SOUTHEAST CORNER OF SECTION 31-18-8. ALSO NOTES TWO BEARING TREES  
MATCHING VERY CLOSELY WITH THE BEARING TREES RECORDED BY U. S. B. S.**

I, JOSEPH P. NELSEN  
certify that the corner location shown on this record  
was determined by me or under my direction and control  
and that this U.S. Public Land Survey Monument Record  
is correct to the best of my knowledge and belief.

Joseph P. Nelsen 7-19-99  
Signature Date

Affix Land Surveyor Seal

