

TREMPEALEAU COUNTY

U.S. PUBLIC LAND SURVEY MONUMENT RECORD

QUARTER Corner common to Sections 6 8 31

T. 17 8 18 N., R. 8 W.

Type of monument 7/8" X60" REBAR WITH ALUMINUM CAP

Location indicated on sketch -  -

31 T18N	31 T17N
6	6


Location Sketch

Describe any record evidence, monument evidence, occupational evidence, testimonial evidence or any other material evidence you considered, and whether the monument was found or placed.

ORIGINAL GOVERNMENT ACCESSORIES WERE SEARCHED FOR, BUT NOTHING WAS FOUND. OTHER MONUMENT EVIDENCE WAS SEARCHED FOR AND A 1-1/2", OUTSIDE DIAMETER, IRON PIPE WAS FOUND IN A SMALL, SHALLOW POND. ALSO SEARCHED FOR UNITED STATES BIOLOGICAL SURVEY BEARING TREES, BUT THEY WERE NOT FOUND. FOUND IRON PIPE MATCHES THE POSITION INDICATED ON T. BLUMENTRITT AND J. KRAGE SURVEYS. J. KRAGE TIE SHEET INDICATES THIS MONUMENT WAS SET BY THE UNITED STATES ENGINEER OFFICE, WHEN IN FACT IT WAS SET BY THE U.S.B.S., IN 1931, BY SINGLE PROPORTIONATE MEASUREMENT BETWEEN THE SOUTHWEST CORNER OF SECTION 36-18-9 AND THE SOUTHEAST CORNER OF SECTION 32-18-8. THIS POSITION MATCHES A SINGLE PROPORTIONATE POSITION BETWEEN THE SOUTHWEST CORNER OF SECTION 36-18-9 AND THE SOUTHEAST CORNER OF SECTION 32-18-8 BY LESS THAN 1 FOOT BOTH NORTH/SOUTH AND EAST/WEST. IT MATCHES U.S.E.O. DISTANCE TO THE SOUTHWEST CORNER OF SECTION 31-18-8 BY LESS THAN 2 FEET IT ALSO MATCHES U.S.E.O. DISTANCE TO THE SOUTHEAST CORNER OF SECTION 31-18-8 BY ABOUT 1 FOOT. THEREFORE, BELIEVING THIS POSITION, AS DESCRIBED TO BE THE BEST AVAILABLE EVIDENCE OF THIS CORNER'S ORIGINAL LOCATION, THE FOUND IRON PIPE WAS LEFT IN PLACE, A 7/8" X60" REBAR WITH AN ALUMINUM CAP WAS SET INSIDE OF FOUND IRON PIPE AND REFERENCED AS SHOWN BELOW.

Show a plan view drawing depicting the relevant monuments, providing reference ties to at least 4 witness monuments. Describe witness monuments. Show relationship to occupation.

o SET 5/8" X24" REBAR WITH PLASTIC CAP

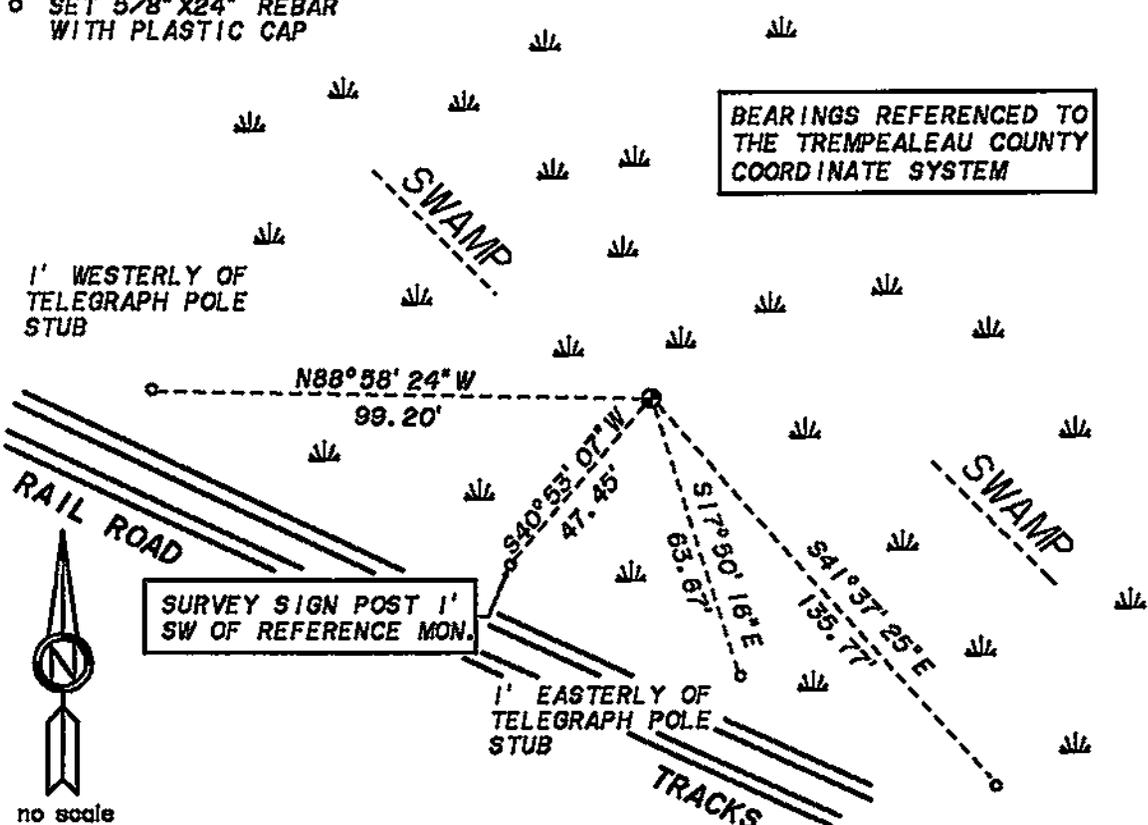

Corner Identifier number

92-336

