

21808320000

# TREMPEALEAU COUNTY

## U.S. PUBLIC LAND SURVEY MONUMENT RECORD

SECTION Corner common to Sections 4, 5, 32 & 33

T. 17 & 18 N., R. 8 W.

Type of monument 7/8" X 60" REBAR WITH ALUMINUM CAP

Location indicated on sketch -  $\odot$  -

32 T18N	33 T17N
5	4


Location Sketch

Describe any record evidence, monument evidence, occupational evidence, testimonial evidence or any other material evidence you considered, and whether the monument was found or placed.

ORIGINAL GOVERNMENT ACCESSORIES WERE SEARCHED FOR, BUT NOTHING WAS FOUND. OTHER MONUMENT EVIDENCE WAS SEARCHED FOR, AND A CONCRETE, BRONZE CAPPED MONUMENT WAS FOUND. MONUMENT WAS FOUND IN A SMALL, SHALLOW CREEK WITH A SURVEY SIGNPOST WIRED TO IT. FOUND CONCRETE MONUMENT MATCHES THE DESCRIPTION OF A MONUMENT SET BY THE UNITED STATES BIOLOGICAL SURVEY IN 1931 AND FOUND BY AT LEAST FOUR SUBSEQUENT SURVEYORS OF RECORD. ALSO FOUND U.S.B.S. ELM BEARING TREE, NOW A STUMP. THIS POSITION MATCHES THE MATHEMATICAL LOCATION, AS INDICATED BY R. MURPHY SURVEY OF 1986. FOUND MONUMENT IS VERY UNSTABLE, DUE TO BEING LOCATED IN SMALL CREEK BED. THEREFORE, BELIEVING FOUND MONUMENT, AS DESCRIBED, TO BE THE BEST AVAILABLE EVIDENCE OF THIS CORNER'S ORIGINAL LOCATION, A 7/8" X 60" REBAR WITH AN ALUMINUM CAP WAS SET IN ITS PLACE AND REFERENCED AS SHOWN BELOW.

Show a plan view drawing depicting the relevant monuments, providing reference ties to at least 4 witness monuments. Describe witness monuments. Show relationship to occupation.

o SET 5/8" X 24" REBAR WITH PLASTIC CAP

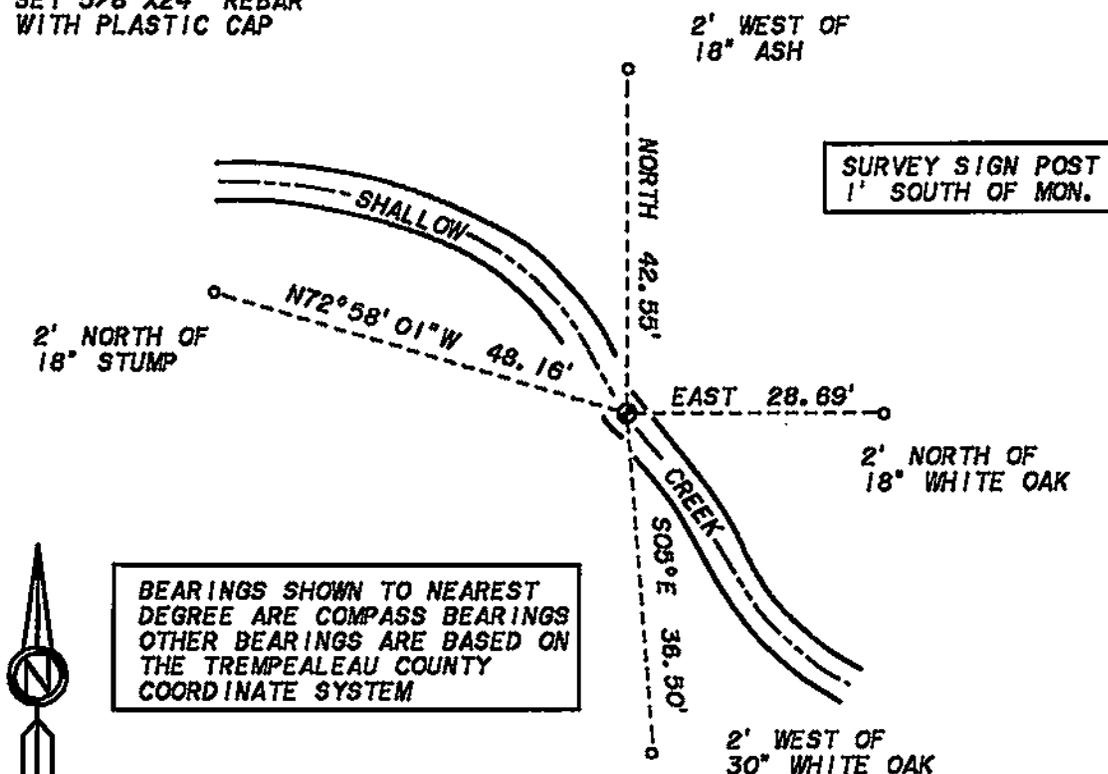

BEARINGS SHOWN TO NEAREST DEGREE ARE COMPASS BEARINGS OTHER BEARINGS ARE BASED ON THE TREMPLEALEAU COUNTY COORDINATE SYSTEM

no scale


Corner Identifier number 80-336



## U. S. PUBLIC LAND SURVEY MONUMENT RECORD

SECTION 4 T 17 N, R 8 W, TOWN OF Holland

LA CROSSE COUNTY

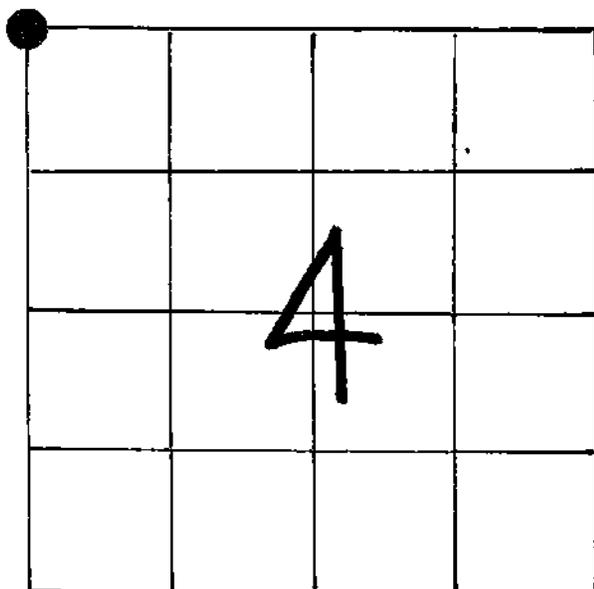

LOCATION OF LANDMARK

Crew: William C. Jung  
Peter F. Follansbee

Date: May 28, 1992

Describe any record evidence, monument evidence, testimonial evidence or any other material evidence you considered and whether the monument was found or restored through acceptance of an obliterated evidence location.

J.R. Campbell set a brass capped marker at this corner in 1931. He was working for the U.S.B.S. The brass cap is on a concrete marker. Gary Dechant found this corner again in February of this year. The marker falls in a creek. I tied our sign post to it. There are also two other signs nearby.

Describe or show any material discrepancy between the location of the restored corner and that of the corner previously restored or reestablished.

None known.

## WISCONSIN COORDINATE SYSTEM

North

East

Theta Angle

Horiz. Order

Vert. Order


## TYPE OF LANDMARK

Brass capped marker

BEARINGS ARE REFERENCED TO

RECORD OF DURABLE WITNESS MONUMENTS

NO	DESCRIPTION	Magnetic BEARING	DISTANCE
1	Nail in double blazed 7" white oak	N46°E	35.38
2	" " 29" "	S12°E	36.23
3	P.K. " 8" "	S76°W	36.93
4	Nail " 7" "	S77°W	21.87

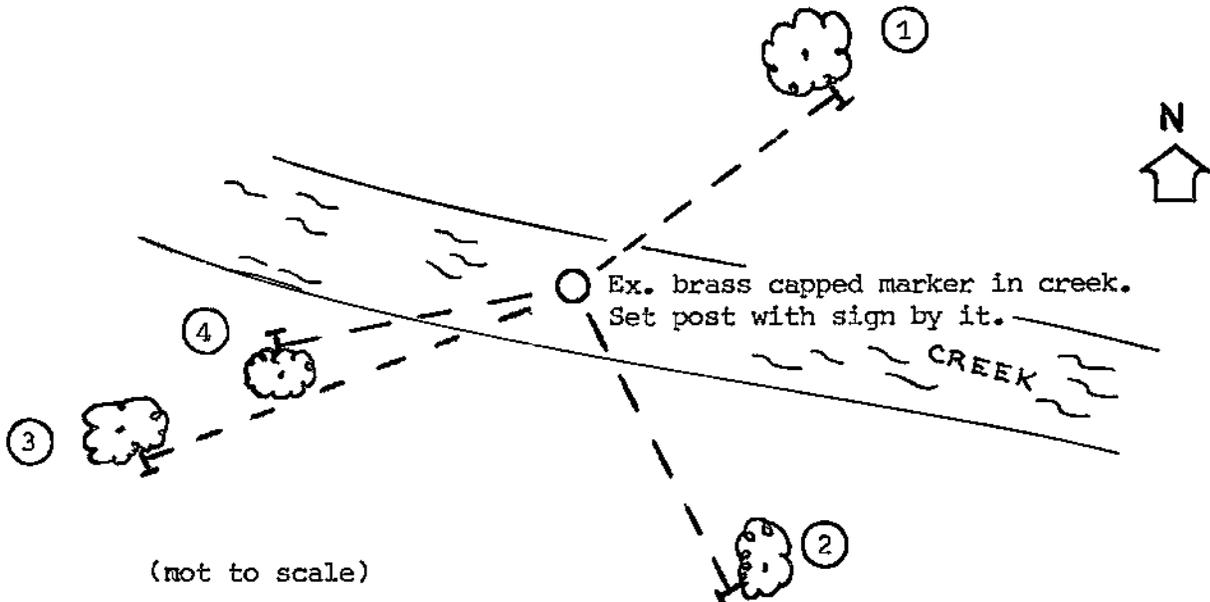

PLAN VIEW DRAWING OF REFERENCE TIES


MAP SHOWING DISTANCE AND DIRECTION TO OTHER PUBLIC LAND SURVEY CORNERS USED FOR REESTABLISHING THE CORNER

No section measurements made by me at this time. Position was verified by Dechant.

I, William C. Jung, Deputy County Surveyor,  
 HEREBY CERTIFY THAT THE CORNER LOCATION SHOWN ON THIS RECORD  
 WAS DETERMINED BY ME OR UNDER MY DIRECTION AND CONTROL AND  
 THAT THIS U. S. PUBLIC LAND SURVEY MONUMENT RECORD IS CORRECT  
 AND COMPLETE TO THE BEST OF MY KNOWLEDGE AND BELIEF.

William C. Jung  
 Signature

July 9, 1992  
 Date

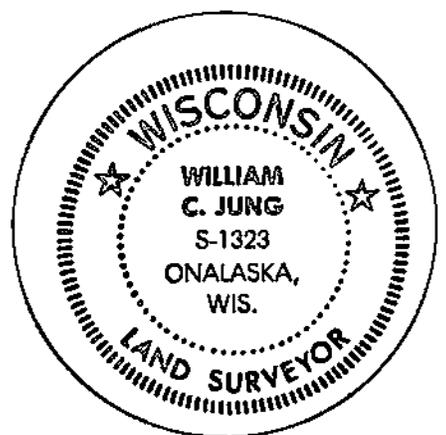

Seal