

TREMPEALEAU COUNTY

U.S. PUBLIC LAND SURVEY MONUMENT RECORD

QUARTER Corner common to Sections 5 & 32

T. 17 & 18 N., R. 8 W.

Type of monument 7/8" X 30" REBAR WITH ALUMINUM CAP

Location indicated on sketch - -

32 T18N	32 T17N
5	5


Location Sketch

Describe any record evidence, monument evidence, occupational evidence, testimonial evidence or any other material evidence you considered, and whether the monument was found or placed.

ORIGINAL GOVERNMENT ACCESSORIES WERE SEARCHED FOR, BUT NOTHING WAS FOUND. OTHER MONUMENT EVIDENCE WAS SEARCHED FOR, AND A 1-1/2", OUTSIDE DIAMETER, IRON PIPE WAS FOUND AT THE INTERSECTION OF FENCE LINES EAST/WEST AND SOUTH. FOUND IRON PIPE MATCHES THE MATHEMATICAL LOCATION OF A 2" IRON PIPE, NOTED R. MURPHY IN 1996, AS MONUMENTING THE NORTH QUARTER CORNER OF SECTION 5-17-8. FOUND IRON PIPE MATCHES CLOSELY WITH THE DESCRIPTION OF AN IRON PIPE SET BY THE UNITED STATES BIOLOGICAL SURVEY IN 1931. THE UNITED STATES ENGINEER OFFICE NOTES FINDING A FENCE INTERSECTION AT THIS CORNER POSITION, BUT DOES NOT MENTION FINDING THE IRON PIPE THAT WOULD HAVE BEEN SET APPROXIMATELY 1 YEAR PRIOR TO THEIR SURVEY. THE U.S.B.S. REESTABLISHED THIS CORNER POSITION BASED ON SINGLE PROPORTIONATE MEASUREMENT BETWEEN THE SOUTHWEST CORNER OF SECTION 36-18-9 AND THE SOUTHEAST CORNER OF SECTION 32-18-8. THIS POSITION MATCHES THIS SINGLE PROPORTION POSITION BY LESS THAN 2 FEET NORTH/SOUTH AND BY LESS THAN 3 FEET EAST/WEST. THEREFORE, BELIEVING THIS POSITION, AS DESCRIBED, TO BE THE BEST AVAILABLE EVIDENCE OF THIS CORNER'S ORIGINAL LOCATION, A 7/8" X 30" REBAR WITH AN ALUMINUM CAP WAS PLACED INSIDE OF THE FOUND IRON PIPE AND REFERENCED AS SHOWN BELOW.

Show a plan view drawing depicting the relevant monuments, providing reference ties to at least 4 witness monuments. Describe witness monuments. Show relationship to occupation.

o SET 5/8" X 24" REBAR WITH PLASTIC CAP

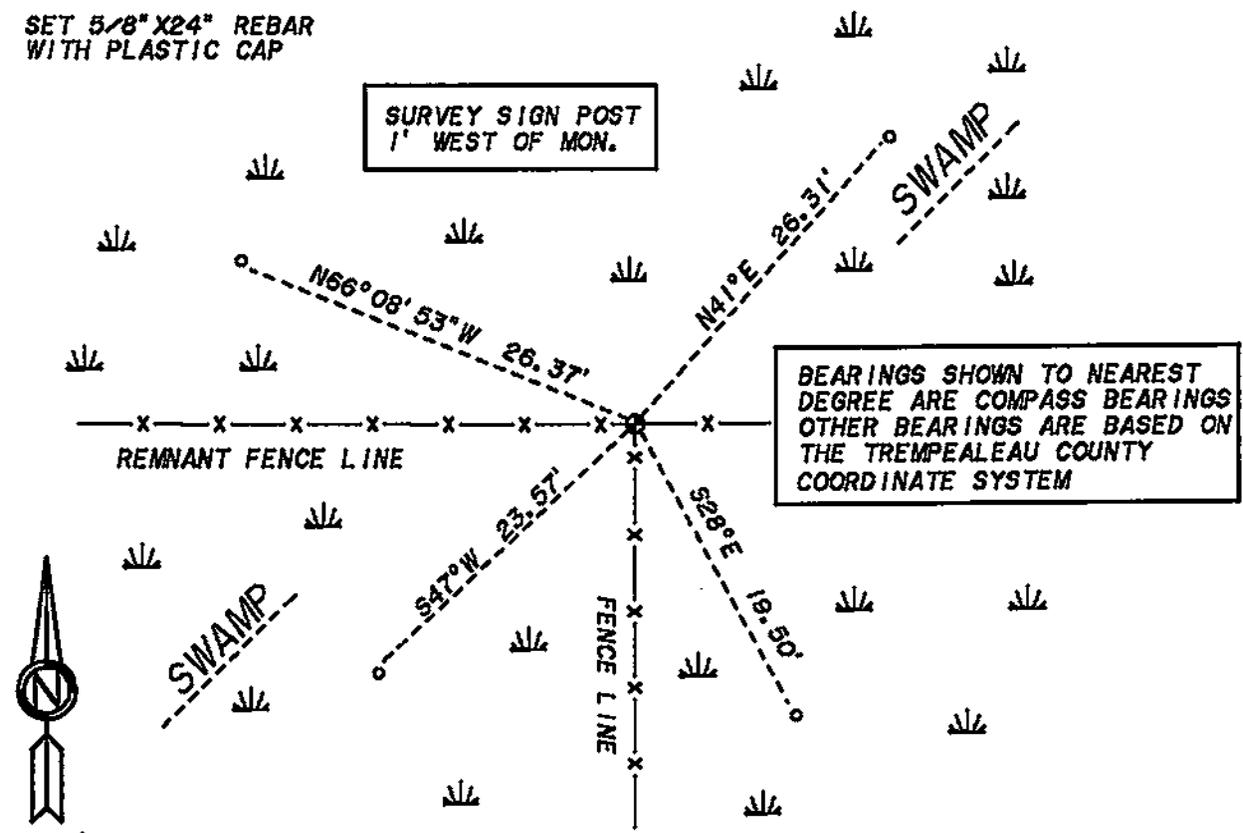

Corner Identifier number 34 336

Describe any material discrepancy between the location of the corner as restored or reestablished and the location of that corner as previously restored or reestablished by distance and direction. Show the discrepancy on the plan view drawing. Show the distances between the corner as restored or reestablished, and (1) the corner as restored or reestablished, and (2) to at least 2 of the witness monuments shown on the drawing.

NO MATERIAL DISCREPANCY WAS FOUND.

Was the corner restored through acceptance of (1) an obliterated evidence location, (2) a found perpetuated location, or (3) an existent corner location?

A FOUND PERPETUATED LOCATION.

Was the corner reestablished through lost corner proportionate methods? If so, show the method including the directions and distances to other public land survey corners used as evidence or used for proportioning in determining the corner location.

NO.

Show the corner history of record in chronological order from Original Government Survey to present.

**ORIGINAL GOVERNMENT SURVEY - JAS. FREEMAN - NOVEMBER 1845
SET POST QUARTER SECTION CORNER. MARKED TWO BEARING TREES.**

**UNITED STATES BIOLOGICAL SURVEY - CAMPBELL - SEPTEMBER 1931
SURVEYS FOR WILD LIFE REFUGE NEAR THE MISSISSIPPI RIVER. SETS A 1-1/4" X 45"
IRON PIPE AT THE SOUTH QUARTER CORNER OF SECTION 32-18-8.**

**UNITED STATES ENGINEER OFFICE - WIELDE - JULY 1932
SURVEYS FOR LOCK AND DAM SYSTEM ALONG THE MISSISSIPPI RIVER. NOTES A GOOD
FENCE INTERSECTION OF FENCE LINES NORTH/SOUTH AND EAST. POSSIBLE SOUTH
QUARTER CORNER OF SECTION 32-18-8. NO MENTION OF IRON PIPE SET BY U.S.B.S.**

**PRIVATE LAND SURVEYOR'S RECORDS - R. MURPHY - OCTOBER 1898
SURVEYS FOR THE UNITED STATES DEPARTMENT OF THE INTERIOR. CALLS FOR A
2" IRON PIPE FOUND AT THE NORTH QUARTER CORNER OF SECTION 5-17-8.**

I, JOSEPH P. NELSEN
certify that the corner location shown on this record
was determined by me or under my direction and control
and that this U.S. Public Land Survey Monument Record
is correct to the best of my knowledge and belief.

Joseph P. Nelsen 7-20-99
Signature Date

Affix Land Surveyor Seal

