

TREMPEALEAU COUNTY

U.S. PUBLIC LAND SURVEY MONUMENT RECORD

QUARTER Corner common to Sections 4 & 33

T. 17 & 18 N., R. 8 W.

Type of monument 7/8" X30" REBAR WITH ALUMINUM CAP

Location indicated on sketch -- --

33 T18N	33 T17N
4	4


Location Sketch

Describe any record evidence, monument evidence, occupational evidence, testimonial evidence or any other material evidence you considered, and whether the monument was found or placed.

ORIGINAL GOVERNMENT ACCESSORIES WERE SEARCHED FOR, BUT NOTHING WAS FOUND. OTHER MONUMENT EVIDENCE WAS SEARCHED FOR, AND A 2-1/2", OUTSIDE DIAMETER, IRON PIPE WAS FOUND. ALSO FOUND RECENT BEARING TREES FROM G. DECHANT AND W. JUNG. FOUND IRON PIPE MATCHES THE MATHEMATICAL POSITION INDICATED ON R. MURPHY SURVEY OF 1998. FOUND IRON PIPE MATCHES THE DESCRIPTION OF AN IRON PIPE SET BY THE U.S.B.S. IN 1931. U.S.B.S. CALLS FOR FINDING A 2" IRON PIPE AT THE SOUTHWEST SIDE OF A WHITE OAK TREE THAT WAS BLAZED ON FOUR SIDES. ACCORDING TO THE U.S.B.S. NOTES, ANOTHER 2" IRON PIPE WAS SET AT THIS LOCATION, APPARENTLY REPLACING THE FOUND IRON PIPE. THIS FOUND IRON PIPE MATCHES U.S.B.S. DISTANCE TO THE SOUTHWEST CORNER OF SECTION 33-18-8 BY LESS THAN 1 FOOT. IT MATCHES U.S.B.S. DISTANCE TO THE SOUTHEAST CORNER OF SECTION 33-18-8 BY ABOUT 1 FOOT. IT MATCHES U.S.E.O. DISTANCE TO THE SOUTHWEST CORNER OF SECTION 33-18-8 BY LESS THAN 1 FOOT. IT ALSO MATCHES U.S.E.O. DISTANCE TO THE SOUTHEAST CORNER OF SECTION 33-18-8 BY ABOUT 4 FEET. THEREFORE, BELIEVING FOUND IRON PIPE, AS DESCRIBED, TO BE THE BEST AVAILABLE EVIDENCE OF THIS CORNER'S ORIGINAL LOCATION, A 7/8" X30" REBAR WITH AN ALUMINUM CAP WAS SET IN ITS PLACE AND REFERENCED AS SHOWN BELOW.

Show a plan view drawing depicting the relevant monuments, providing reference ties to at least 4 witness monuments. Describe witness monuments. Show relationship to occupation.

o SET 5/8" X24" REBAR WITH PLASTIC CAP

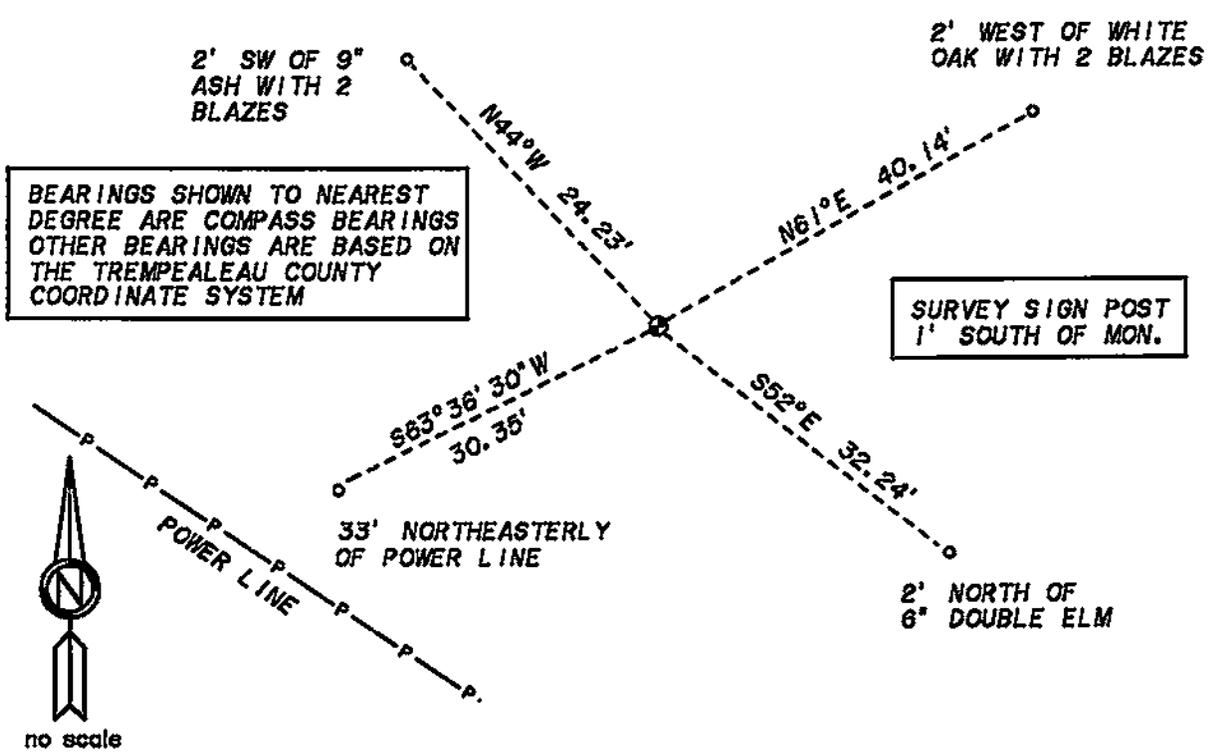

Corner Identifier number 76-336

no scale

Describe any material discrepancy between the location of the corner as restored or reestablished and the location of that corner as previously restored or reestablished by distance and direction. Show the discrepancy on the plan view drawing. Show the distances between the corner as restored or reestablished, and (1) the corner as restored or reestablished, and (2) to at least 2 of the witness monuments shown on the drawing.

NO MATERIAL DISCREPANCY WAS FOUND.

Was the corner restored through acceptance of (1) an obliterated evidence location, (2) a found perpetuated location, or (3) an existent corner location?

A FOUND PERPETUATED LOCATION.

Was the corner reestablished through lost corner proportionate methods? If so, show the method including the directions and distances to other public land survey corners used as evidence or used for proportioning in determining the corner location.

NO.

Show the corner history of record in chronological order from Original Government Survey to present.

**ORIGINAL GOVERNMENT SURVEY - J.E. FREEMAN - NOVEMBER 1845
SET QUARTER SECTION CORNER. MARKED TWO BEARING TREES.**

**UNITED STATES BIOLOGICAL SURVEY - CAMPBELL - SEPTEMBER 1931
SURVEYS FOR WILDLIFE REFUGE NEAR THE MISSISSIPPI RIVER. APPARENTLY FOUND
A 13" WHITE OAK WITH BLAZES ON NORTH, SOUTH, EAST AND WEST SIDES WITH A
2" IRON PIPE ON SOUTHWEST SIDE OF TREE AT THE SOUTH QUARTER CORNER OF
SECTION 33-18-8. SETS A 2" IRON PIPE AND MARKS TWO BEARING TREES.**

**UNITED STATES ENGINEER OFFICE - L. JENSEN - AUGUST 1932
SURVEYS FOR THE LOCK AND DAM SYSTEM ALONG THE MISSISSIPPI RIVER. NOTES
FINDING A 2-1/2" IRON PIPE AT THE SOUTH QUARTER CORNER OF SECTION 33-18-8.
MARKS TWO BEARING TREES.**

**CERTIFIED SURVEY MAP - G. DECHANT - FEBRUARY 1992
SURVEYS A PARCEL IN SECTION 33-18-8. CALLS FOR AN EXISTING 2" IRON PIPE
WITH TOP HALF BROKEN OFF, NEXT TO OAK STUMP AT THE SOUTH QUARTER CORNER
OF SECTION 33. MARKS TWO BEARING TREES.**

**U.S. PUBLIC LAND SURVEY MONUMENT RECORD - W. JUNG - JANUARY 1993
FILES TIE SHEET FOR THE NORTH QUARTER CORNER OF SECTION 4-17-8. CALLS FOR
AN EXISTING 2" IRON PIPE AS CALLED FOR BY G. DECHANT. NOTES FOUR BEARING
TREES.**

**PRIVATE LAND SURVEYOR'S RECORDS - R. MURPHY - OCTOBER 1996
SURVEYS FOR THE UNITED STATES DEPARTMENT OF THE INTERIOR. CALLS FOR A
FOUND 2" IRON PIPE AT THE NORTH QUARTER CORNER OF SECTION 4-17-8.**

Affix Land Surveyor Seal


I, JOSEPH P. NELSEN
certify that the corner location shown on this record
was determined by me or under my direction and control
and that this U.S. Public Land Survey Monument Record
is correct to the best of my knowledge and belief.

Joseph P. Nelsen 8-2-99
Signature Date



U. S. PUBLIC LAND SURVEY MONUMENT RECORD

SECTION 4 T 17 N, R 8 W, TOWN OF Holland
 LA CROSSE COUNTY

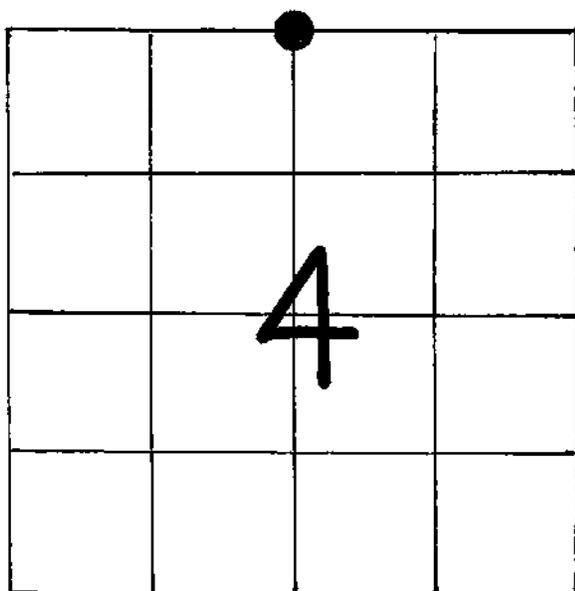

LOCATION OF LANDMARK

WISCONSIN COORDINATE SYSTEM
North
East
Theta Angle
Horiz. Order
Vert. Order
TYPE OF LANDMARK
1" iron pipe set in existing 2" iron pipe
BEARINGS ARE REFERENCED TO iron pipe

Crew: William C. Jung

Crew: William C. Jung
 Peter F. Follansbee

Date: March 20, 1992

Date: January 5, 1993

Describe any record evidence, monument evidence, testimonial evidence or any other material evidence you considered and whether the monument was found or restored through acceptance of an obliterated evidence location.


G.Dechant found an iron pipe at this corner. The pipe had been set by the U.S.B.S. in 1931. I set a 1" iron pipe inside of the existing 2" iron pipe which is up 8". A sign and post were set to the Northwest.

Describe or show any material discrepancy between the location of the restored corner and that of the corner previously restored or reestablished.

None known.

RECORD OF DURABLE WITNESS MONUMENTS

NO	DESCRIPTION	Magnetic	DISTANCE
		BEARING	
1	P.K. nail in double blazed 7" maple	N37°W	24.18
2	" 4" ash	N11°E	34.68
3	" 11" oak	N56°E	41.48
4	" double ash	N77°E	22.84

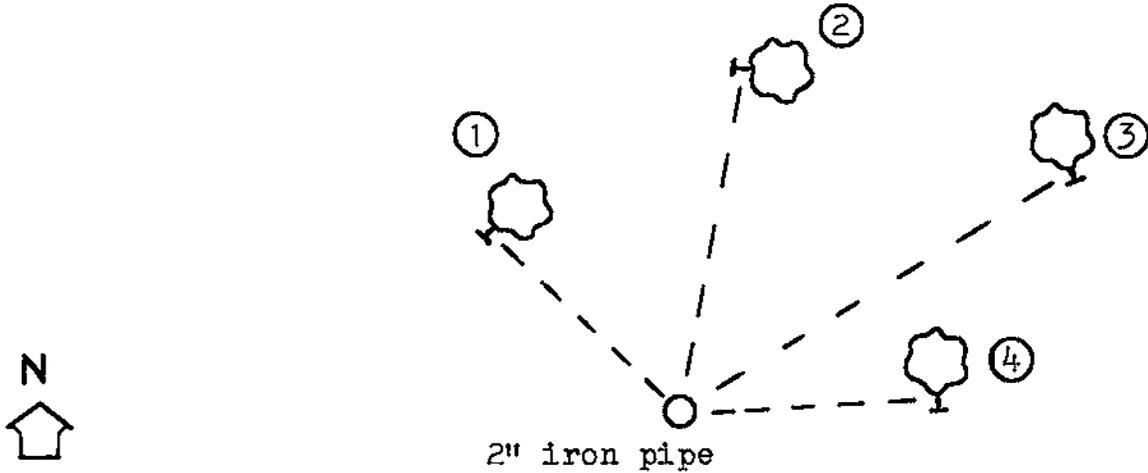

(not to scale)

PLAN VIEW DRAWING OF REFERENCE TIES


MAP SHOWING DISTANCE AND DIRECTION TO OTHER PUBLIC LAND SURVEY CORNERS USED FOR REESTABLISHING THE CORNER

No section measurements made by me at this time. Position verified by Dechant.

I, William C. Jung, Deputy County Surveyor,
 HEREBY CERTIFY THAT THE CORNER LOCATION SHOWN ON THIS RECORD
 WAS DETERMINED BY ME OR UNDER MY DIRECTION AND CONTROL AND
 THAT THIS U. S. PUBLIC LAND SURVEY MONUMENT RECORD IS CORRECT
 AND COMPLETE TO THE BEST OF MY KNOWLEDGE AND BELIEF.

William C. Jung
 Signature

January 5, 1993
 Date

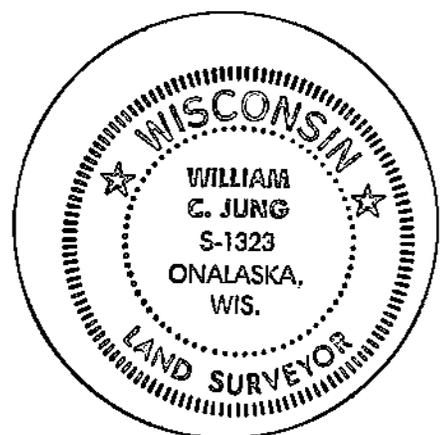

Seal