


21808340020

U. S. PUBLIC LAND SURVEY MONUMENT RECORD

SECTION 3 T 17 N, R 8 W, TOWN OF HOLLAND

LA CROSSE COUNTY

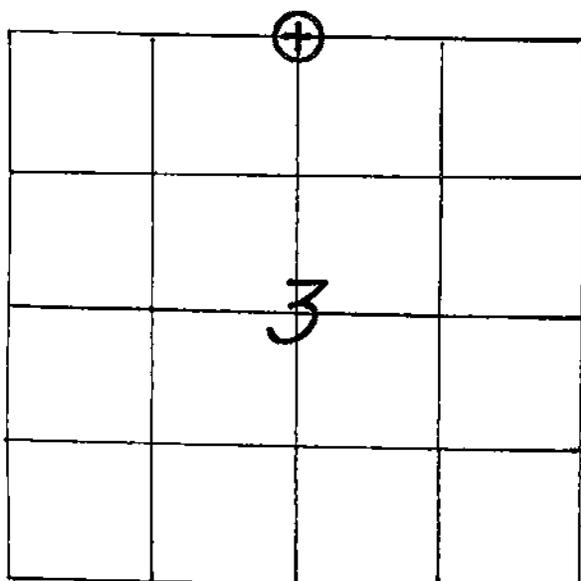

WISCONSIN COORDINATE SYSTEM

North

East

Theta Angle

Horiz. Order

Vert. Order

TYPE OF LANDMARK

IRON BAR WITH ALUMINUM CAP IN IRON PIPE.

BEARINGS ARE REFERENCED TO

LOCATION OF LANDMARK

CREW: WILLIAM G. JUNG
 PETER F. FOLLANSBEE
 DATE: 10/15/2007

Describe any record evidence, monument evidence, testimonial evidence or any other material evidence you considered and whether the monument was found or restored through acceptance of an obliterated evidence location.


A pipe was set at this corner when the surveys were being done during the construction of the locks and dams. Dick Berg found this pipe and used it when he did the survey for the Assessor's Plat of New Amsterdam back in 1982 and 1983. We found this pipe, buried, and set an iron bar with a cap in it to bring the corner position to the surface. Because of the problems we found at the NE of Section 3, this corner MAY be too far North. I won't ***** Describe or show any material discrepancy between the location of the restored corner and that of the corner previously restored or reestablished.

NONE KNOWN.

***** know until I make further section measurements to this corner.

RECORD OF DURABLE WITNESS MONUMENTS

NO	DESCRIPTION	MAGNETIC BEARING	DISTANCE
1	SET A NAIL IN N.W.-SIDE OF A 12-1/2" MAPLE	S 59° W	41.65 FT.
2	SET A NAIL IN N.-SIDE OF A 17" MAPLE	WEST ±	41.46 FT.
3	SET A NAIL IN N.E.-SIDE OF A 15-1/2" MAPLE	N 31° W	42.37 FT.
4	SET A NAIL IN S.E.-SIDE OF A 32" MAPLE	N 81° E	16.57 FT.

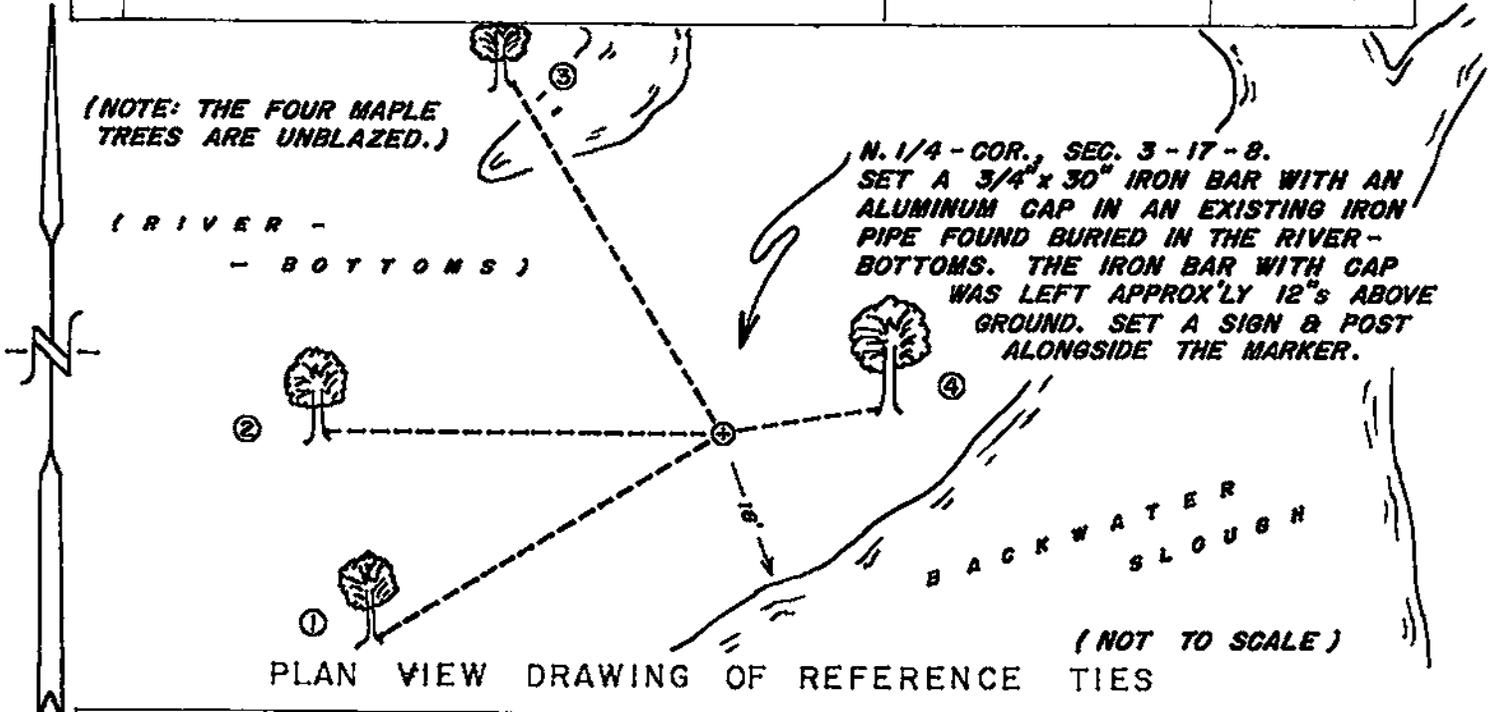

MAP SHOWING DISTANCE AND DIRECTION TO OTHER PUBLIC LAND SURVEY CORNERS USED FOR REESTABLISHING THE CORNER

No further section measurements were made by me at this time.

I, WILLIAM G. JUNG, COUNTY SURVEYOR
HEREBY CERTIFY THAT THE CORNER LOCATION SHOWN ON THIS RECORD WAS DETERMINED BY ME OR UNDER MY DIRECTION AND CONTROL AND THAT THIS U. S. PUBLIC LAND SURVEY MONUMENT RECORD IS CORRECT AND COMPLETE TO THE BEST OF MY KNOWLEDGE AND BELIEF.

William G. Jung
Signature

12/6/07
Date



Seal