

21709350000

TREMPEALEAU COUNTY

U.S. PUBLIC LAND SURVEY MONUMENT RECORD

SECTION Corner common to Sections 1, 2, 35 & 36

T. 17 & 18 N., R. 9 W.

Type of monument 3" BRASS CAP ON CONCRETE MONUMENT

Location indicated on sketch -  -

35	36
T17N	T18N
2	1


Location Sketch

Describe any record evidence, monument evidence, occupational evidence, testimonial evidence or any other material evidence you considered, and whether the monument was found or placed.

ORIGINAL GOVERNMENT ACCESSORIES WERE SEARCHED FOR, BUT NOT FOUND. OTHER MONUMENT EVIDENCE WAS SEARCHED FOR, AND A 3" BRASS CAP ON A CONCRETE MONUMENT, AS INDICATED BY VARIOUS SURVEY OF RECORD, WAS FOUND. MONUMENT WAS FOUND APPROXIMATELY 13 FEET SOUTH OF THE CENTERLINE OF AN EAST/WEST ACCESS ROAD. ALSO FOUND A DISTURBED STONE, MATCHING CLOSELY WITH DIMENSIONS RECORDED IN OLD COUNTY SURVEYOR'S NOTES, ALONG THE NORTH SIDE OF THE CONCRETE MONUMENT. STONE HAD VARIOUS LETTERS AND NUMBER CUT ON SIDES AND TOP, AS NOTED IN THE U.S. BIOLOGICAL SURVEY NOTES. THIS POSITION MATCHES ORIGINAL GOVERNMENT DISTANCE TO THE EAST QUARTER CORNER OF SECTION 35-18-9 BY LESS THAN 4 FEET. IT ALSO MATCHES USEO DISTANCE TO THE SOUTH QUARTER CORNER OF SECTION 31-18-8 BY ABOUT 1 FOOT. THEREFORE, BELIEVING FOUND MONUMENT, AS DESCRIBED, TO BE THE BEST AVAILABLE EVIDENCE OF THIS CORNERS ORIGINAL LOCATION, IT WAS LEFT IN PLACE AND REFERENCED AS SHOWN BELOW.

Show a plan view drawing depicting the relevant monuments, providing reference ties to at least 4 witness monuments. Describe witness monuments. Show relationship to occupation.

o SET 5/8" X24" REBAR WITH PLASTIC CAP

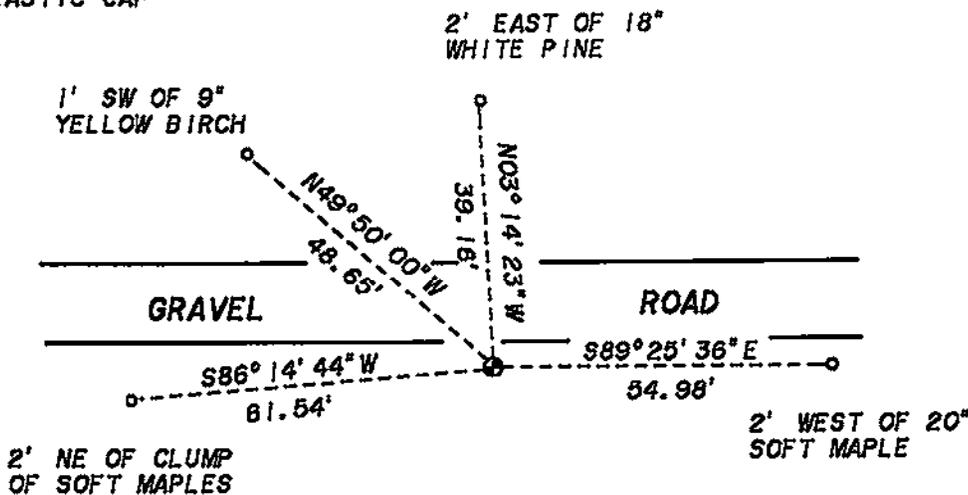

Corner Identifier number

17-9-336



no scale

BEARINGS REFERENCED TO THE TREMPLEALEAU COUNTY COORDINATE SYSTEM


SURVEY SIGN POST 1' SOUTH OF MON.

U. S. PUBLIC LAND SURVEY MONUMENT RECORD

INSTRUCTIONS: This record shall show the location of the corner and shall include all of the following nine elements (a through i).

- (a) Identify the corner by reference to the U.S. public land survey system.
- = Corner monument restored.

Southwest Corner Section 36
T18N, R9W.

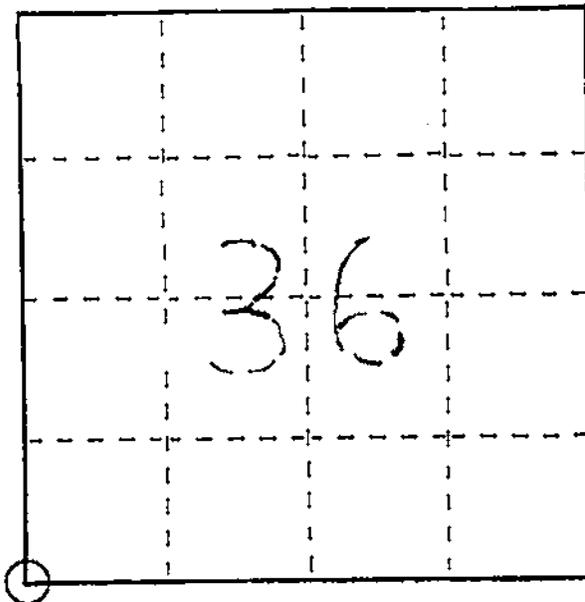


- (b) Describe any record evidence, monument evidence, occupational evidence, testimonial evidence or any other material evidence you considered, and whether the monument was found or placed.

Found 3" brass capped iron pipe set by United States Biological Survey, as shown on Corps of Engineers Lock and Dam No. 7 Flowage Survey Map. Refer Corps of Engineers Survey Book, Land Lines 9-7-3B Page 4, dated June 21, 1932

- (c) In the plan view drawing below, provide reference ties to at least 4 witness monuments, or, if the location is within a municipality, to at least 2 witness monuments. (Witness monuments shall be made of concrete, natural stone, iron or other equally durable material.) Describe witness monuments.

- (d) Show a plan view drawing depicting the relevant monuments and reference ties which is sufficient in detail to enable accurate relocation of the corner monument if the corner monument is disturbed. Indicate north.

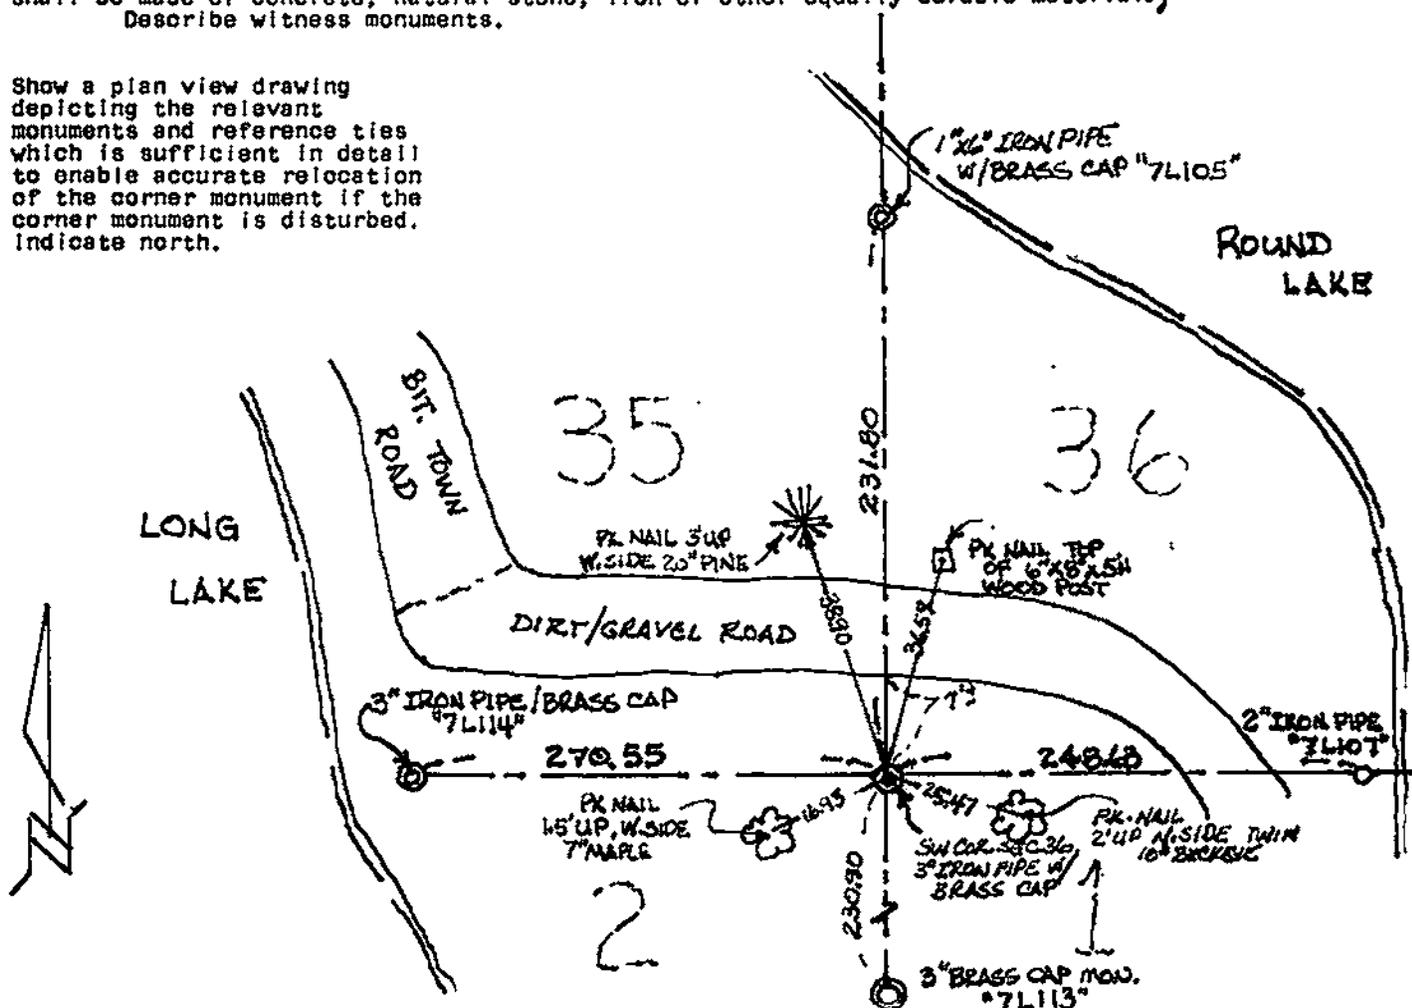

(e) Describe any material discrepancy between the location of the corner as restored or reestablished and the location of that corner as previously restored or reestablished by distance and direction. Show the discrepancy on the plan view drawing under (d), above. Show the distances between the corner as previously restored or reestablished and (1) the corner as restored or reestablished, and (2) to at least 2 of the witness monuments shown on the drawing in (d), above.

Not Applicable

(f) Was the corner restored through acceptance of (1) an obliterated evidence location, or, (2) a found perpetuated location?

(2) A found perpetuated location

(g&h) Was the corner reestablished through lost corner proportionate methods? If so, show the method, including the directions and distances to other public land survey corners used as evidence or used for proportioning in determining the corner location?

Not Applicable

(i) I, Paul A. Johnson
(type or print name) certify that the corner location shown on this record was determined by me or under my direction and control and that this U.S. Public Land Survey Monument Record is correct and complete to the best of my knowledge and belief.

Signature

Paul A. Johnson

May 12, 1992
Date




U. S. PUBLIC LAND SURVEY MONUMENT RECORD

INSTRUCTIONS: This record shall show the location of the corner and shall include all of the following nine elements (a through i).

- (a) Identify the corner by reference to the U.S. public land survey system.
- = Corner monument restored.

CORNER COMMON TO:

SEC'S 35 & 36, T. 18 N., R. 9 W.,
SEC'S 1 & 2, T. 17 N., R. 9 W.

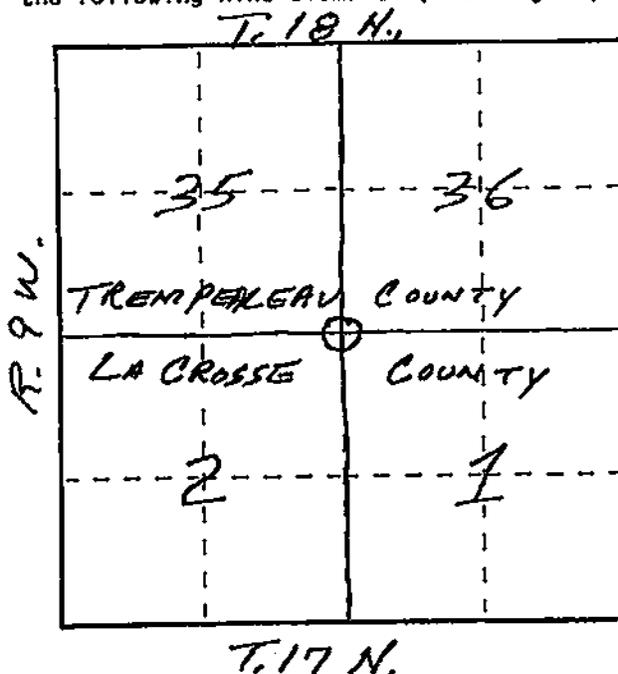


- (b) Describe any record evidence, monument evidence, occupational evidence, testimonial evidence or any other material evidence you considered, and whether the monument was found or placed.

FOUND MONUMENT: U.S. BIOLOGICAL SURVEY MON.,
CONCRETE WITH BRASS DISK, AS DESCRIBED IN
CORPS OF ENGINEERS NOTES FROM 1931 SURVEY.

- (c) In the plan view drawing below, provide reference ties to at least 4 witness monuments, or, if the location is within a municipality, to at least 2 witness monuments. (Witness monuments shall be made of concrete, natural stone, iron or other equally durable material.) Describe witness monuments.

- (d) Show a plan view drawing depicting the relevant monuments and reference ties which is sufficient in detail to enable accurate relocation of the corner monument if the corner monument is disturbed. Indicate north.

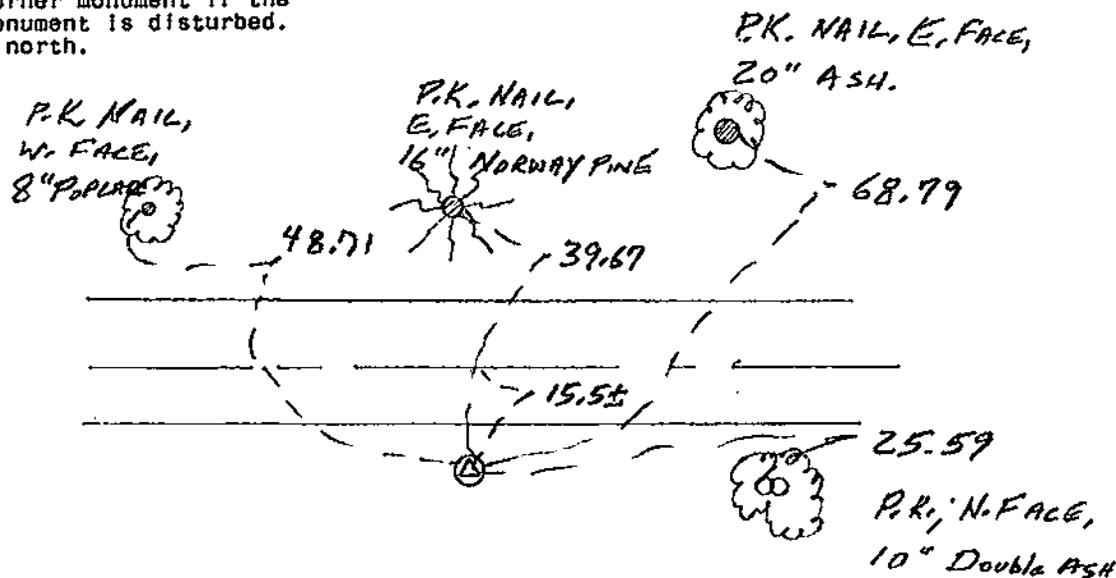

(e) Describe any material discrepancy between the location of the corner as restored or reestablished and the location of that corner as previously restored or reestablished by distance and direction. Show the discrepancy on the plan view drawing under (d), above. Show the distances between the corner as previously restored or reestablished and (1) the corner as restored or reestablished, and (2) to at least 2 of the witness monuments shown on the drawing in (d), above.

NONE

(f) Was the corner restored through acceptance of (1) an obliterated evidence location, or, (2) a found perpetuated location?

(g&h) Was the corner reestablished through lost corner proportionate methods? If so, show the method, including the directions and distances to other public land survey corners used as evidence or used for proportioning in determining the corner location?

No.

(i) I, KEITH M. GRAHAM
(type or print name) certify that the corner location shown on this record was determined by me or under my direction and control and that this U.S. Public Land Survey Monument Record is correct and complete to the best of my knowledge and belief.

Signature

Date

Affix Land Surveyor Seal



Keith M. Graham Dec. 3, 1984