

21709360020

TREMPEALEAU COUNTY

U.S. PUBLIC LAND SURVEY MONUMENT RECORD

QUARTER Corner common to Sections 1 & 36
 T. 17 & 18 N., R. 9 W.
 Type of monument 7/8" X 80" REBAR WITH ALUMINUM CAP
 Location indicated on sketch -  -

36 T18N	36 T17N
1	1


Location Sketch

Describe any record evidence, monument evidence, occupational evidence, testimonial evidence or any other material evidence you considered, and whether the monument was found or placed.

ORIGINAL GOVERNMENT ACCESSORIES WERE SEARCHED FOR, BUT NOTHING WAS FOUND. OTHER MONUMENT EVIDENCE WAS SEARCHED FOR, BUT NONE WAS FOUND. A 1-1/4" IRON PIPE WAS PLACED AT THIS CORNER IN 1931 BY THE UNITED STATES BIOLOGICAL SURVEY. IN 1932 THE UNITED STATES ENGINEER OFFICE TRAVERSED THE SOUTH LINE OF SECTION 36-18-9. THEIR FIELD NOTES DO NOT INDICATE FINDING THE IRON PIPE PLACED A YEAR EARLIER BY THE BIOLOGICAL SURVEY. IT APPEARS AS THOUGH THE IRON PIPE MAY HAVE ALREADY BEEN LOST AT THAT TIME. THIS CORNER WAS REESTABLISHED BY LOST CORNER METHODS, IN THE SAME FASHION AS THE BIOLOGICAL SURVEY, BETWEEN THE SOUTHWEST CORNER OF SECTION 36-18-9 AND THE SOUTH QUARTER CORNER OF SECTION 31-18-8. THIS POSITION MATCHES U.S.E.O. DISTANCE TO THE SOUTHWEST CORNER OF SECTION 36-18-9 BY ABOUT 1 FOOT. IT MATCHES THE BIOLOGICAL SURVEY DISTANCE TO THE SOUTHWEST CORNER OF SECTION 36-18-9 BY ABOUT 11 FEET. IT MATCHES ORIGINAL GOVERNMENT DISTANCE TO THE SOUTHWEST CORNER OF SECTION 36-18-9 BY ABOUT 10 FEET. IT ALSO MATCHES NORTH/SOUTH OCCUPATION AT THE SOUTHWEST CORNER OF THE EAST 1/4 RODS OF THE SW 1/4 OF THE NE 1/4 OF SECTION 36-18-9 BY LESS THAN 1 FOOT. THEREFORE BELIEVING THIS POSITION, AS DESCRIBED, TO BE THE BEST AVAILABLE EVIDENCE OF THIS CORNER'S ORIGINAL LOCATION, A 7/8" X 80" REBAR WITH AN ALUMINUM CAP WAS SET IN A LOW, SWAMPY AREA AND REFERENCED AS SHOWN BELOW.

Show a plan view drawing depicting the relevant monuments, providing reference ties to at least 4 witness monuments. Describe witness monuments. Show relationship to occupation.

- o SET 5/8" X 24" REBAR WITH PLASTIC CAP

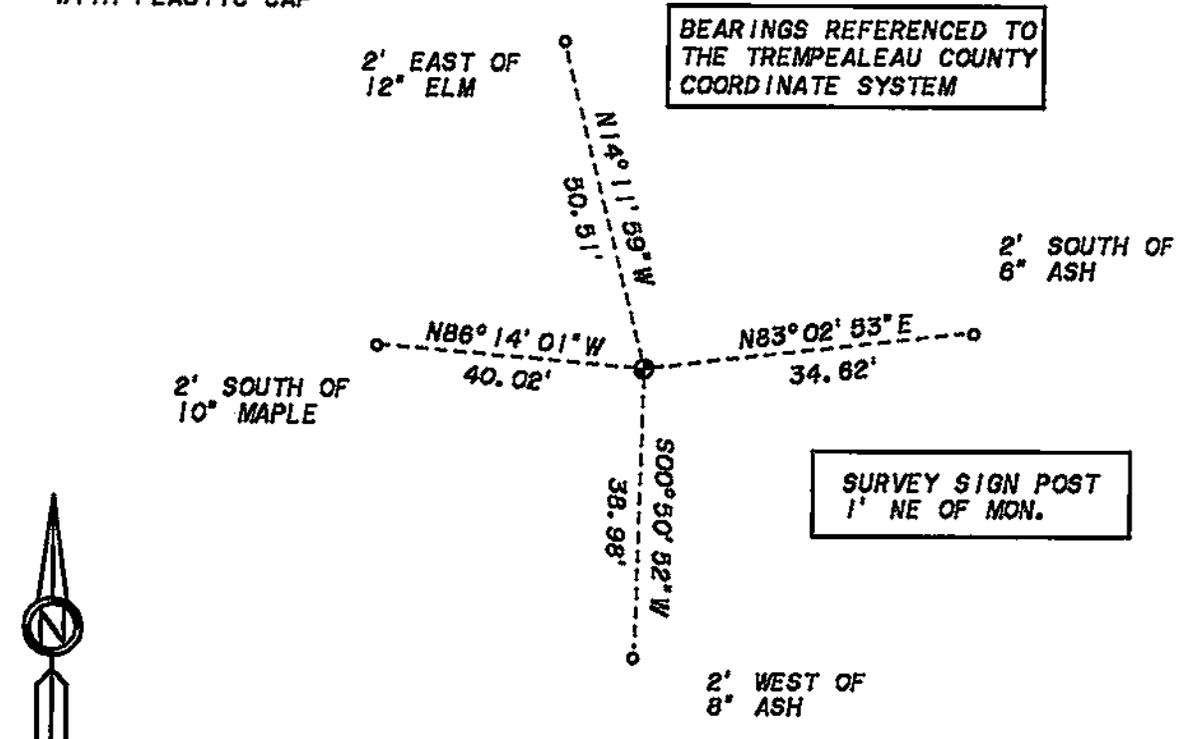

no scale

Corner Identifier number 100-336

Describe any material discrepancy between the location of the corner as restored or reestablished and the location of that corner as previously restored or reestablished by distance and direction. Show the discrepancy on the plan view drawing. Show the distances between the corner as restored or reestablished, and (1) the corner as restored or reestablished, and (2) to at least 2 of the witness monuments shown on the drawing.

NO ACTUAL MONUMENT DISCREPANCY WAS FOUND, ALTHOUGH THIS POSITION MAY NOT REFLECT THE EXACT POSITION REQUIRED FOR J. ALLEN AND R. WALTER SURVEYS LOCATED IN SECTION 36-18-9.

Was the corner restored through acceptance of (1) an obliterated evidence location, (2) a found perpetuated location, or (3) an existent corner location?

N/A.

Was the corner reestablished through lost corner proportionate methods? If so, show the method including the directions and distances to other public land survey corners used as evidence or used for proportioning in determining the corner location.

**YES. SINGLE PROPORTIONATE MEASUREMENT WAS USED BETWEEN THE SOUTHWEST CORNER OF SECTION 36-18-9 AND THE SOUTH QUARTER CORNER OF SECTION 31-18-8. CORNER WAS SET ON A STRAIGHT LINE BETWEEN SAID CORNERS WITH NO ADJUSTMENT FOR THE LATITUDE CURVE, DUPLICATING THE METHOD UTILIZED BY THE UNITED STATES BIOLOGICAL SURVEY OF 1931.
SW CORNER OF SECTION 36 TO SOUTH QUARTER CORNER = N89°55'55"E, 2680.32 FT.
SOUTH QUARTER COR. TO SOUTH QUARTER COR. SEC. 31 = N89°55'55"E, 6300.64 FT.
(BEARINGS REFERENCED TO THE TREMPLEAU COUNTY COORDINATE SYSTEM)**

Show the corner history of record in chronological order from Original Government Survey to present.

**ORIGINAL GOVERNMENT SURVEY - JAS. FREEMAN - JANUARY 1845
SET POST QUARTER SECTION CORNER. MARKED TWO BEARING TREES.**

**UNITED STATES BIOLOGICAL SURVEY - CAMPBELL - SEPTEMBER 1931
SURVEYS FOR WILD LIFE REFUGE NEAR THE MISSISSIPPI RIVER. SETS A 1-1/4" X 45" IRON PIPE AT THE SOUTH QUARTER CORNER OF SECTION 36-18-9. MARKED ONE BEARING TREE.**

**UNITED STATES ENGINEER OFFICE - WIELDE - JUNE 1932
SURVEYS FOR LOCK AND DAM SYSTEM ALONG THE MISSISSIPPI RIVER. TRAVERSES THE SOUTH LINE OF SECTION 36-18-9. NOTES DO NOT INDICATE FINDING ANY CORNER EVIDENCE AT THE SOUTH QUARTER CORNER OF SECTION 36.**

**PRIVATE LAND SURVEYOR'S RECORDS - J. ALLEN - (?)
SURVEYS PARCEL IN SECTION 36-18-9. TIES SURVEY TO 1/16TH CORNER ON NORTH LINE OF SE 1/4 OF SECTION 36, APPARENTLY UTILIZED U.S. CORP. OF ENGINEERS SURVEYS IN AREA. NO MENTION OF SOUTH QUARTER CORNER OF SECTION 36.**

**PRIVATE LAND SURVEYOR'S RECORDS - R. WALTER - NOVEMBER 1995
SURVEYS PARCEL IN SECTION 36-18-9. MAP SHOWS MATHEMATICAL LOCATION OF NE CORNER OF NW 1/4 OF THE SE 1/4. APPARENTLY UTILIZED U.S. CORP. OF ENGINEERS SURVEY INFORMATION IN THIS AREA.**

I, JOSEPH P. NELSEN
certify that the corner location shown on this record was determined by me or under my direction and control and that this U.S. Public Land Survey Monument Record is correct to the best of my knowledge and belief.

Joseph P. Nelsen 7-15-99
Signature Date

Affix Land Surveyor Seal

