


U. S. PUBLIC LAND SURVEY MONUMENT RECORD

SECTION 12 T 18 N, R 5 W, TOWN OF BURNS

LA CROSSE COUNTY

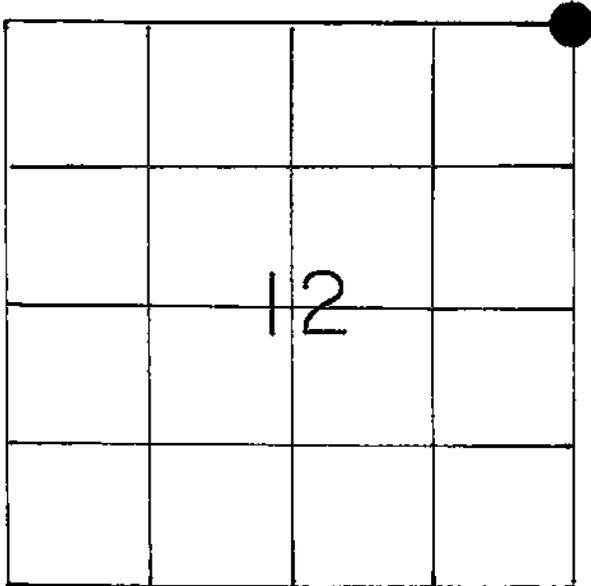

LOCATION OF LANDMARK

Crew: William Jung
 Perry Dahl
 8/6/85

Describe any record evidence, monument evidence, testimonial evidence or any other material evidence you considered and whether the monument was found or restored through acceptance of an obliterated evidence location.

After traversing a mile to the North, South, and West, I accepted the old occupied fence corner as the best available evidence of the original government corner. Fred Holden, the old Monroe County Surveyor, was at this corner in April of 1908. I could not find his old bearing tree.

Describe or show any material discrepancy between the location of the restored corner and that of the corner previously restored or reestablished.

None

WISCONSIN COORDINATE SYSTEM

North

East

Theta Angle

Horiz. Order

Vert. Order

TYPE OF LANDMARK

BERNTSEN


BEARINGS ARE REFERENCED TO

Assumed


RECORD OF DURABLE WITNESS MONUMENTS

NO	DESCRIPTION	BEARING	DISTANCE
1	10" DOUBLE-BLAZED OAK WITH P.K. NAIL	N20°W	33.69'
2	5" DOUBLE-BLAZED WHITE PINE WITH P.K. NAIL	S82°W	61.92'
3	8" DOUBLE-BLAZED OAK WITH P.K. NAIL	S36°E	38.92'
4	14" DOUBLE-BLAZED JACK PINE WITH P.K. NAIL	N51°E	36.67'

* Magnetic bearings by a hand compass.

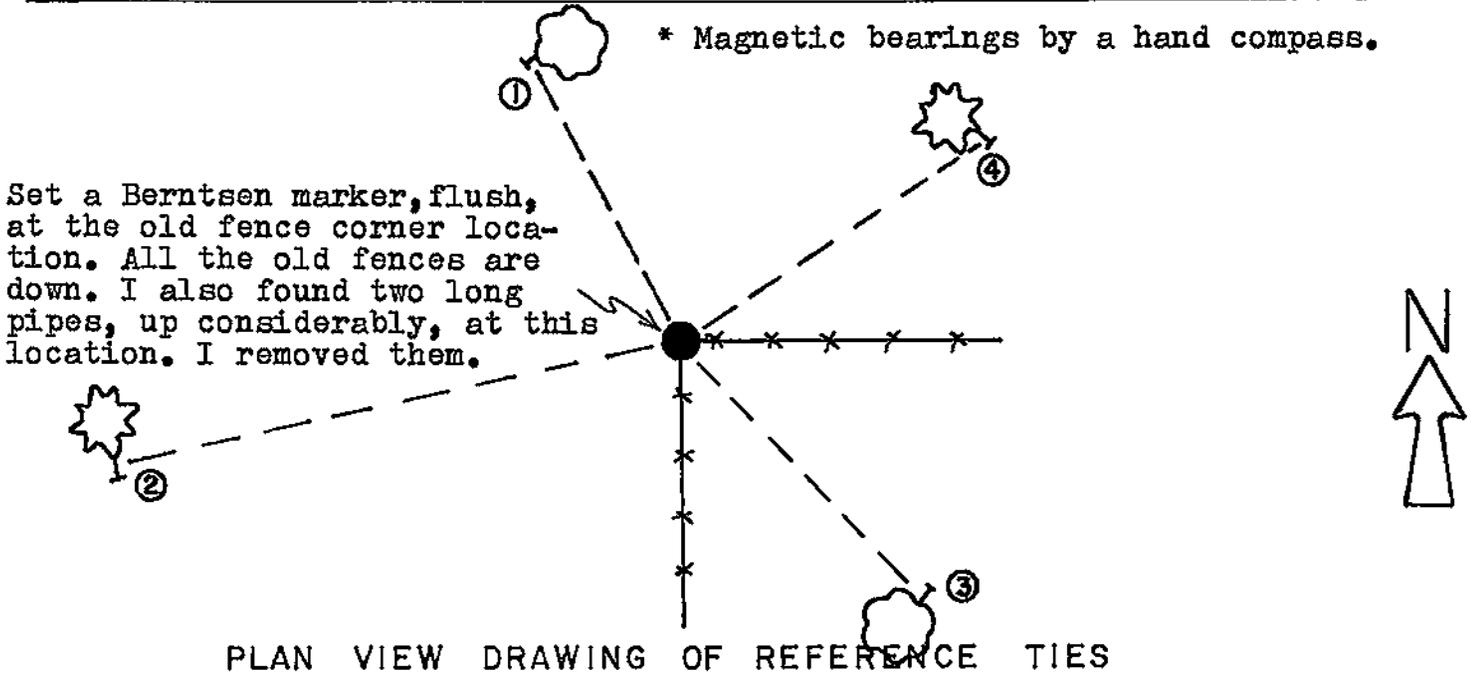

MAP SHOWING DISTANCE AND DIRECTION TO OTHER PUBLIC LAND SURVEY CORNERS USED FOR REESTABLISHING THE CORNER

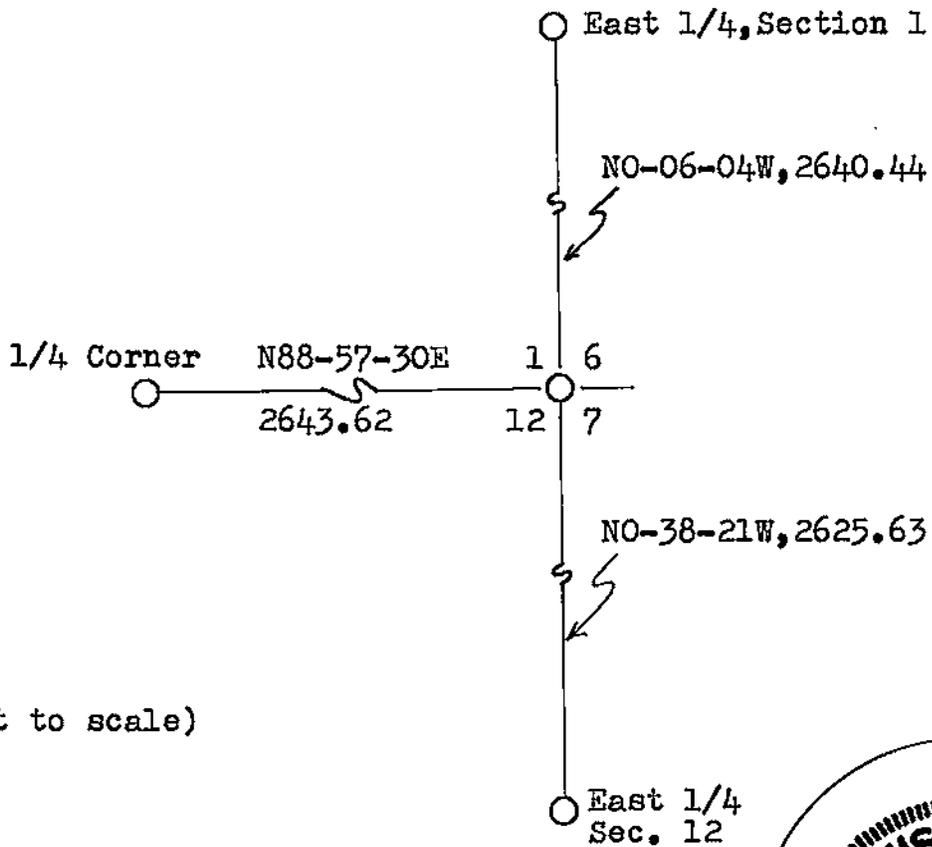

(Not to scale)

I, William C. Jung, Deputy County Surveyor,
 HEREBY CERTIFY THAT THE CORNER LOCATION SHOWN ON THIS RECORD
 WAS DETERMINED BY ME OR UNDER MY DIRECTION AND CONTROL AND
 THAT THIS U. S. PUBLIC LAND SURVEY MONUMENT RECORD IS CORRECT
 AND COMPLETE TO THE BEST OF MY KNOWLEDGE AND BELIEF.

William C. Jung 8/27/85
 Signature Date

