


## U. S. PUBLIC LAND SURVEY MONUMENT RECORD

SECTION 12 T 18 N, R 5 W, TOWN OF BURNS

LA CROSSE COUNTY

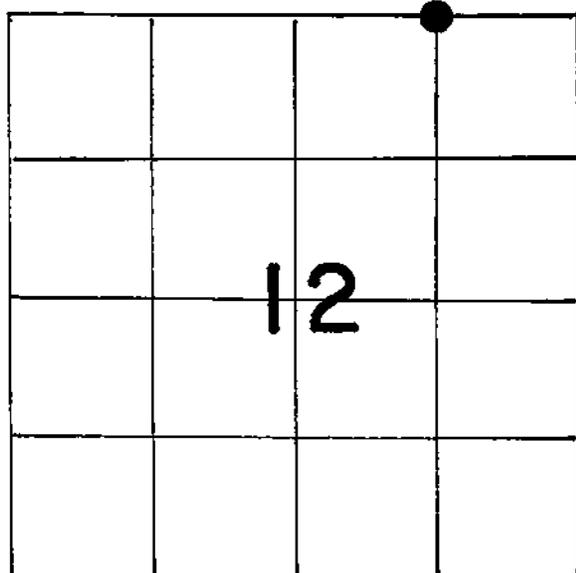

LOCATION OF LANDMARK

Crew: William Jung  
 Perry Dahl  
 9/16/85

Describe any record evidence, monument evidence, testimonial evidence or any other material evidence you considered and whether the monument was found or restored through acceptance of an obliterated evidence location.

The corner was set "as per law", on line and equidistant between the 1/4 and section corners.

Describe or show any material discrepancy between the location of the restored corner and that of the corner previously restored or reestablished.

None known

WISCONSIN COORDINATE SYSTEM

North

East

Theta Angle

Horiz. Order

Vert. Order

TYPE OF LANDMARK

1½" IRON PIPE


BEARINGS ARE REFERENCED TO

Assumed

RECORD OF DURABLE WITNESS MONUMENTS


NO	DESCRIPTION	BEARING	DISTANCE
1	P.K. NAIL IN 5" DOUBLE-BLAZED JACK PINE	S85°W	19.25'
2	P.K. NAIL IN 7" DOUBLE-BLAZED JACK PINE	S41°E	14.26'
3	P.K. NAIL IN 12" DOUBLE-BLAZED OAK TREE	S69°E	18.00'
4	P.K. NAIL IN 6" DOUBLE-BLAZED OAK TREE	N21°E	19.76'

\* Magnetic bearings by a hand compass.

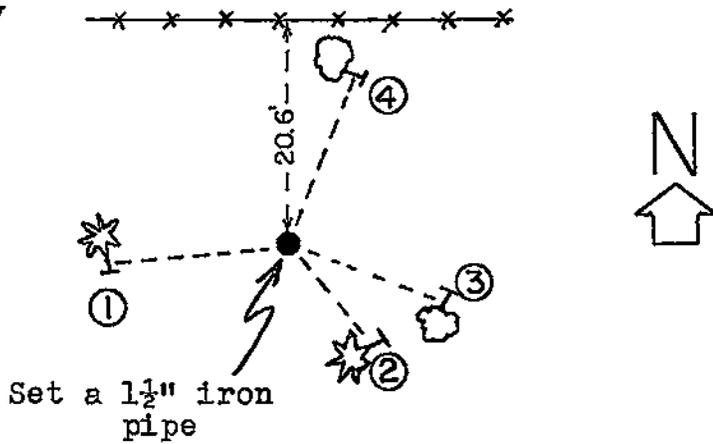

PLAN VIEW DRAWING OF REFERENCE TIES

MAP SHOWING DISTANCE AND DIRECTION TO OTHER PUBLIC LAND SURVEY CORNERS USED FOR REESTABLISHING THE CORNER

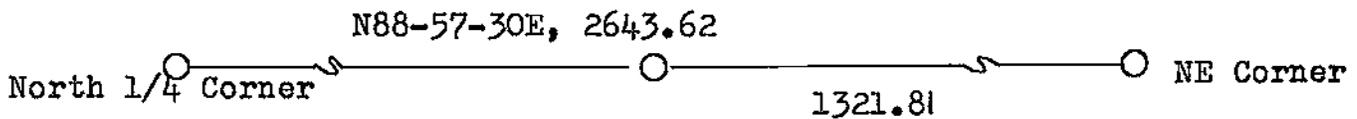

(Not to scale)

I, William C. Jung, Deputy County Surveyor  
 HEREBY CERTIFY THAT THE CORNER LOCATION SHOWN ON THIS RECORD  
 WAS DETERMINED BY ME OR UNDER MY DIRECTION AND CONTROL AND  
 THAT THIS U. S. PUBLIC LAND SURVEY MONUMENT RECORD IS CORRECT  
 AND COMPLETE TO THE BEST OF MY KNOWLEDGE AND BELIEF.

William C. Jung                      9/17/85  
 Signature                                      Date



Seal