


U. S. PUBLIC LAND SURVEY MONUMENT RECORD

SECTION 12 T 18 N, R 5 W, TOWN OF BURNS

LA CROSSE COUNTY

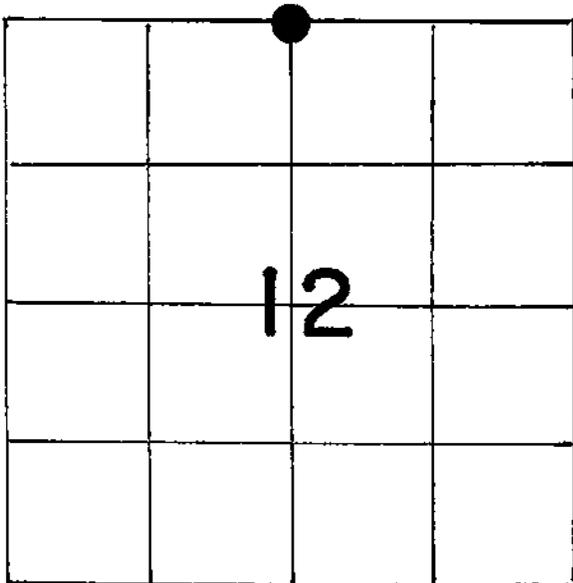

LOCATION OF LANDMARK

WISCONSIN COORDINATE SYSTEM
North
East
Theta Angle
Horiz. Order
Vert. Order
TYPE OF LANDMARK BERNTSEN
BEARINGS ARE REFERENCED TO Assumed

Crew: William Jung
8/9/85

Describe any record evidence, monument evidence, testimonial evidence or any other material evidence you considered and whether the monument was found or restored through acceptance of an obliterated evidence location.

I set this corner on line and equidistant between the section corners. I believe that the old fence corner, N61-03W, 78.08 feet, is "wild" and in error.

Describe or show any material discrepancy between the location of the restored corner and that of the corner previously restored or reestablished.

This corner does not fit the occupied conditions. It falls 66.3 feet East of the line fence and 40.6 feet South of the line fence.

