


## U. S. PUBLIC LAND SURVEY MONUMENT RECORD

SECTION 1 T 18 N, R 5 W, TOWN OF BURNS

LA CROSSE COUNTY

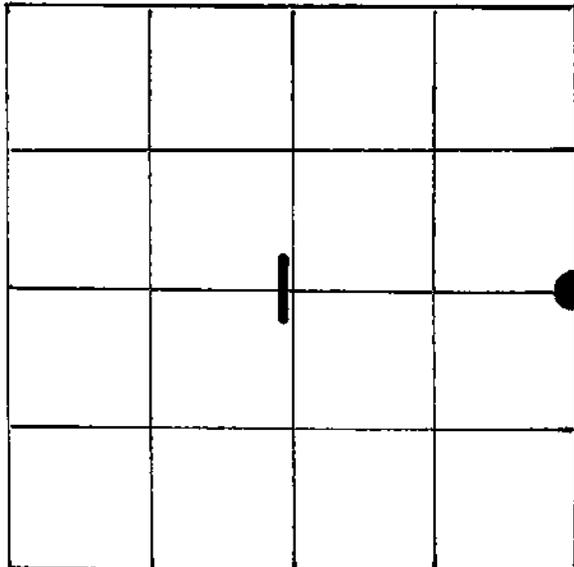

LOCATION OF LANDMARK

Crew: William Jung  
 Perry Dahl  
 6/20/85

Describe any record evidence, monument evidence, testimonial evidence or any other material evidence you considered and whether the monument was found or restored through acceptance of an obliterated evidence location.

Fred Holden, the old Monroe County Surveyor, re-established this corner in April of 1908. "Duke" Marten set a Harrison marker at this corner on August 15, 1974 after traversing out Section 6-T18N-R4W. I found this Harrison marker. Marten's bearing trees were both gone.

Describe or show any material discrepancy between the location of the restored corner and that of the corner previously restored or reestablished.

None known.

WISCONSIN COORDINATE SYSTEM

North

East

Theta Angle

Horiz. Order

Vert. Order

TYPE OF LANDMARK  
 HARRISON MARKER

BEARINGS ARE REFERENCED TO  
 Assumed



I, Harley A. Stine, do hereby certify that on the 15th day of August, 1974, I found (~~evidence~~) (no evidence) of the W 1/4 corner of Section 6, T 18 N, R 4 W Fourth Principal Meridian, and I re-established said corner according to the Wisconsin Statutes as shown and described hereon.

Dated this 7th day of Feb., 1978.

County Surveyor Approved: HARLEY A. STINE  
 Title MONROE CO. SURVEYOR

Description of corner and witness monuments, references and accessories used to perpetuate the original or re-established location of this corner:

Witnesses to corner location:



D. Marten

History of original corner establishment:

Fred Holden re-established this corner in April of 1908.

Description of corner evidence found:

Set Harrison Monument 4" below surface of gravel road. Traversed Section 6 and set the corner at a computed location.

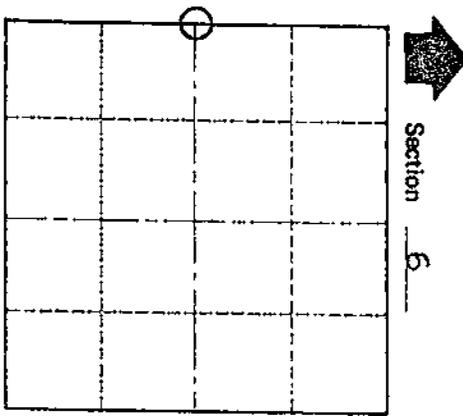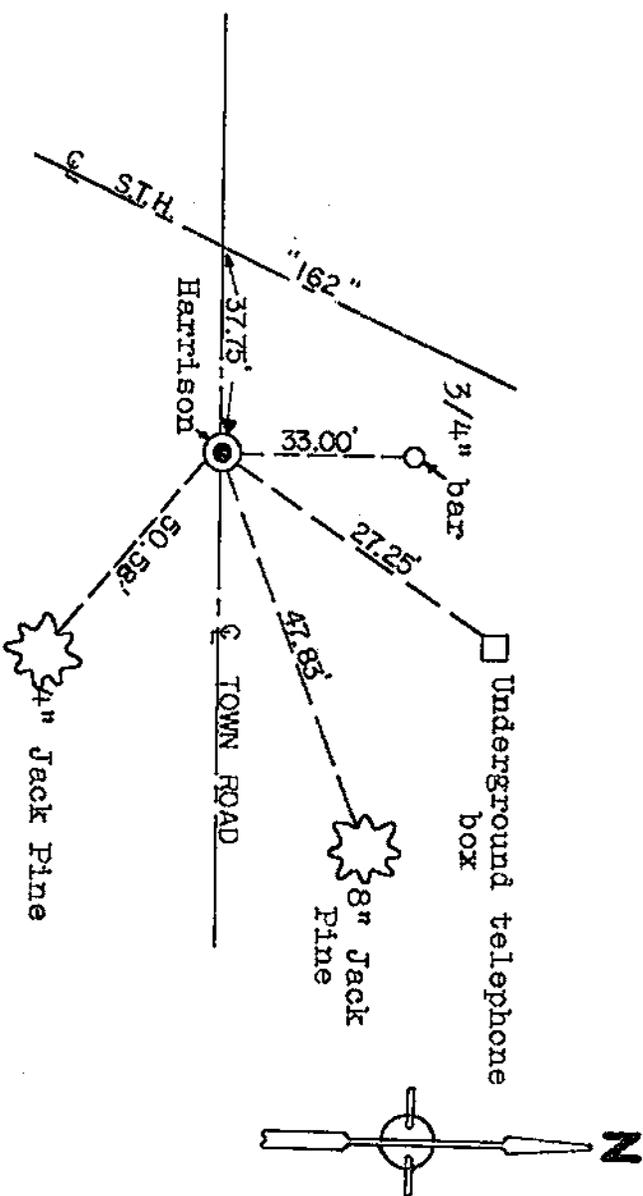

SURVEY CONTROL ORDER			
Horizontal		East (X)	North (Y)
Vertical			Elevation (Z)
Corner			Zone
Control Sta. Name			

WISCONSIN COORDINATE SYSTEM

City, Village or Town Little Falls

County of Monroe