


U. S. PUBLIC LAND SURVEY MONUMENT RECORD

SECTION 12 T 18 N, R 5 W, TOWN OF BURNS  
 LA CROSSE COUNTY

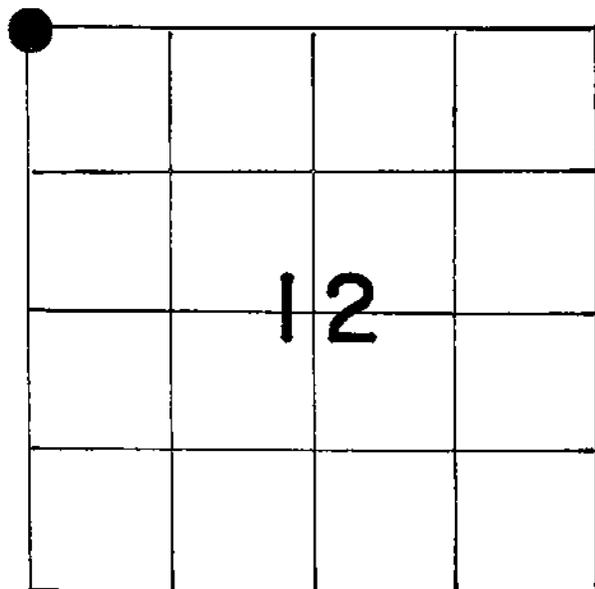

LOCATION OF LANDMARK

Crew: William Jung  
 8/8/85

WISCONSIN COORDINATE SYSTEM
North
East
Theta Angle
Horiz. Order
Vert. Order
TYPE OF LANDMARK
BERNTSEN
BEARINGS ARE REFERENCED TO
Assumed

Describe any record evidence, monument evidence, testimonial evidence or any other material evidence you considered and whether the monument was found or restored through acceptance of an obliterated evidence location.

Norm Hurlburt traversed to this corner in 1983, as did Bob Chalsma last year. After traversing a mile to the South and East and then studying my data along with that of Chalsma and Hurlburt, I accepted the old occupied fence corner as the best available evidence of the original government corner.


Describe or show any material discrepancy between the location of the restored corner and that of the corner previously restored or reestablished.

None known

RECORD OF DURABLE WITNESS MONUMENTS


NO	DESCRIPTION	BEARING	DISTANCE
1	IRON PIPE	NORTH ±	25'
2	P.K. NAIL IN 6" DOUBLE-BLAZED OAK TREE	N30°E	41.61'
3	P.K. NAIL IN 9" DOUBLE-BLAZED OAK TREE	N43°E	34.11'
4	P.K. NAIL IN 14" DOUBLE-BLAZED OAK TREE	S81°E	63.89'

\*Magnetic bearings by a hand compass.

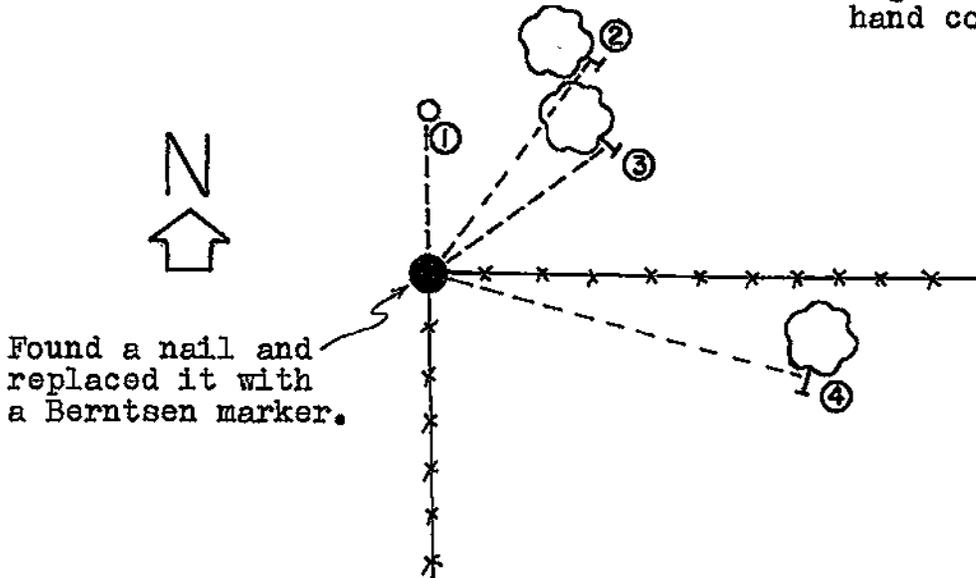


PLAN VIEW DRAWING OF REFERENCE TIES

MAP SHOWING DISTANCE AND DIRECTION TO OTHER PUBLIC LAND SURVEY CORNERS USED FOR REESTABLISHING THE CORNER

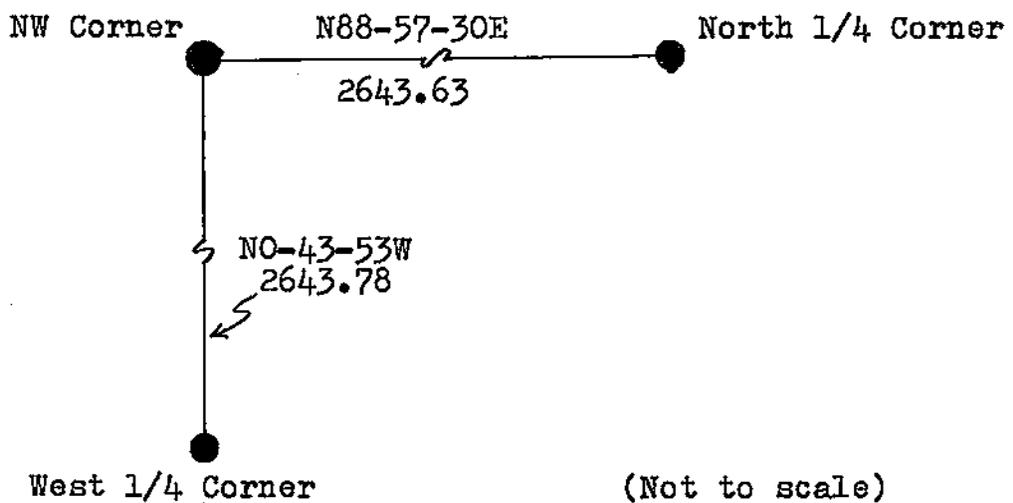

I, William C. Jung, Deputy County Surveyor,  
 HEREBY CERTIFY THAT THE CORNER LOCATION SHOWN ON THIS RECORD  
 WAS DETERMINED BY ME OR UNDER MY DIRECTION AND CONTROL AND  
 THAT THIS U. S. PUBLIC LAND SURVEY MONUMENT RECORD IS CORRECT  
 AND COMPLETE TO THE BEST OF MY KNOWLEDGE AND BELIEF.

William C. Jung 8/30/85  
 Signature Date

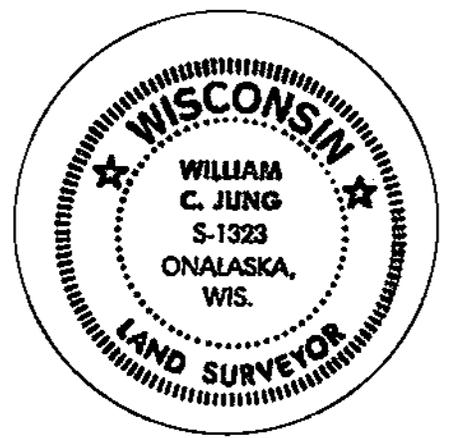

Seal