


21805030020

U. S. PUBLIC LAND SURVEY MONUMENT RECORD

SECTION 3 T 18 N, R 5 W, TOWN OF FARMINGTON

LA CROSSE COUNTY

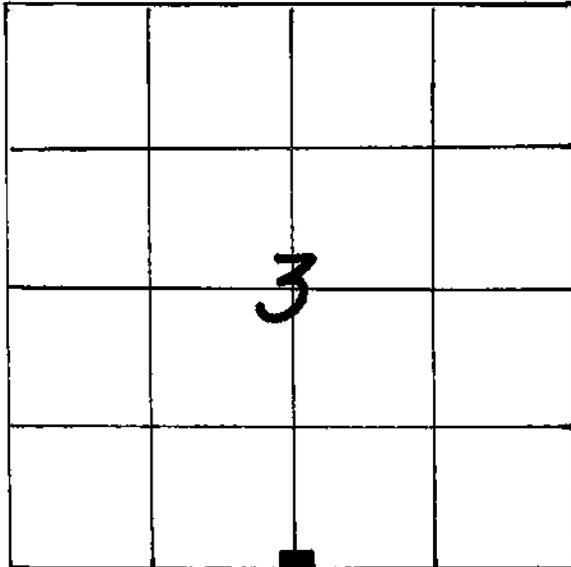

LOCATION OF LANDMARK

DATE: 4-3-85

CREW: BILL JUNG
PERRY DAHL

Date: 5-5-97

Crew: Bill Jung
Peter Follansbee

WISCONSIN COORDINATE SYSTEM

North

East

Theta Angle

Horiz. Order

Vert. Order

TYPE OF LANDMARK

STONE MONUMENT

BEARINGS ARE REFERENCED TO

Describe any record evidence, monument evidence, testimonial evidence or any other material evidence you considered and whether the monument was found or restored through acceptance of an obliterated evidence location.

Bob Chalsma found an unrecorded stone at the occupied corner. I accepted this monument as the best available evidence of the original government corner position.

1997- We found the stone in good condition and set a sign and post on the North side of it. We also made two new bearing trees as two of the old ones were gone.

Describe or show any material discrepancy between the location of the restored corner and that of the corner previously restored or reestablished.

None known.

