


21805032000

U. S. PUBLIC LAND SURVEY MONUMENT RECORD

SECTION 2 T 18 N, R 5 W, TOWN OF BURNS

LA CROSSE COUNTY

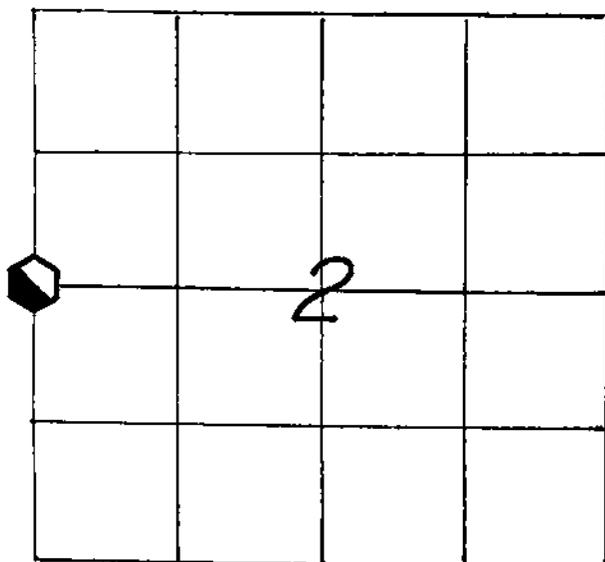

LOCATION OF LANDMARK

CREW: WILLIAM C. JUNG
 PETER F. FOLLANSBEE
 DATE: 3/26/2007

WISCONSIN COORDINATE SYSTEM	
North	753,931.774
East	1,717,974.279
Theta Angle	
Horiz. Order	
Vert. Order	
DATUM:	1983('91)
TYPE OF LANDMARK	
30" ALUMINUM BERNTSEN MARKER.	
BEARINGS ARE REFERENCED TO	
GRID NORTH AS PER SECTION DATA.	

Describe any record evidence, monument evidence, testimonial evidence or any other material evidence you considered and whether the monument was found or restored through acceptance of an obliterated evidence location.


Rodney Maxwell had a computed location for this corner as per his 1997 surveys. It appears to be very close to the proportionate position. I am assuming that he had further interior evidence in Section 2 to come up with this location. There is no evidence at the actual corner. I therefore set the corner at Maxwell's position. A Berntsen marker was set.

Describe or show any material discrepancy between the location of the restored corner and that of the corner previously restored or reestablished.

NONE KNOWN.


RECORD OF DURABLE WITNESS MONUMENTS

NO	DESCRIPTION	MAGNETIC	
		BEARING	DISTANCE
1	SET A 3/4" x 30" IRON BAR WITH A RED PLASTIC CAP	S 77° W	51.17 FT.
2	SET A 3/4" x 30" IRON BAR WITH A RED PLASTIC CAP	N 09° W	37.61 FT.
3	SET A 3/4" x 30" IRON BAR WITH A RED PLASTIC CAP	N 78° E	29.83 FT.
4	SET A 3/4" x 30" IRON BAR WITH A RED PLASTIC CAP	S 07° E	31.24 FT.

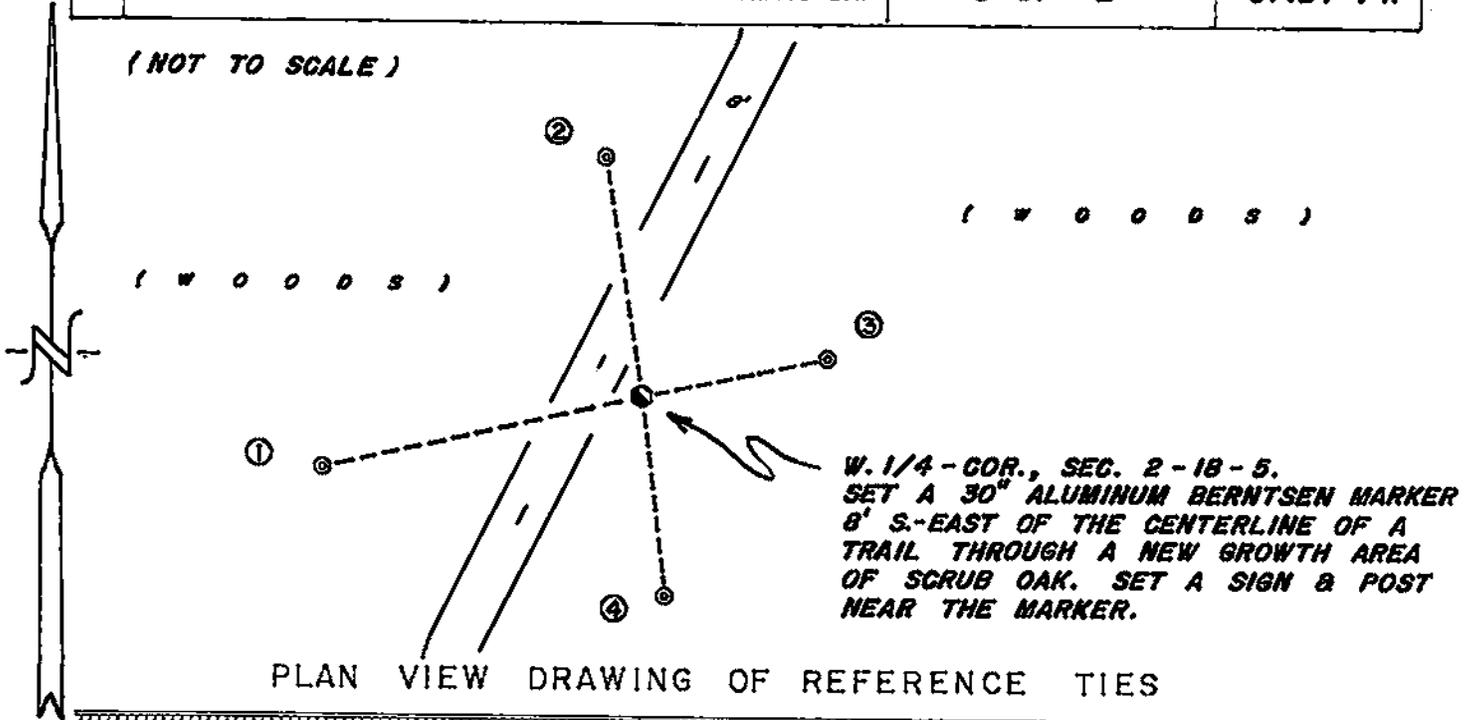

MAP SHOWING DISTANCE AND DIRECTION TO OTHER PUBLIC LAND SURVEY CORNERS USED FOR REESTABLISHING THE CORNER

(GRID BEARINGS AND DISTANCES)
 (GRID FACTOR: 0.999951)
 (NOT TO SCALE)

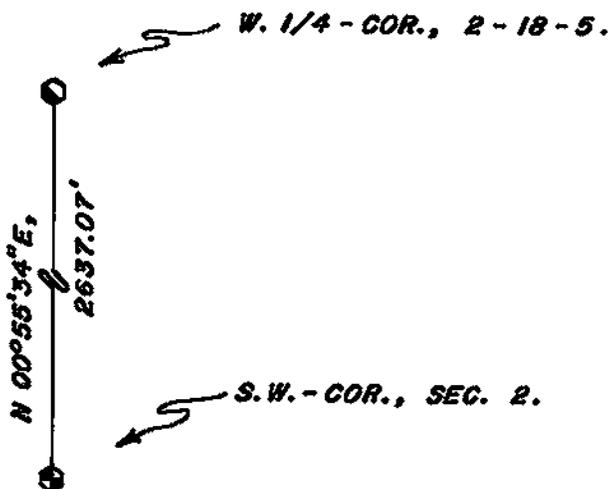

I, WILLIAM C. JUNG, COUNTY SURVEYOR
 HEREBY CERTIFY THAT THE CORNER LOCATION SHOWN ON THIS RECORD
 WAS DETERMINED BY ME OR UNDER MY DIRECTION AND CONTROL AND
 THAT THIS U. S. PUBLIC LAND SURVEY MONUMENT RECORD IS CORRECT
 AND COMPLETE TO THE BEST OF MY KNOWLEDGE AND BELIEF.

William C. Jung 4/17/07
 Signature Date



Seal