


21805040000

U. S. PUBLIC LAND SURVEY MONUMENT RECORD

SECTION 4 T 18 N, R 5 W, TOWN OF FARMINGTON
 LA CROSSE COUNTY

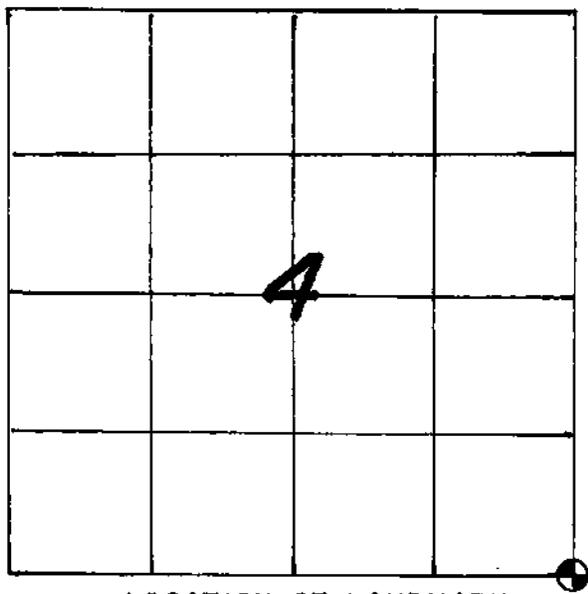

LOCATION OF LANDMARK

WISCONSIN COORDINATE SYSTEM	
North	
East	
Theta Angle	
Horiz. Order	
Vert. Order	
TYPE OF LANDMARK	
1/4" IRON PIPE	Lunde marker
BEARINGS ARE REFERENCED TO ASSUMED	

DATE: 1-22-85
 CREW: BILL JUNG
 MIKE WEIBEL

Date: 11-6-90
 Crew: William C. Jung
 Daniel Leis

Describe any record evidence, monument evidence, testimonial evidence or any other material evidence you considered and whether the monument was found or restored through acceptance of an obliterated evidence location.

I set an iron pipe at the corner after surveying out Section 4 and computing a location that best fits the overall field evidence.

11-6-90

I removed the iron pipe and replaced it with a brass capped Lunde marker. I buried a bottle with a shell casing by the Lunde and also set a sign and post by it.


Describe or show any material discrepancy between the location of the restored corner and that of the corner previously restored or reestablished.

None known.

RECORD OF DURABLE WITNESS MONUMENTS
MAGNETIC

NO	DESCRIPTION	BEARING	DISTANCE
1	P.K. NAIL IN 7" OAK TREE (P.K. in hack)	S53°W	50.60'
2	P.K. NAIL IN 9" OAK TREE "	S19°W	60.40'
3	P.K. NAIL IN 8" OAK TREE "	S49°E	39.03'
4	P.K. NAIL IN 7" OAK TREE "	S. 83°E	13.07'


(ALL TREES ARE DOUBLE BLAZED) ROAD

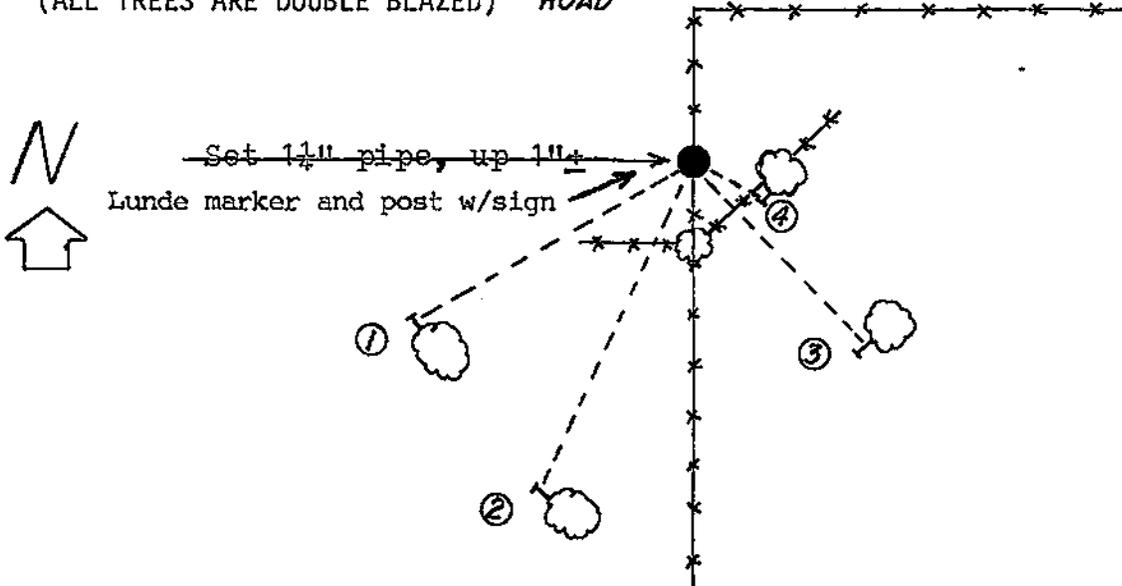

PLAN VIEW DRAWING OF REFERENCE TIES

MAP SHOWING DISTANCE AND DIRECTION TO OTHER PUBLIC LAND SURVEY CORNERS USED FOR REESTABLISHING THE CORNER

(not to scale)

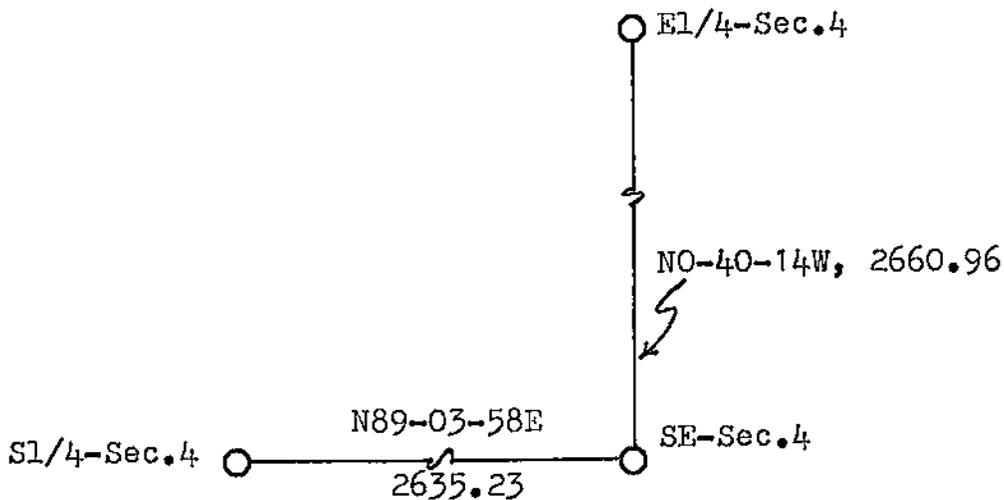


I, William C. Jung, Deputy County Surveyor,
HEREBY CERTIFY THAT THE CORNER LOCATION SHOWN ON THIS RECORD
WAS DETERMINED BY ME OR UNDER MY DIRECTION AND CONTROL AND
THAT THIS U. S. PUBLIC LAND SURVEY MONUMENT RECORD IS CORRECT
AND COMPLETE TO THE BEST OF MY KNOWLEDGE AND BELIEF.

William C. Jung
Signature

3/7/86
Date

Revised: 2/8/91

wey

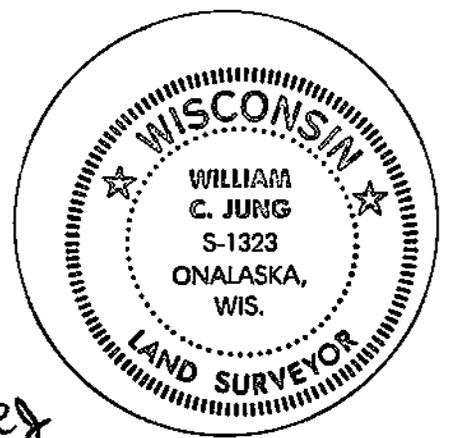

Seal