


U. S. PUBLIC LAND SURVEY MONUMENT RECORD

SECTION 4 T 18 N, R 5 W, TOWN OF FARMINGTON

LA CROSSE COUNTY

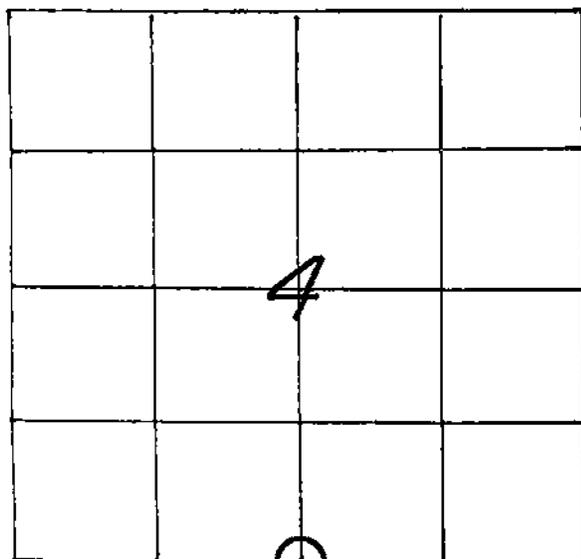

LOCATION OF LANDMARK

CREW: WILLIAM G. JUNG
 PETER F. FOLLANSBEE
 DATE: 3/17/2005

WISCONSIN COORDINATE SYSTEM
North
East
Theta Angle
Horiz. Order
Vert. Order
TYPE OF LANDMARK
1/2" IRON PIPE.
BEARINGS ARE REFERENCED TO
ASSUMED NORTH AS PER SECTION DATA.

Describe any record evidence, monument evidence, testimonial evidence or any other material evidence you considered and whether the monument was found or restored through acceptance of an obliterated evidence location.


I found the pipe that I found back in 1976 and took new ties. (See my old tie sheet for corner history.)

Describe or show any material discrepancy between the location of the restored corner and that of the corner previously restored or reestablished.

NONE KNOWN.

RECORD OF DURABLE WITNESS MONUMENTS


NO	DESCRIPTION	MAGNETIC	
		BEARING	DISTANCE
1	SET A NAIL IN N.E.-SIDE OF A 14" OAK	N 55° W	24.96 FT.
2	SET A NAIL IN E.-SIDE OF A 16" OAK	N 05° W	32.12 FT.
3	SET A NAIL IN S.E.-SIDE OF A 9 1/2" OAK	N 25° E	21.19 FT.
4	SET A NAIL IN S.-SIDE OF A 9 1/2" OAK	S 89° E	12.16 FT.

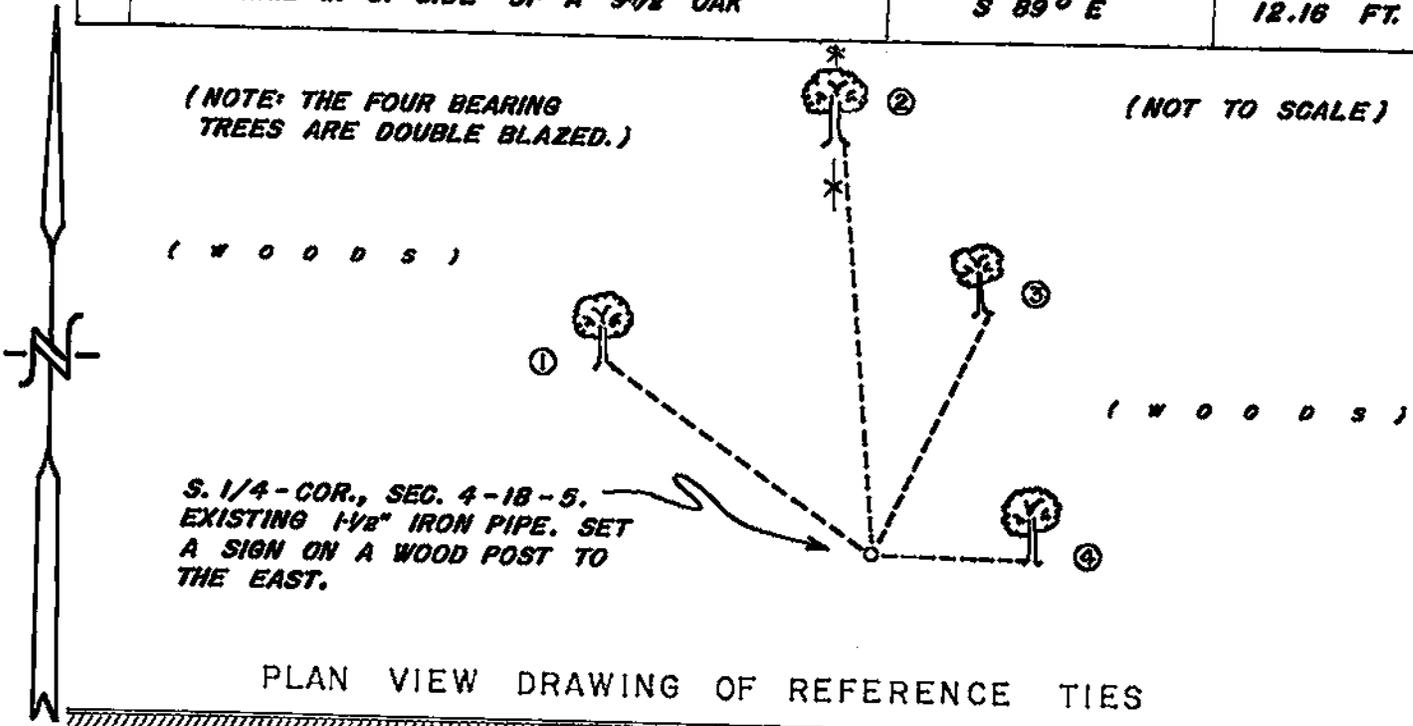

MAP SHOWING DISTANCE AND DIRECTION TO OTHER PUBLIC LAND SURVEY CORNERS USED FOR REESTABLISHING THE CORNER

(ASSUMED BEARINGS)
(NOT TO SCALE)


(my 1984-1985 measurements)

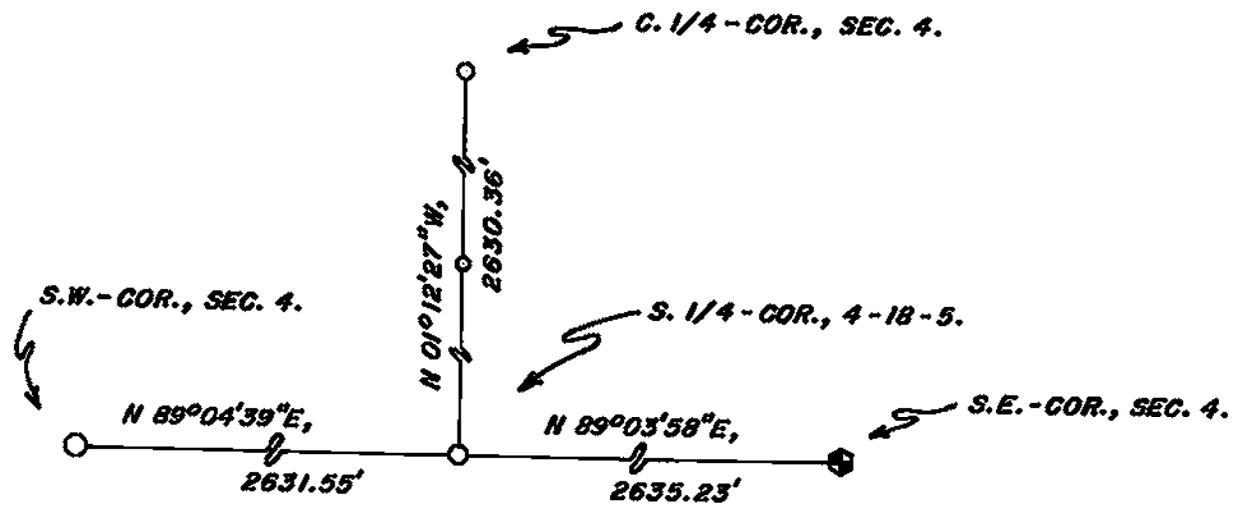

I, WILLIAM G. JUNG, COUNTY SURVEYOR
HEREBY CERTIFY THAT THE CORNER LOCATION SHOWN ON THIS RECORD WAS DETERMINED BY ME OR UNDER MY DIRECTION AND CONTROL AND THAT THIS U. S. PUBLIC LAND SURVEY MONUMENT RECORD IS CORRECT AND COMPLETE TO THE BEST OF MY KNOWLEDGE AND BELIEF.

William G. Jung
Signature


3/14/06
Date

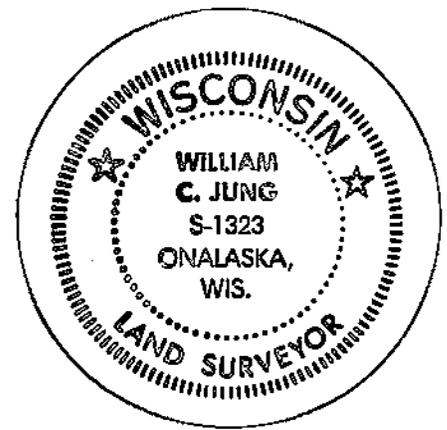

Seal

U. S. PUBLIC LAND SURVEY MONUMENT RECORD

SECTION 4 T 18 N, R 5 W, TOWN OF FARMINGTON
 LA CROSSE COUNTY

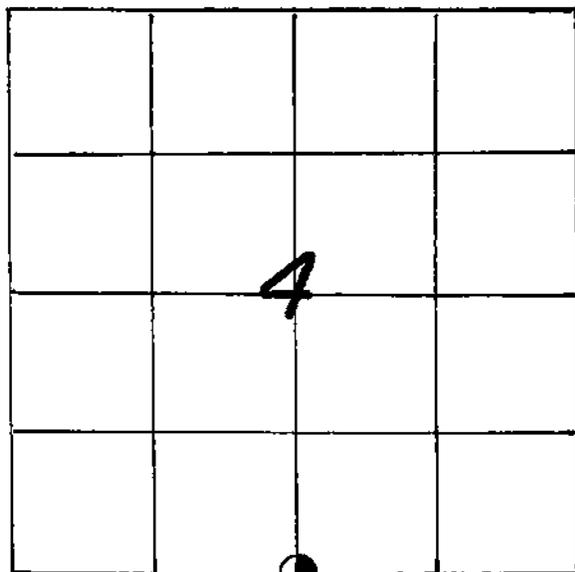

LOCATION OF LANDMARK

DATE: 1-14-85
 CREW: BILL JUNG

WISCONSIN COORDINATE SYSTEM
North
East
Theta Angle
Horiz. Order
Vert. Order
TYPE OF LANDMARK
1 3/8" IRON PIPE
BEARINGS ARE REFERENCED TO ASSUMED

Describe any record evidence, monument evidence, testimonial evidence or any other material evidence you considered and whether the monument was found or restored through acceptance of an obliterated evidence location.


I found an unrecorded pipe at this corner in September of 1976. I do not know who put it in. After surveying out Section 4, I accepted this corner as the best available evidence of the original government corner position.

Describe or show any material discrepancy between the location of the restored corner and that of the corner previously restored or reestablished.

None known.

RECORD OF DURABLE WITNESS MONUMENTS
MAGNETIC


NO	DESCRIPTION	BEARING	DISTANCE
1	NAIL IN 12" DOUBLE BLAZED OAK TREE	N6°W	32.15'
2	NAIL IN 10" DOUBLE BLAZED OAK TREE	N66°W	24.91'
3	NAIL IN 9.5" DOUBLE BLAZED OAK TREE	S73°W	17.17'
4	NAIL IN 5.5" DOUBLE BLAZED OAK TREE	N82°E	12.42'

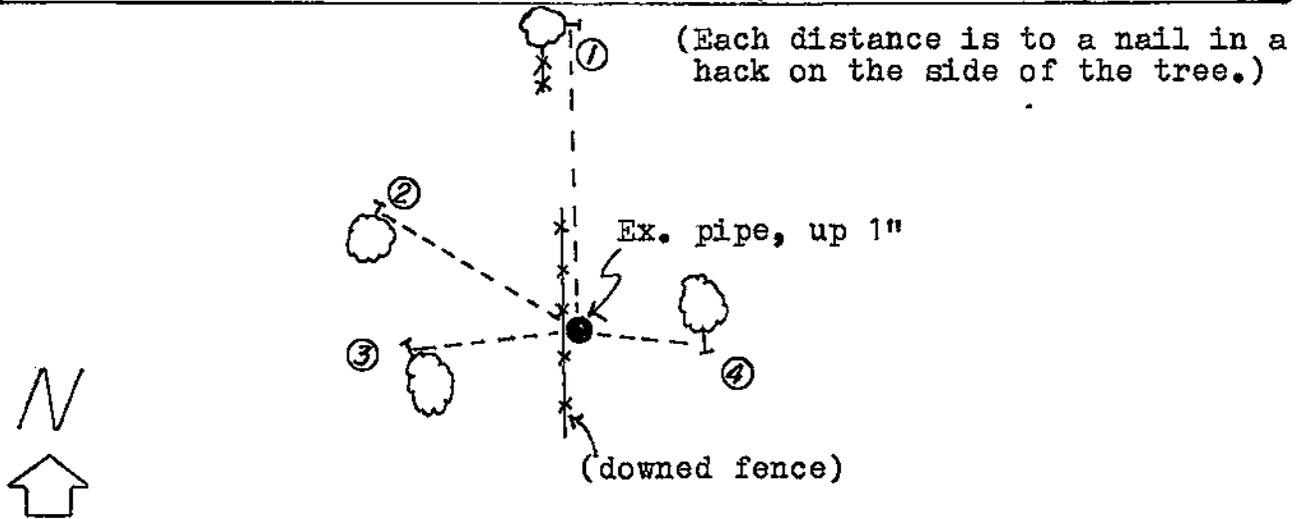

PLAN VIEW DRAWING OF REFERENCE TIES

MAP SHOWING DISTANCE AND DIRECTION TO OTHER PUBLIC LAND SURVEY CORNERS USED FOR REESTABLISHING THE CORNER


(not to scale)

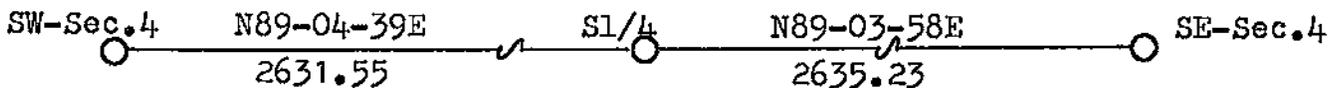

I, William C. Jung, Deputy County Surveyor
HEREBY CERTIFY THAT THE CORNER LOCATION SHOWN ON THIS RECORD
WAS DETERMINED BY ME OR UNDER MY DIRECTION AND CONTROL AND
THAT THIS U. S. PUBLIC LAND SURVEY MONUMENT RECORD IS CORRECT
AND COMPLETE TO THE BEST OF MY KNOWLEDGE AND BELIEF.

William C. Jung
Signature

3/7/86
Date

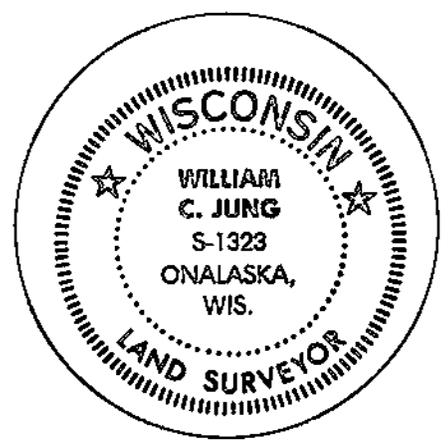

Seal