


21805042000

U. S. PUBLIC LAND SURVEY MONUMENT RECORD

SECTION 4 T 18 N, R 5 W, TOWN OF FARMINGTON

LA CROSSE COUNTY

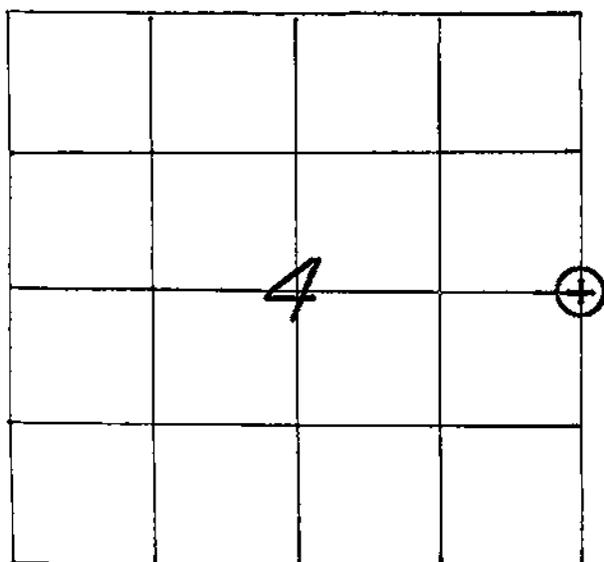

WISCONSIN COORDINATE SYSTEM

North

East

Theta Angle

Horiz. Order

Vert. Order

TYPE OF LANDMARK

3/4"x30" IRON BAR WITH AN ALUMINUM CAP.

BEARINGS ARE REFERENCED TO

ASSUMED NORTH AS PER SECTION DATA.

LOCATION OF LANDMARK

CREW: WILLIAM C. JUNG
 PETER F. FOLLANSBEE
 DATE: 3/17/2005

Describe any record evidence, monument evidence, testimonial evidence or any other material evidence you considered and whether the monument was found or restored through acceptance of an obliterated evidence location.

I found the pipe that I set back in 1985, set an iron bar and cap in it, and took new ties. (See my old tie sheet for corner history.)

Describe or show any material discrepancy between the location of the restored corner and that of the corner previously restored or reestablished.


NONE KNOWN.

RECORD OF DURABLE WITNESS MONUMENTS

| NO | DESCRIPTION | MAGNETIC | |
|----|--|----------|-----------|
| | | BEARING | DISTANCE |
| 1 | EXISTING 3/4" IRON PIPE UNDER A FENCE | S 41° W | 10.92 FT. |
| 2 | SET A NAIL IN N.W.-SIDE OF A 9 1/2" OAK | N 41° E | 11.87 FT. |
| 3 | SET A NAIL IN S.-SIDE OF A 6 1/2" BURR OAK | S 75° E | 15.13 FT. |
| 4 | SET A NAIL IN S.W.-SIDE OF A 10" OAK | S 06° E | 6.75 FT. |


(NOTE: THE FOUR BEARING TREES ARE DOUBLE BLAZED.)

(NOT TO SCALE)

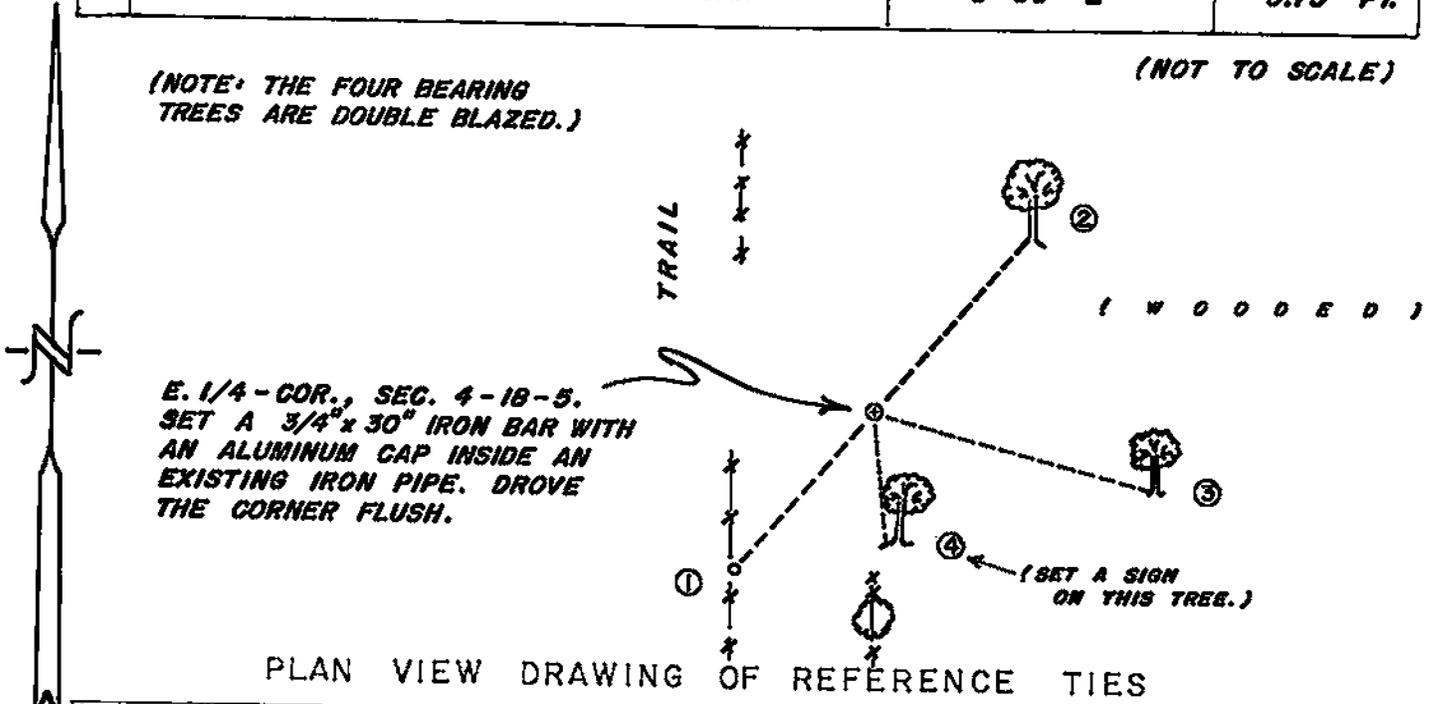

MAP SHOWING DISTANCE AND DIRECTION TO OTHER PUBLIC LAND SURVEY CORNERS USED FOR REESTABLISHING THE CORNER

(ASSUMED BEARINGS)
(NOT TO SCALE)

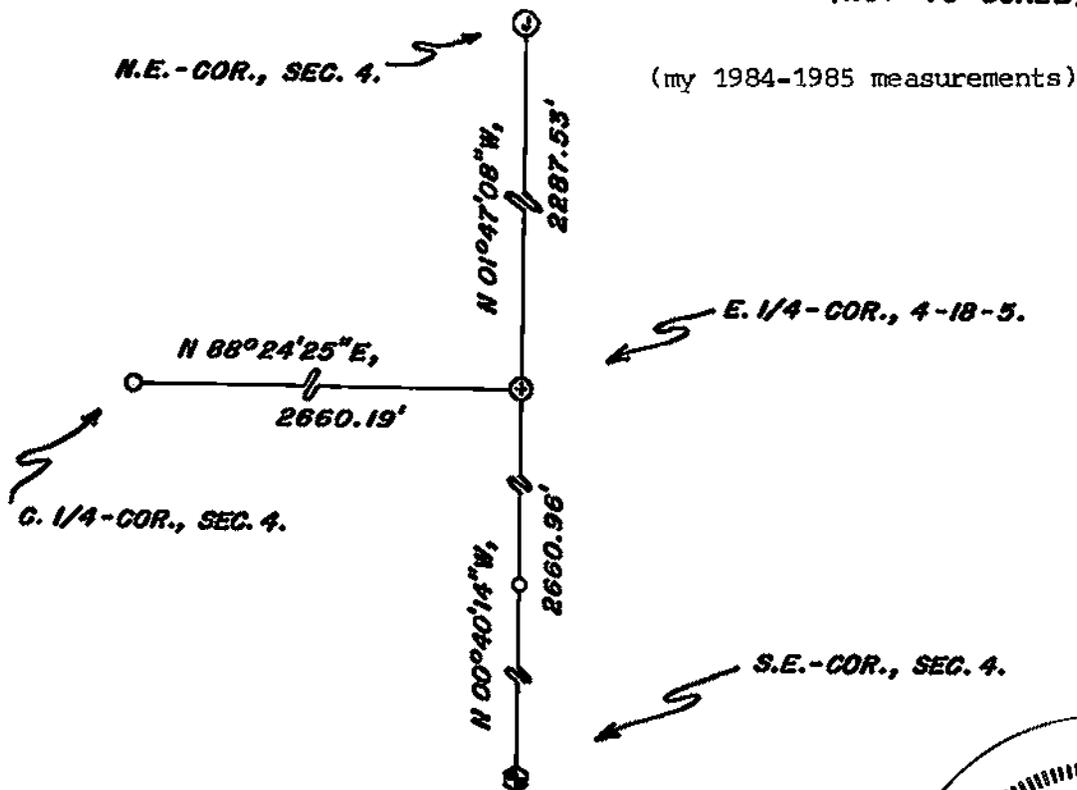

I, WILLIAM C. JUNG, COUNTY SURVEYOR
HEREBY CERTIFY THAT THE CORNER LOCATION SHOWN ON THIS RECORD WAS DETERMINED BY ME OR UNDER MY DIRECTION AND CONTROL AND THAT THIS U. S. PUBLIC LAND SURVEY MONUMENT RECORD IS CORRECT AND COMPLETE TO THE BEST OF MY KNOWLEDGE AND BELIEF.

William C. Jung
Signature

3/14/06
Date




Seal

U. S. PUBLIC LAND SURVEY MONUMENT RECORD

SECTION 4 T 18 N, R 5 W, TOWN OF FARMINGTON

LA CROSSE COUNTY

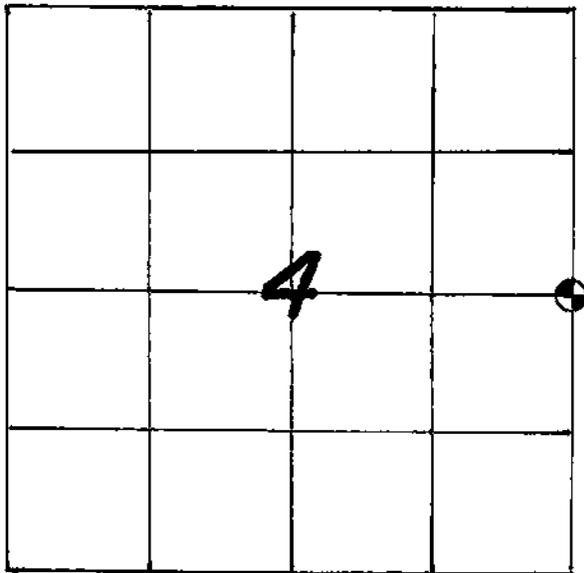

LOCATION OF LANDMARK

| |
|------------------------------------|
| WISCONSIN COORDINATE SYSTEM |
| North |
| East |
| Theta Angle |
| Horiz. Order |
| Vert. Order |
| TYPE OF LANDMARK |
| 1 1/2" IRON PIPE |
| BEARINGS ARE REFERENCED TO ASSUMED |

DATE: 1-22-85
 CREW: BILL JUNG
 MIKE WEIBEL

Describe any record evidence, monument evidence, testimonial evidence or any other material evidence you considered and whether the monument was found or restored through acceptance of an obliterated evidence location.


I set an iron pipe at the corner after surveying out Section 4 and computing a location that best fits the overall field evidence.

Describe or show any material discrepancy between the location of the restored corner and that of the corner previously restored or reestablished.

I found an iron pipe S38-32-28W, 10.93 feet from the corner, which I disagree with. There is also another fence 7 feet to the West.

RECORD OF DURABLE WITNESS MONUMENTS


| NO | DESCRIPTION | BEARING | DISTANCE |
|----|---|--------------------|----------|
| 1 | 3/4" IRON PIPE (flush) | S38°32'28"W = Ass. | 10.93' |
| 2 | P.K. NAIL IN 7" DOUBLE BLAZED OAK TREE (ex. blaze) | S10°E = Mag. | 6.85' |
| 3 | P.K. NAIL IN 7' SINGLE BLAZED NORWAY PINE | S66°E = Mag. | 41.37' |
| 4 | P.K. NAIL IN 7" DOUBLE BLAZED OAK TREE | N39°E = Mag. | 12.08' |

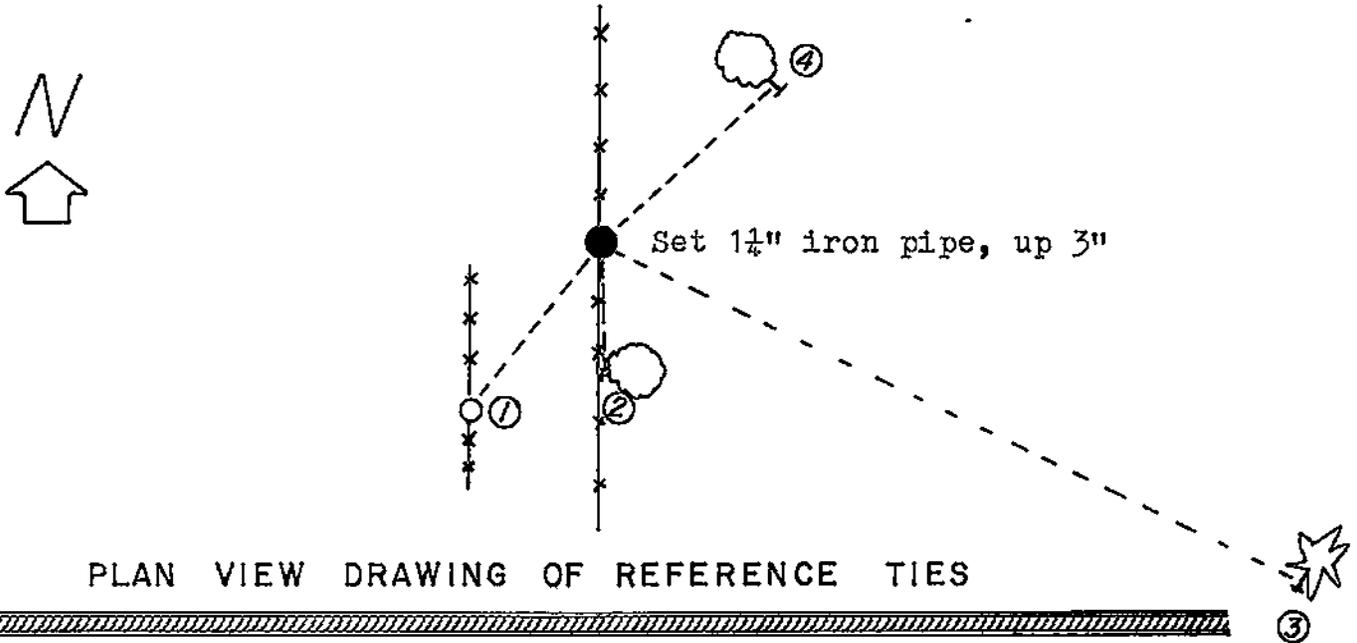

PLAN VIEW DRAWING OF REFERENCE TIES

MAP SHOWING DISTANCE AND DIRECTION TO OTHER PUBLIC LAND SURVEY CORNERS USED FOR REESTABLISHING THE CORNER


(not to scale)

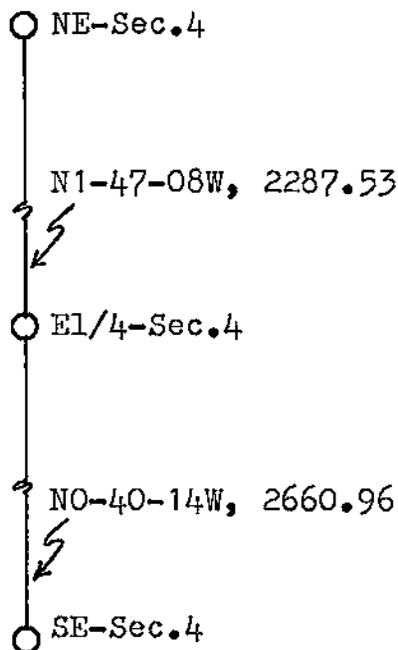

I, William C. Jung, Deputy County Surveyor,
 HEREBY CERTIFY THAT THE CORNER LOCATION SHOWN ON THIS RECORD
 WAS DETERMINED BY ME OR UNDER MY DIRECTION AND CONTROL AND
 THAT THIS U. S. PUBLIC LAND SURVEY MONUMENT RECORD IS CORRECT
 AND COMPLETE TO THE BEST OF MY KNOWLEDGE AND BELIEF.

William C. Jung
 Signature

3/7/86
 Date

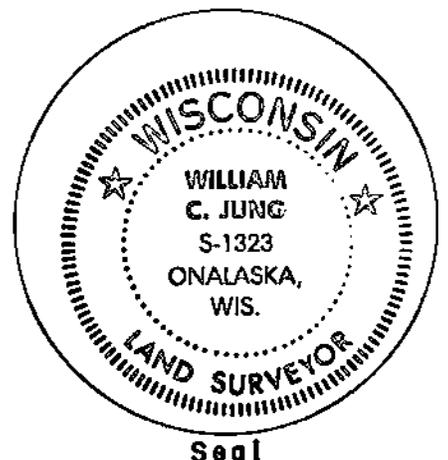

Seal