


21805042020

U. S. PUBLIC LAND SURVEY MONUMENT RECORD

SECTION 4 T 18 N, R 5 W, TOWN OF FARMINGTON

LA CROSSE COUNTY

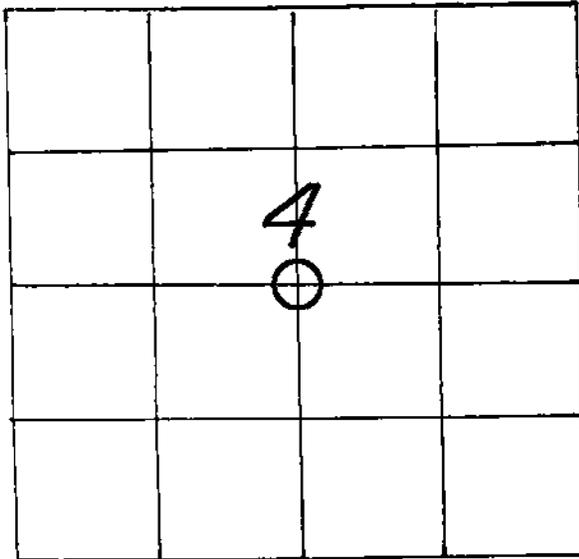

LOCATION OF LANDMARK

CREW: WILLIAM G. JUNG
 PETER F. FOLLANSBEE
 DATE: 3/22/2005

WISCONSIN COORDINATE SYSTEM

North

East

Theta Angle

Horiz. Order

Vert. Order

TYPE OF LANDMARK

1/4" IRON PIPE.

BEARINGS ARE REFERENCED TO
 ASSUMED NORTH AS PER SECTION DATA.

Describe any record evidence, monument evidence, testimonial evidence or any other material evidence you considered and whether the monument was found or restored through acceptance of an obliterated evidence location.


I found the pipe that I set back in 1985 and took new ties. (See my old tie sheet for corner history.)

Describe or show any material discrepancy between the location of the restored corner and that of the corner previously restored or reestablished.

(see my 1985 tie sheet)


RECORD OF DURABLE WITNESS MONUMENTS

NO	DESCRIPTION	MAGNETIC	
		BEARING	DISTANCE
1	EXISTING BURIED IRON PIPE WEST OF A FENCELINE	WEST ±	36.46 FT.
2	SET A NAIL IN N.E.-SIDE OF A 9" OAK	N 38° W	16.48 FT.
3	SET A NAIL IN N.W.-SIDE OF A 13" OAK	S 18° W	15.91 FT.
4	SET A NAIL IN N.W.-SIDE OF A 12" OAK	S 72° W	17.76 FT.

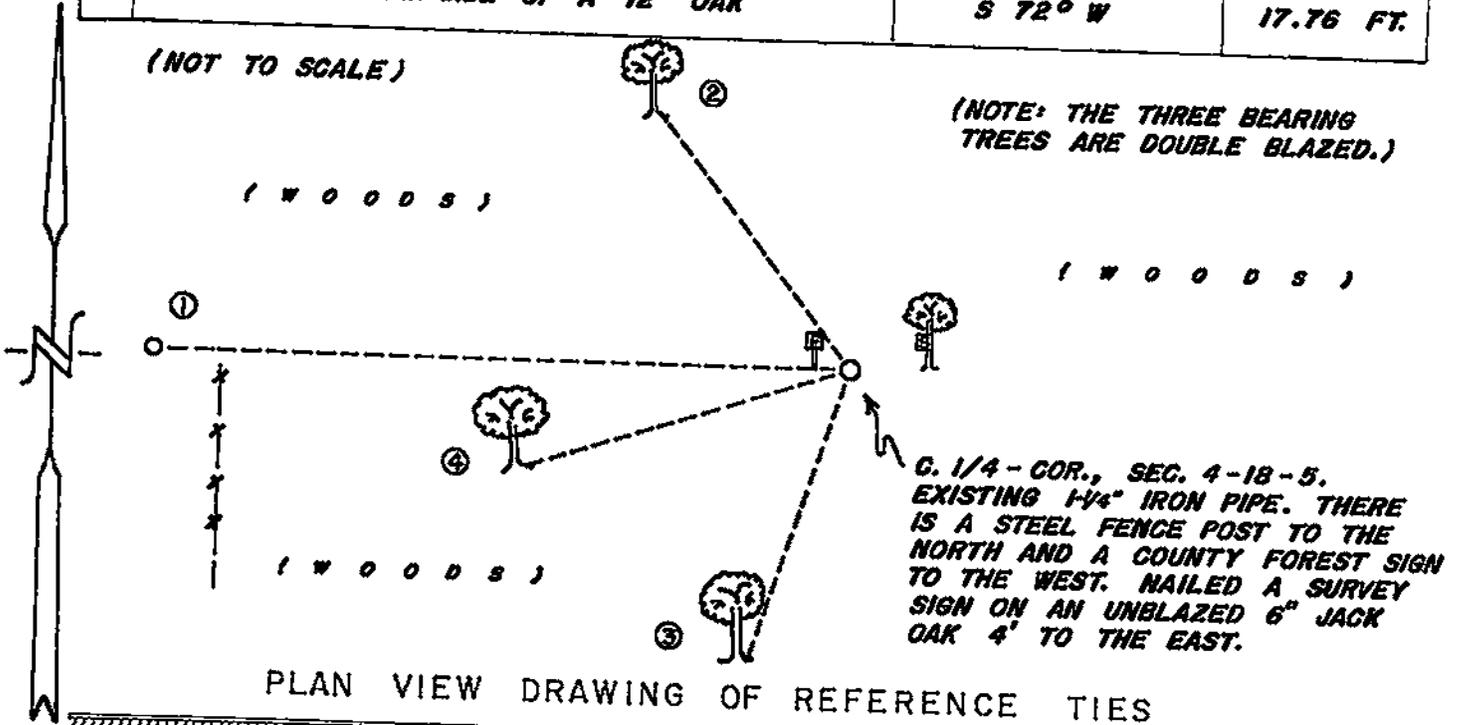

MAP SHOWING DISTANCE AND DIRECTION TO OTHER PUBLIC LAND SURVEY CORNERS USED FOR REESTABLISHING THE CORNER

(1984-1985) (W.C. JUNG MEASUREMENTS)
(ASSUMED BEARINGS)
(NOT TO SCALE)

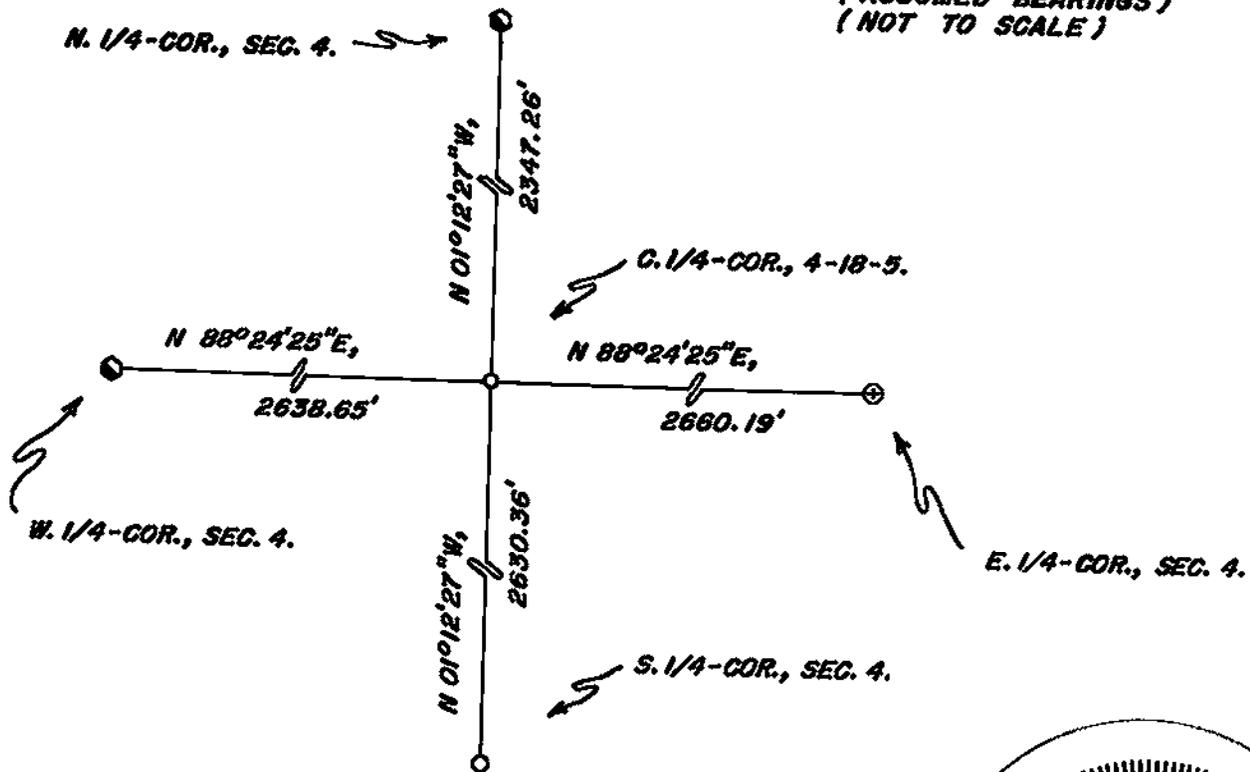

I, WILLIAM C. JUNG, COUNTY SURVEYOR
HEREBY CERTIFY THAT THE CORNER LOCATION SHOWN ON THIS RECORD WAS DETERMINED BY ME OR UNDER MY DIRECTION AND CONTROL AND THAT THIS U. S. PUBLIC LAND SURVEY MONUMENT RECORD IS CORRECT AND COMPLETE TO THE BEST OF MY KNOWLEDGE AND BELIEF.

William C Jung
Signature

3/14/06
Date




Seal

U. S. PUBLIC LAND SURVEY MONUMENT RECORD

SECTION 4 T 18 N, R 5 W, TOWN OF FARMINGTON

LA CROSSE COUNTY

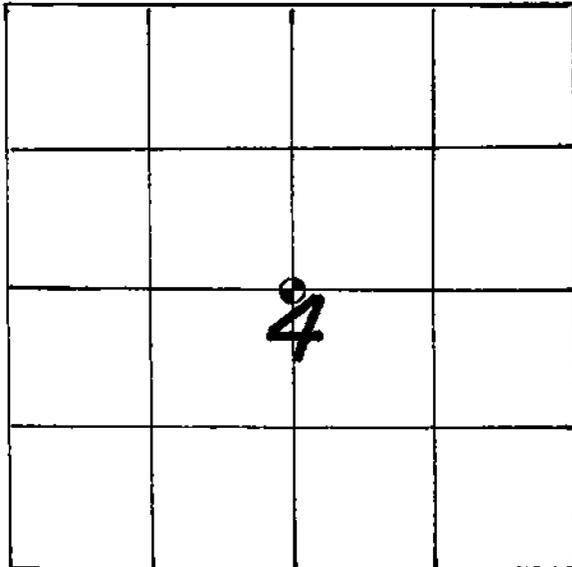

LOCATION OF LANDMARK

DATE: 1-17-85
 CREW: BILL JUNG
 MIKE WEIBEL

WISCONSIN COORDINATE SYSTEM
North
East
Theta Angle
Horiz. Order
Vert. Order
TYPE OF LANDMARK
1 1/2" IRON PIPE
BEARINGS ARE REFERENCED TO ASSUMED

Describe any record evidence, monument evidence, testimonial evidence or any other material evidence you considered and whether the monument was found or restored through acceptance of an obliterated evidence location.

I set an iron pipe at the True Center 1/4" as per law".


Describe or show any material discrepancy between the location of the restored corner and that of the corner previously restored or reestablished.

There is an existing iron pipe 36.61 feet to the West which I do not agree with. The fence is also 33 feet to the West.

RECORD OF DURABLE WITNESS MONUMENTS


MAGNETIC

NO	DESCRIPTION	BEARING	DISTANCE
1	P.K. NAIL IN DOUBLE BLAZED 6" OAK TREE	N40°W	16.43'
2	IRON PIPE (existing)	S86.5°W	36.61'
3	P.K. NAIL IN DOUBLE BLAZED 9" OAK TREE	S13°W	15.97'
4			

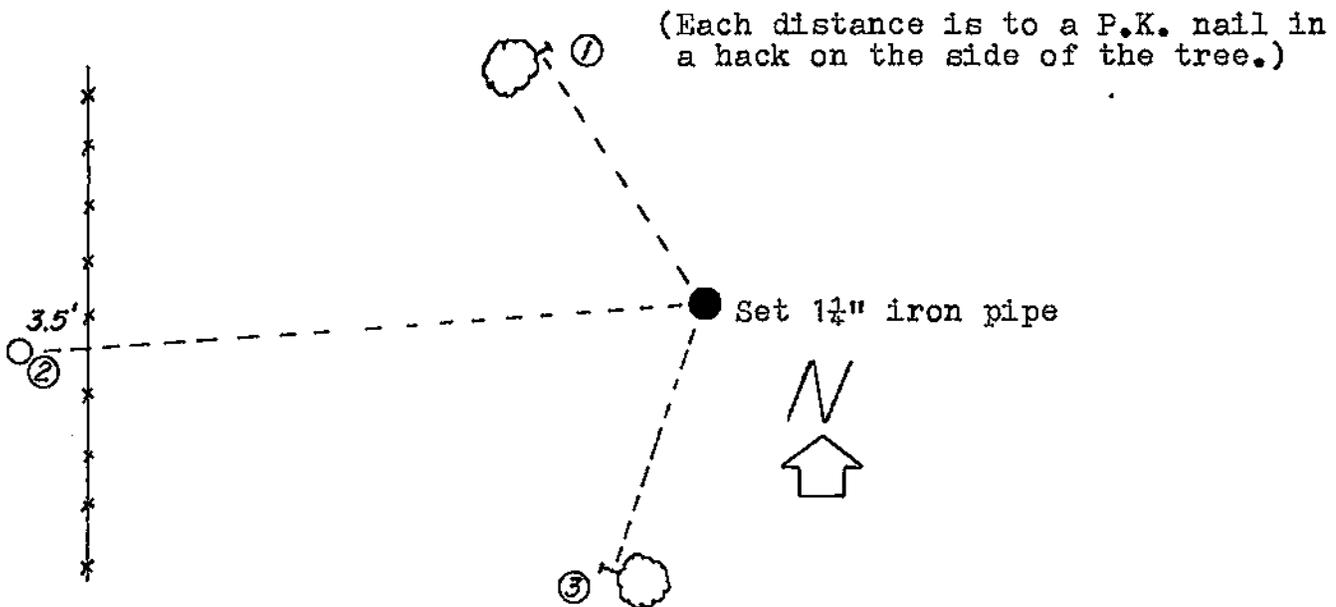

PLAN VIEW DRAWING OF REFERENCE TIES


MAP SHOWING DISTANCE AND DIRECTION TO OTHER PUBLIC LAND SURVEY CORNERS USED FOR REESTABLISHING THE CORNER

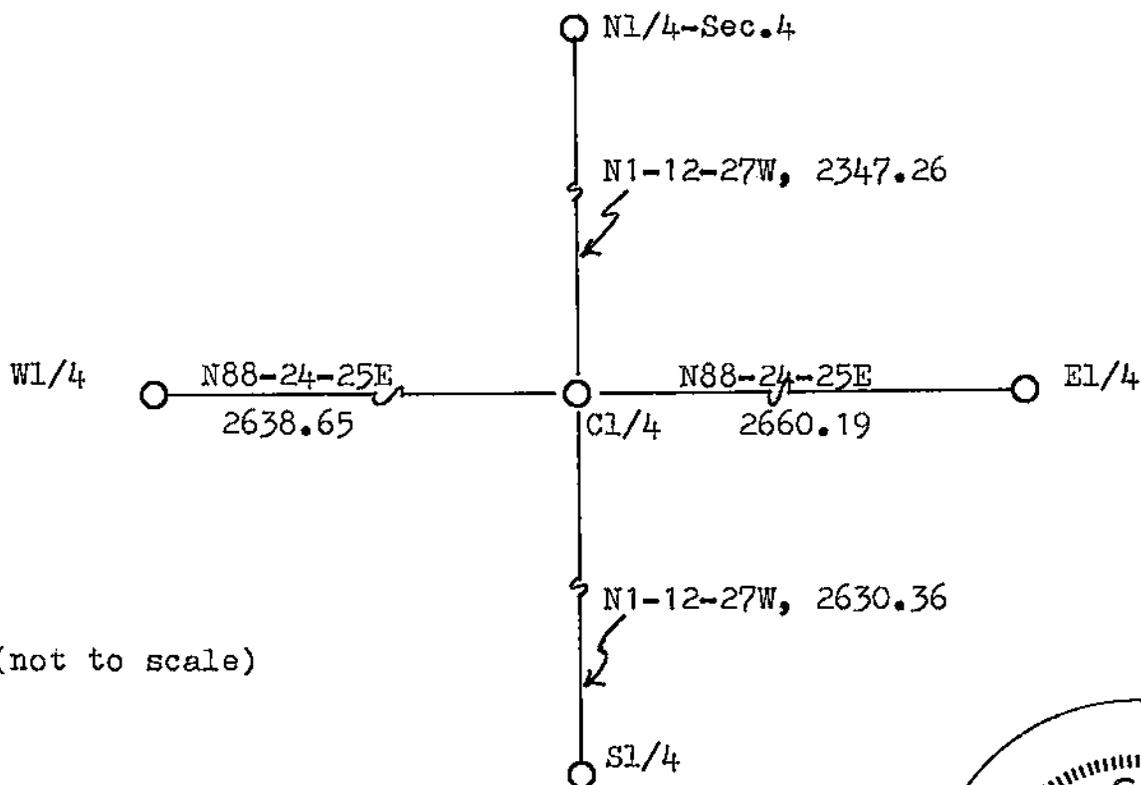

(not to scale)

I, William C. Jung, Deputy County Surveyor,
 HEREBY CERTIFY THAT THE CORNER LOCATION SHOWN ON THIS RECORD
 WAS DETERMINED BY ME OR UNDER MY DIRECTION AND CONTROL AND
 THAT THIS U. S. PUBLIC LAND SURVEY MONUMENT RECORD IS CORRECT
 AND COMPLETE TO THE BEST OF MY KNOWLEDGE AND BELIEF.

William C. Jung 3/7/86
 Signature Date

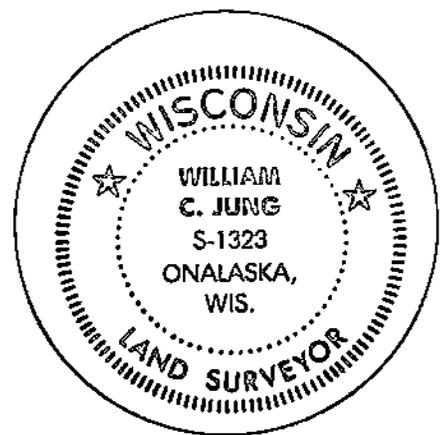

Seal